

serving rooms or spaces with an occupant load of 50 or more

in a Group A occupancy shall not be provided with a latch or lock other than panic hardware or fire exit hardware.

P1 WALL TYPE P1 NOT TO SCALE

 $P2_{\frac{\text{WALL TYPE P2}}{\text{NOT TO SCALE}}}$ 

ANYWHERE. UNDERSIDES OF COUNTERTOPS, INSIDE OF CABINETRY, AND

WATER HEATER PLATFORMS MUST BE SEALED.

LOCKABLE DRAIN PLUGS, AND AN INDIRECT CONNECTION TO THE SEWER.

**WEI TAN** 2425 S WENTWORTH AVE CHICAGO IL 60616

Phone: (312) 912-5798 Email: twarchitect98@yahoo.com LICENSE NO: 001-022013

MEP ENGINEER 236 W ALEXANDER STREET CHICAGO IL 60616

PHONE: (312)720-8800 BILLY WANG68@HOTMAIL.COM LICENSE NO: 062.068227


EXPIRES: 11 / 30 /2023

EXPIRES: 11/30/2022

SSUED FOR PERMIT



FLOOR PLANS & NOTES

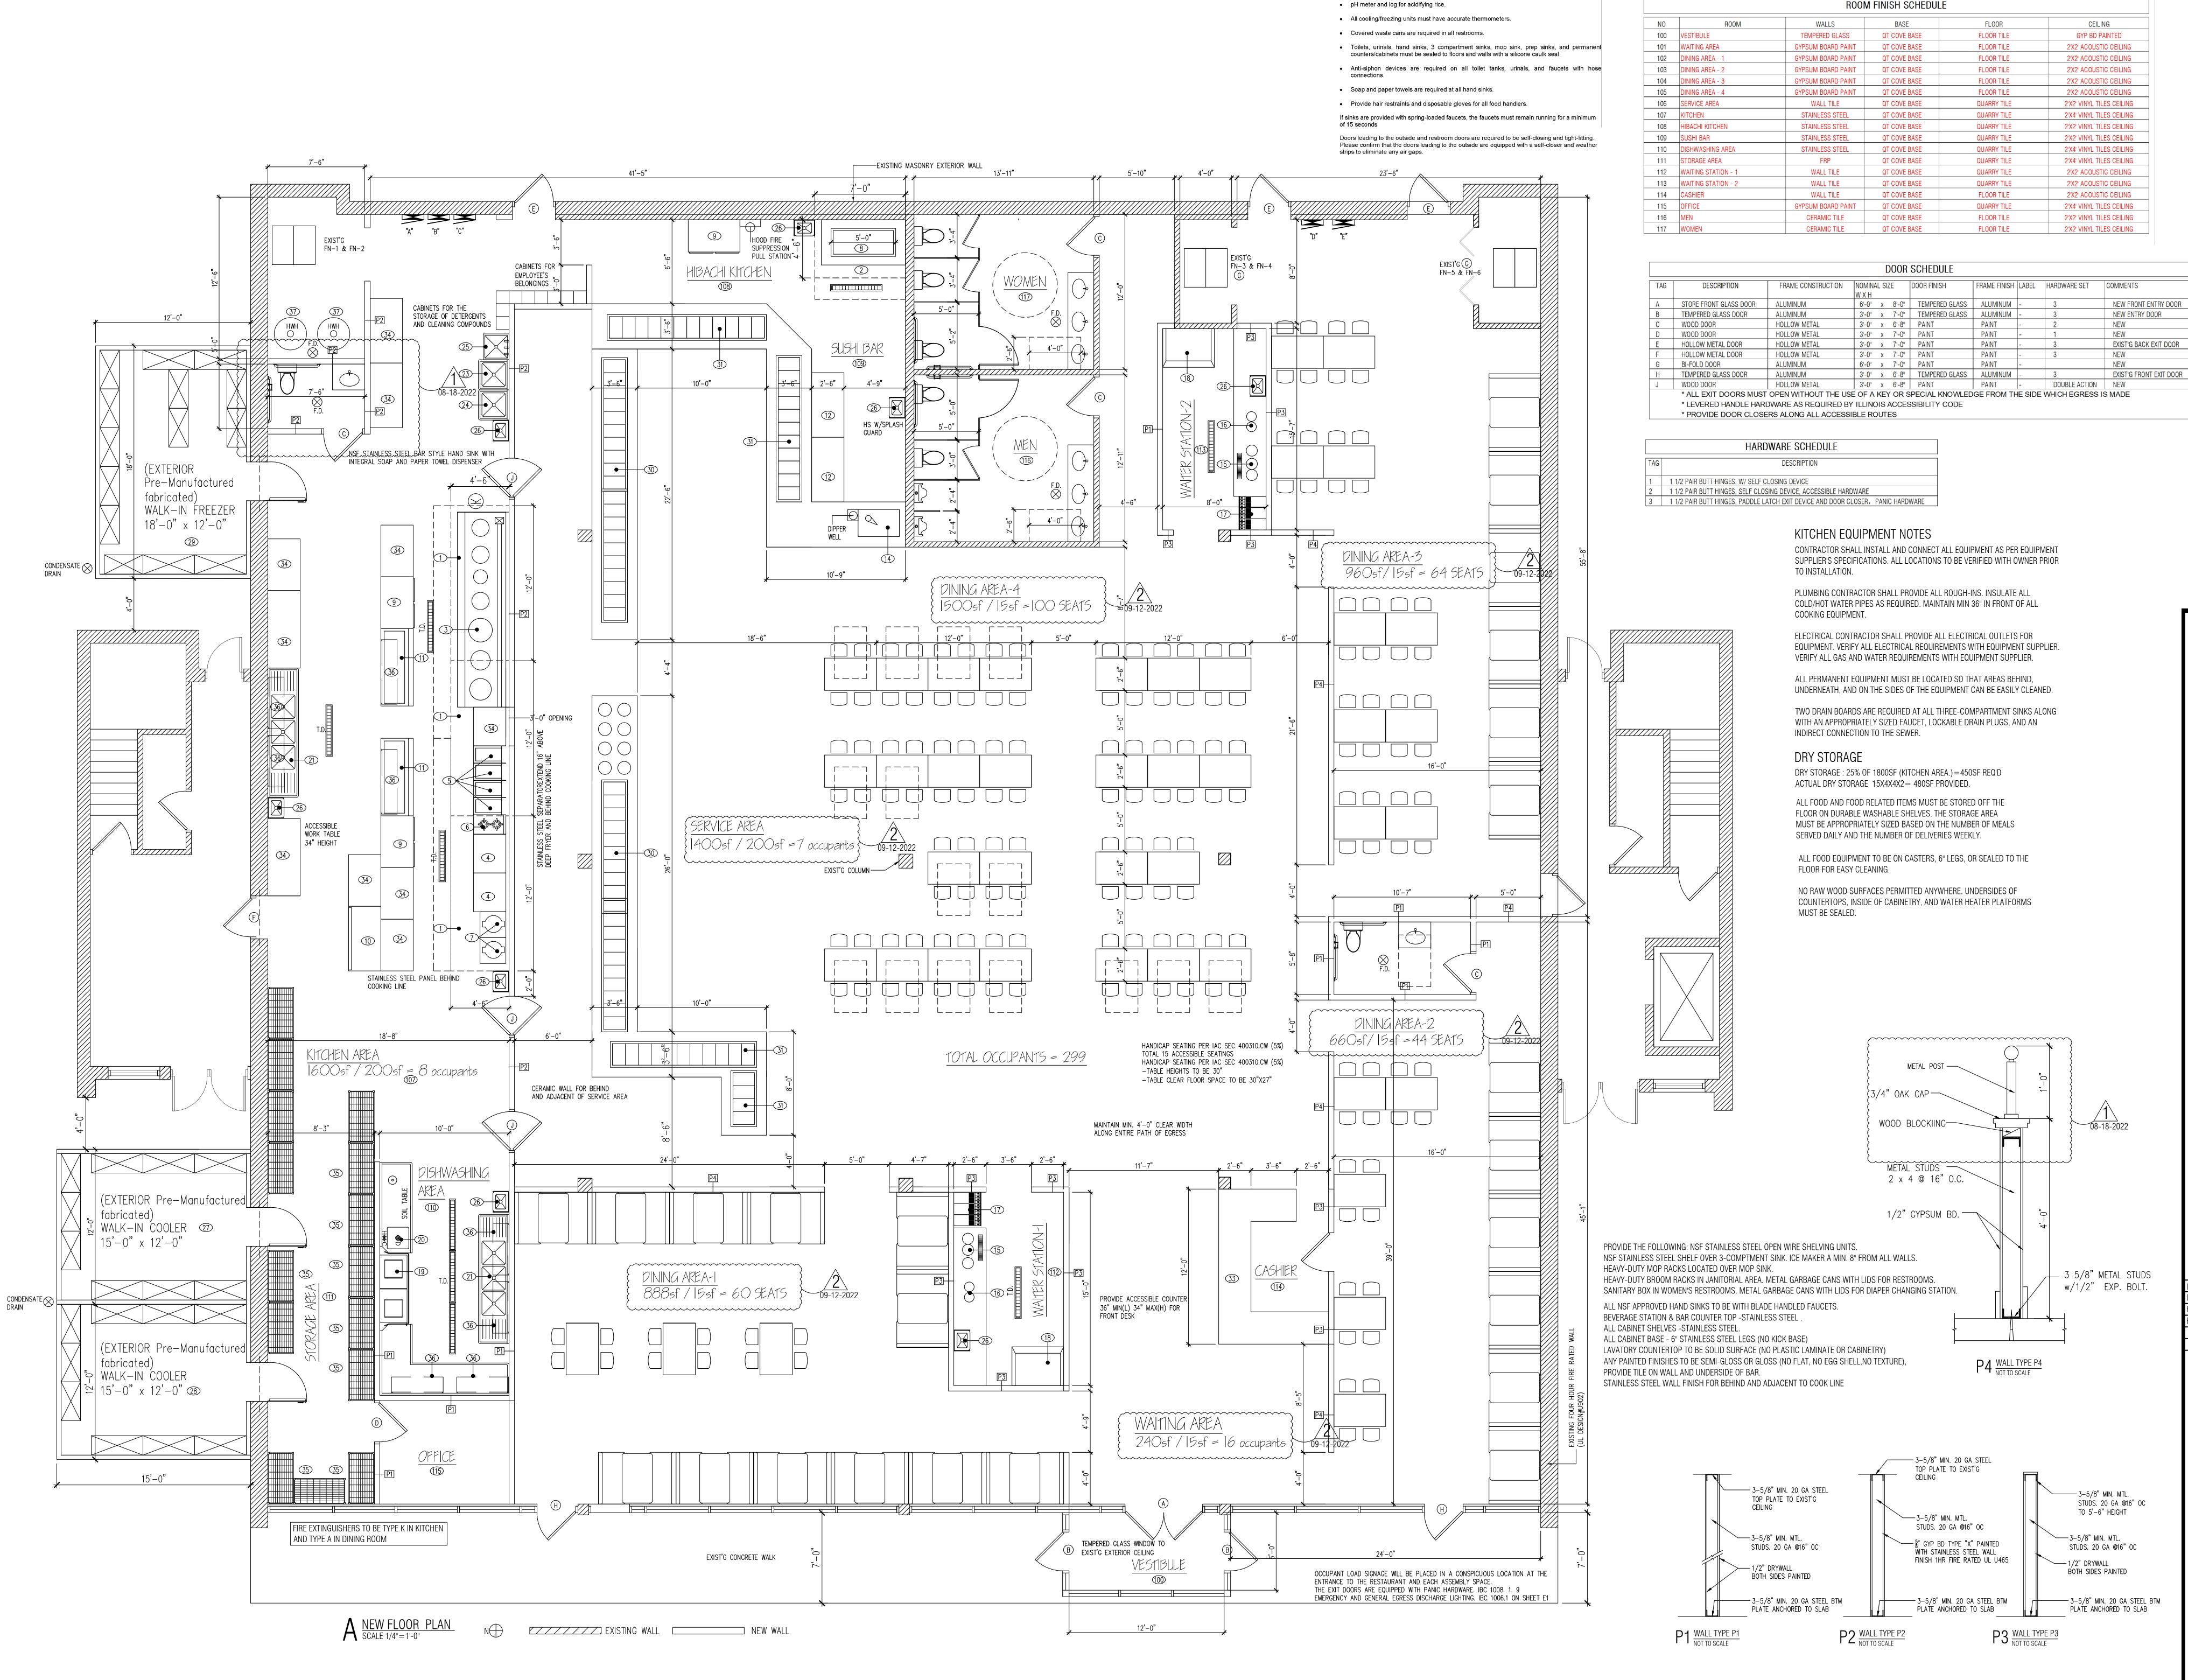

Dial stem thermometers (ranging from 0° to 220°F) are required in all preparation areas.
 Chemical test kits (specific to the sanitizer) are required for the appropriate sanitizer.

WEI TAN 2425 S WENTWORTH AVE

CHICAGO IL 60616

Phone: (312) 912-5798
Email: twarchitect98@yahoo.com

LICENSE NO: 001-022013
EXPIRES: 11/30/2022

MEP ENGINEER 236 W ALEXANDER STREET CHICAGO IL 60616

PHONE: (312)720-8800
BILLY\_WANG68@HOTMAIL.COM
LICENSE NO: 062.068227
EXPIRES: 11 / 30 /2023

LICENSE NO: 062.068227 EXPIRES: 11 / 30 /2023

FEAST BUFFET


KTERIOR & INTERIOR REMODELIN

4232 N BRANDYWINE DRIVE PEORIA ILLINOIS 61614

SUES
SUED FOR PERMIT
06/28/2022
ISSUED FOR PERMIT
08/18/2022
ISSUED FOR PERMIT
09/05/2022



FLOOR PLANS & NOTES

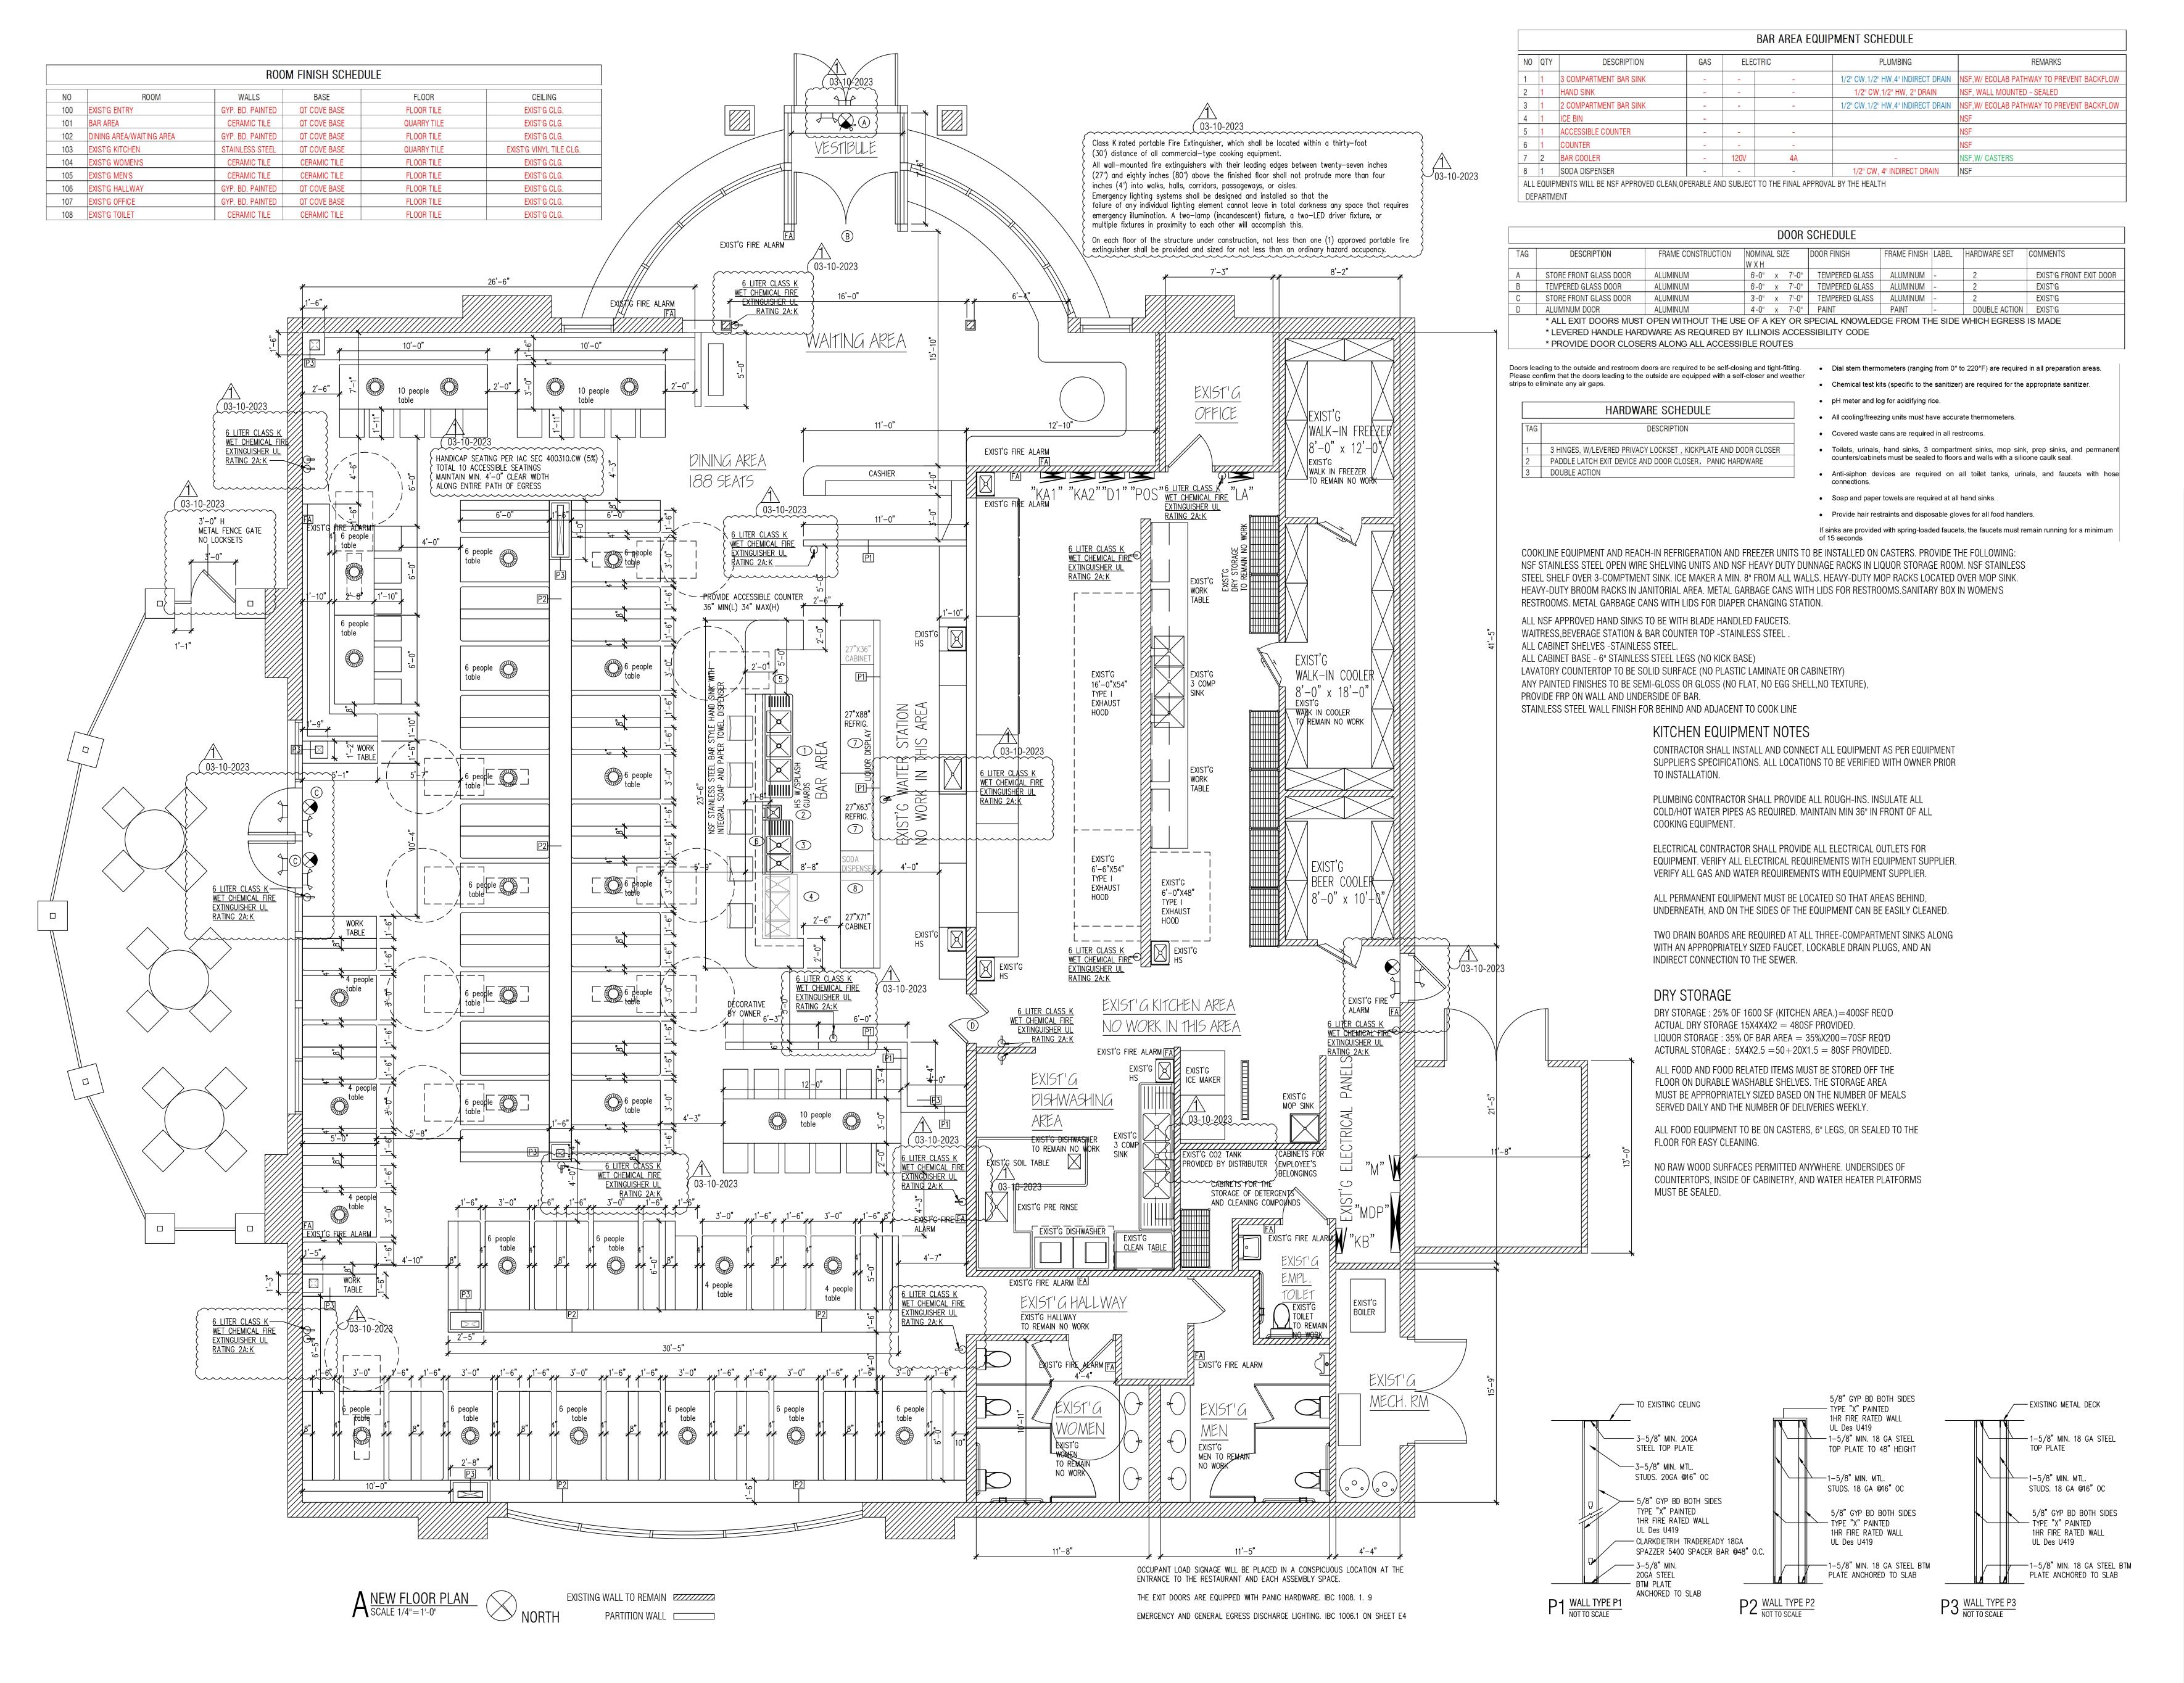

WEI TAN 2425 S WENTWORTH AVE CHICAGO IL 60616

Phone: (312) 912-5798
Email: twarchitect98@yahoo.com

MEP ENGINEER
236 W ALEXANDER STREET

LICENSE NO: 001-022013

EXPIRES: 11/30/2024

CHICAGO IL 60616

PHONE: (312)720-8800

BILLY\_WANG68@HOTMAIL.COM
LICENSE NO: 062.068227


EXPIRES: 11 / 30 /2023

WK BBQ STEAKHOUSE
TERIOR REMODELING
PARKWAY DRIVE LINCOLNSHIRE II 60069

ISSUES DATE
ISSUED FOR PERMIT 12/18/20
REISSUED FOR PERMIT 03/10/20



FLOOR PLAN, NOTES, & SCHEDULES

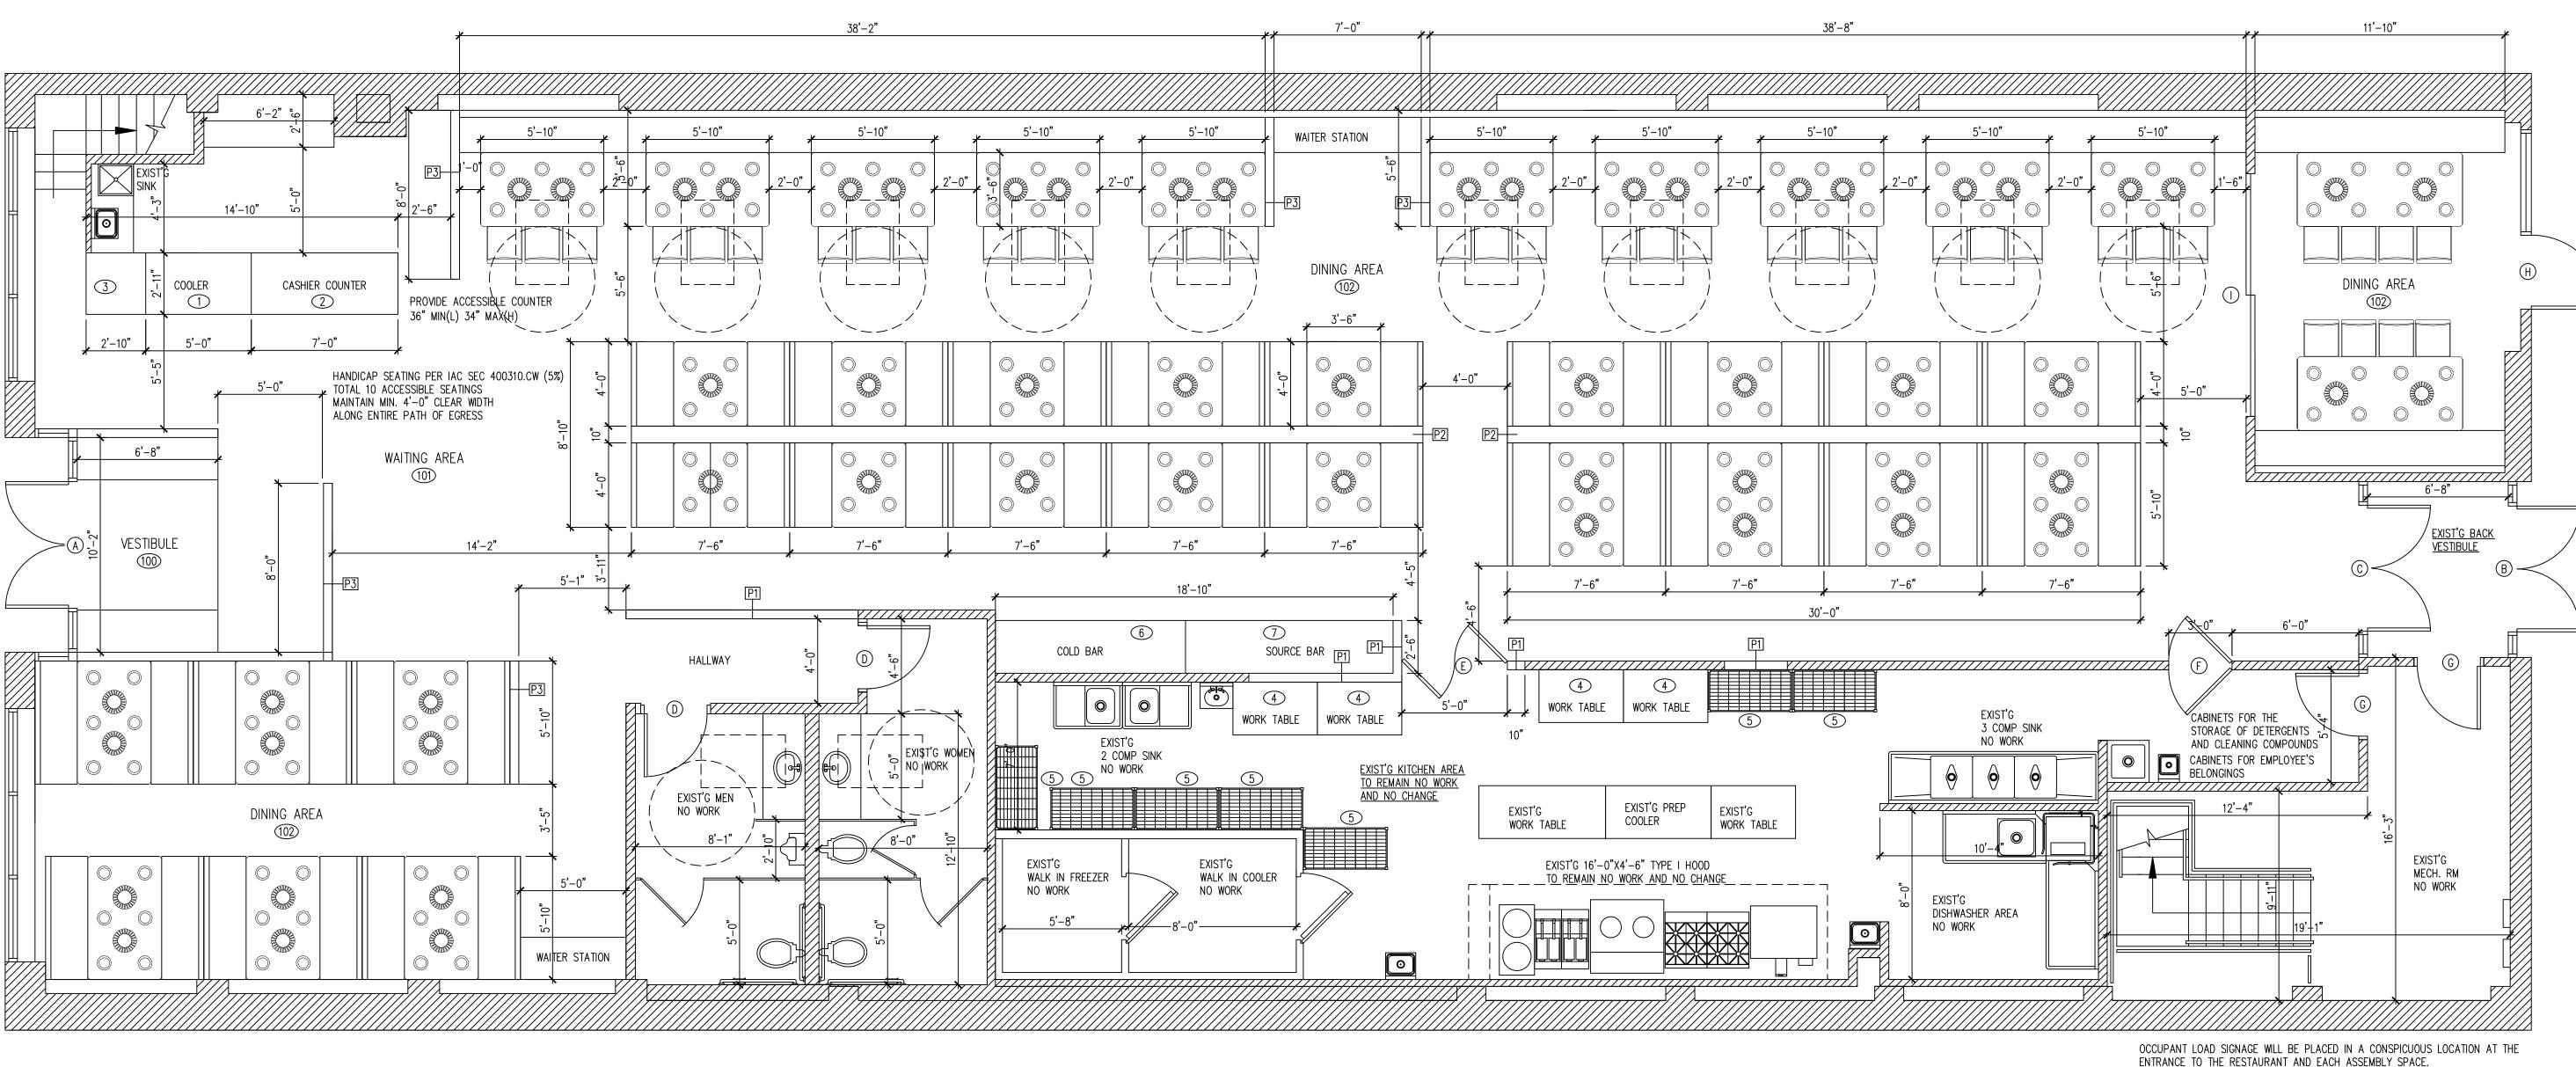

NEW FLOOR PLAN
SCALE 1/4"=1'-0"

BAR AREA EQUIPMENT SCHEDULE								
NO	QTY	DESCRIPTION	GAS	ELEC	CTRIC	PLUMBING	REMARKS	
1	1	COOLER	-	120V	4A	-	NSF,W/ CASTERS	
2	1	CASHIER COUNTER	-	-	-		NSF	
3	1	EXIST'G HAND SINK	_	_	·	1/2" CW,1/2" HW, 2" DRAIN	NSF, WALL MOUNTED - SEALED	
4	4	STAINLESS STEEL WORK TABLE	_	=			NSF	
5	7	STAINLESS STEEL SHELVING	-	_	_		NSF	
ALL EQUIPMENTS WILL BE NSF APPROVED CLEAN, OPERABLE AND SUBJECT TO THE FINAL APPROVAL BY THE HEALTH								
DEPARTMENT								

ROOM FINISH SCHEDULE							
NO	ROOM	WALLS	BASE	FLOOR	CEILING		
100	VESTIBULE	GYP. BD. PAINTED	QT COVE BASE	FLOOR TILE	EXIST'G CLG.		
101	WAITING AREA	GYP. BD. PAINTED	QT COVE BASE	FLOOR TILE	EXIST'G OPEN CLG.		
102	DINING AREA	GYP. BD. PAINTED	QT COVE BASE	FLOOR TILE	EXIST'G OPEN CLG.		

	DOOR SCHEDULE									
TAG	DESCRIPTION	FRAME CONSTRUCTION	NOMINA W X H	L SIZ	ZE	DOOR FINISH	FRAME FINISH	LABEL	HARDWARE SET	COMMENTS
Α	STORE FRONT GLASS DOOR	ALUMINUM	6'-0"	X	7'-0"	TEMPERED GLASS	ALUMINUM	-	2	EXIST'G FRONT EXIT DOOR
В	STORE BACK GLASS DOOR	ALUMINUM	6'-0"	Χ	7'-0"	TEMPERED GLASS	ALUMINUM	-	2	EXIST'G BACK EXIT DOOR
C	TEMPERED GLASS DOOR	ALUMINUM	6'-0"	X	7'-0"	TEMPERED GLASS	ALUMINUM	-	2	EXIST'G
D	SOLID WOOD DOOR	HOLLOW METAL	3'-0"	Χ	6'-8"	PAINT	PAINT	-	1	EXIST'G
Е	DOUBLE SWINGING DOOR	ALUMINUM	5'-0"	X	6'-8"	PAINT	PAINT	-	DOUBLE ACTION	NEW
F	SINGLE SWINGING DOOR	ALUMINUM	3'-0"	Χ	6'-8"	PAINT	PAINT		DOUBLE ACTION	NEW
G	HOLLOW METAL DOOR	HOLLOW METAL	3'-0"	Χ	6'-8"	PAINT	PAINT	-1	3	EXIST'G
Н	STOER BACK GLASS DOOR	ALUMINUM	3'-6"	Χ	6'-8"	TEMPERED GLASS	ALUMINUM	-1	2	EXIST'G
1	SLIDING DOOR	ALUMINUM	10'-0"	X	6'-8"	TEMPERED GLASS	ALUMINUM			EXIST'G
	* ALL EXIT DOORS MUST OPEN WITHOUT THE USE OF A KEY OR SPECIAL KNOWLEDGE FROM THE SIDE WHICH EGRESS IS MADE									
	* LEVERED HANDLE HARDWARE AS REQUIRED BY ILLINOIS ACCESSIBILITY CODE									
	* PROVIDE DOOR CLOSE	RS ALONG ALL ACCESSI	BLE RC	UTI	ES					

Doors leading to the outside and restroom doors are required to be self-closing and tight-fitting. Please confirm that the doors leading to the outside are equipped with a self-closer and weather strips to eliminate any air gaps.

HARDWARE SCHEDULE							
TAG	DESCRIPTION						
1	3 HINGES, W/LEVERED PRIVACY LOCKSET, KICKPLATE AND DOOR CLOSER						
2	PADDLE LATCH EXIT DEVICE AND DOOR CLOSER, PANIC HARDWARE						
3	PRIVACY LOCKET						

#### KITCHEN EQUIPMENT NOTES

CONTRACTOR SHALL INSTALL AND CONNECT ALL EQUIPMENT AS PER EQUIPMENT SUPPLIER'S SPECIFICATIONS. ALL LOCATIONS TO BE VERIFIED WITH OWNER PRIOR TO INSTALLATION.

PLUMBING CONTRACTOR SHALL PROVIDE ALL ROUGH-INS. INSULATE ALL COLD/HOT WATER PIPES AS REQUIRED. MAINTAIN MIN 36" IN FRONT OF ALL COOKING EQUIPMENT.

ELECTRICAL CONTRACTOR SHALL PROVIDE ALL ELECTRICAL OUTLETS FOR EQUIPMENT. VERIFY ALL ELECTRICAL REQUIREMENTS WITH EQUIPMENT SUPPLIER. VERIFY ALL GAS AND WATER REQUIREMENTS WITH EQUIPMENT SUPPLIER.

ALL PERMANENT EQUIPMENT MUST BE LOCATED SO THAT AREAS BEHIND, UNDERNEATH, AND ON THE SIDES OF THE EQUIPMENT CAN BE EASILY CLEANED.

TWO DRAIN BOARDS ARE REQUIRED AT ALL THREE-COMPARTMENT SINKS ALONG WITH AN APPROPRIATELY SIZED FAUCET, LOCKABLE DRAIN PLUGS, AND AN INDIRECT CONNECTION TO THE SEWER.

- Dial stem thermometers (ranging from 0° to 220°F) are required in all preparation areas.
- Chemical test kits (specific to the sanitizer) are required for the appropriate sanitizer.
- pH meter and log for acidifying rice.
- All cooling/freezing units must have accurate thermometers.
- Covered waste cans are required in all restrooms.
- Toilets, urinals, hand sinks, 3 compartment sinks, mop sink, prep sinks, and permanent counters/cabinets must be sealed to floors and walls with a silicone caulk seal.
- Anti-siphon devices are required on all toilet tanks, urinals, and faucets with hose connections.
- Soap and paper towels are required at all hand sinks.
- Provide hair restraints and disposable gloves for all food handlers.

If sinks are provided with spring-loaded faucets, the faucets must remain running for a minimum of 15 seconds

#### DRY STORAGE

DRY STORAGE : 25% OF 800 SF (KITCHEN AREA.) = 200SF REQ'D ACTUAL DRY STORAGE 7X4X4X2 = 224SF PROVIDED.

ALL FOOD AND FOOD RELATED ITEMS MUST BE STORED OFF THE FLOOR ON DURABLE WASHABLE SHELVES. THE STORAGE AREA MUST BE APPROPRIATELY SIZED BASED ON THE NUMBER OF MEALS SERVED DAILY AND THE NUMBER OF DELIVERIES WEEKLY.

ALL FOOD EQUIPMENT TO BE ON CASTERS, 6" LEGS, OR SEALED TO THE FLOOR FOR EASY CLEANING.

NO RAW WOOD SURFACES PERMITTED ANYWHERE. UNDERSIDES OF COUNTERTOPS, INSIDE OF CABINETRY, AND WATER HEATER PLATFORMS MUST BE SEALED.

THE EXIT DOORS ARE EQUIPPED WITH PANIC HARDWARE. IBC 1008. 1. 9

EMERGENCY AND GENERAL EGRESS DISCHARGE LIGHTING. IBC 1006.1 ON SHEET E2

Class K rated portable Fire Extinguisher, which shall be located within a thirty—foot (30') distance of all commercial—type cooking equipment.

All wall—mounted fire extinguishers with their leading edges between twenty—seven inches

(27") and eighty inches (80") above the finished floor shall not protrude more than four inches (4") into walks, halls, corridors, passageways, or aisles.

Emergency lighting systems shall be designed and installed so that the failure of any individual lighting element cannot leave in total darkness any space that requires emergency illumination. A two—lamp (incandescent) fixture, a two—LED driver fixture, or multiple fixtures in proximity to each other will accomplish this.

On each floor of the structure under construction, not less than one (1) approved portable fire extinguisher shall be provided and sized for not less than an ordinary hazard occupancy.

COOKLINE EQUIPMENT AND REACH-IN REFRIGERATION AND FREEZER UNITS TO BE INSTALLED ON CASTERS. PROVIDE THE FOLLOWING: NSF STAINLESS STEEL SHELF OVER 3-COMPTMENT SINK. HEAVY-DUTY MOP RACKS LOCATED OVER MOP SINK. HEAVY-DUTY BROOM RACKS IN JANITORIAL AREA. METAL GARBAGE CANS WITH LIDS FOR RESTROOMS. SANITARY BOX IN WOMEN'S RESTROOMS. METAL GARBAGE CANS WITH LIDS FOR DIAPER CHANGING STATION.


ALL NSF APPROVED HAND SINKS TO BE WITH BLADE HANDLED FAUCETS. WAITRESS, BEVERAGE STATION & BAR COUNTER TOP -STAINLESS STEEL.

ALL CABINET SHELVES -STAINLESS STEEL.

ALL CABINET BASE - 6" STAINLESS STEEL LEGS (NO KICK BASE)

LAVATORY COUNTERTOP TO BE SOLID SURFACE (NO PLASTIC LAMINATE OR CABINETRY)

ANY PAINTED FINISHES TO BE SEMI-GLOSS OR GLOSS (NO FLAT, NO EGG SHELL,NO TEXTURE) STAINLESS STEEL WALL FINISH FOR BEHIND AND ADJACENT TO COOK LINE

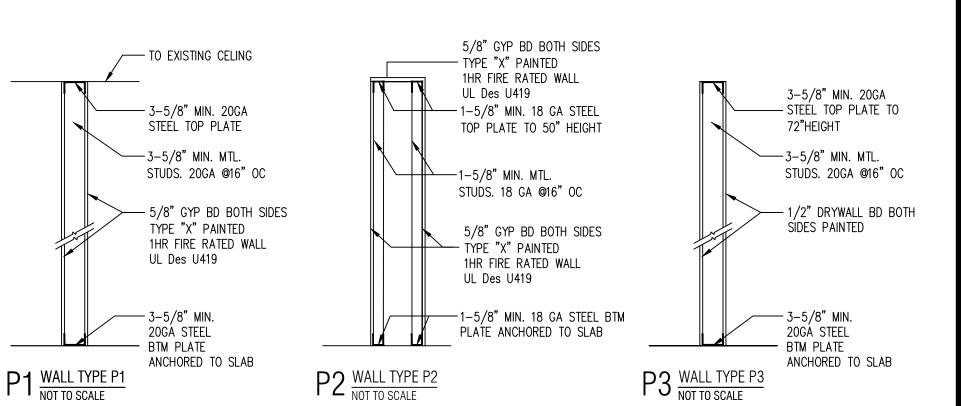

WEI TAN 2425 S WENTWORTH AVE CHICAGO IL 60616


Phone: (312) 912-5798 Email: twarchitect98@yahoo.com

LICENSE NO: 001-022013 EXPIRES: 11/30/2024

INTERIOR REMODELING

SSUES DATE
SSUED FOR PERMIT 04/08/2023


FLOOR PLAN, NOTES, & SCHEDULES

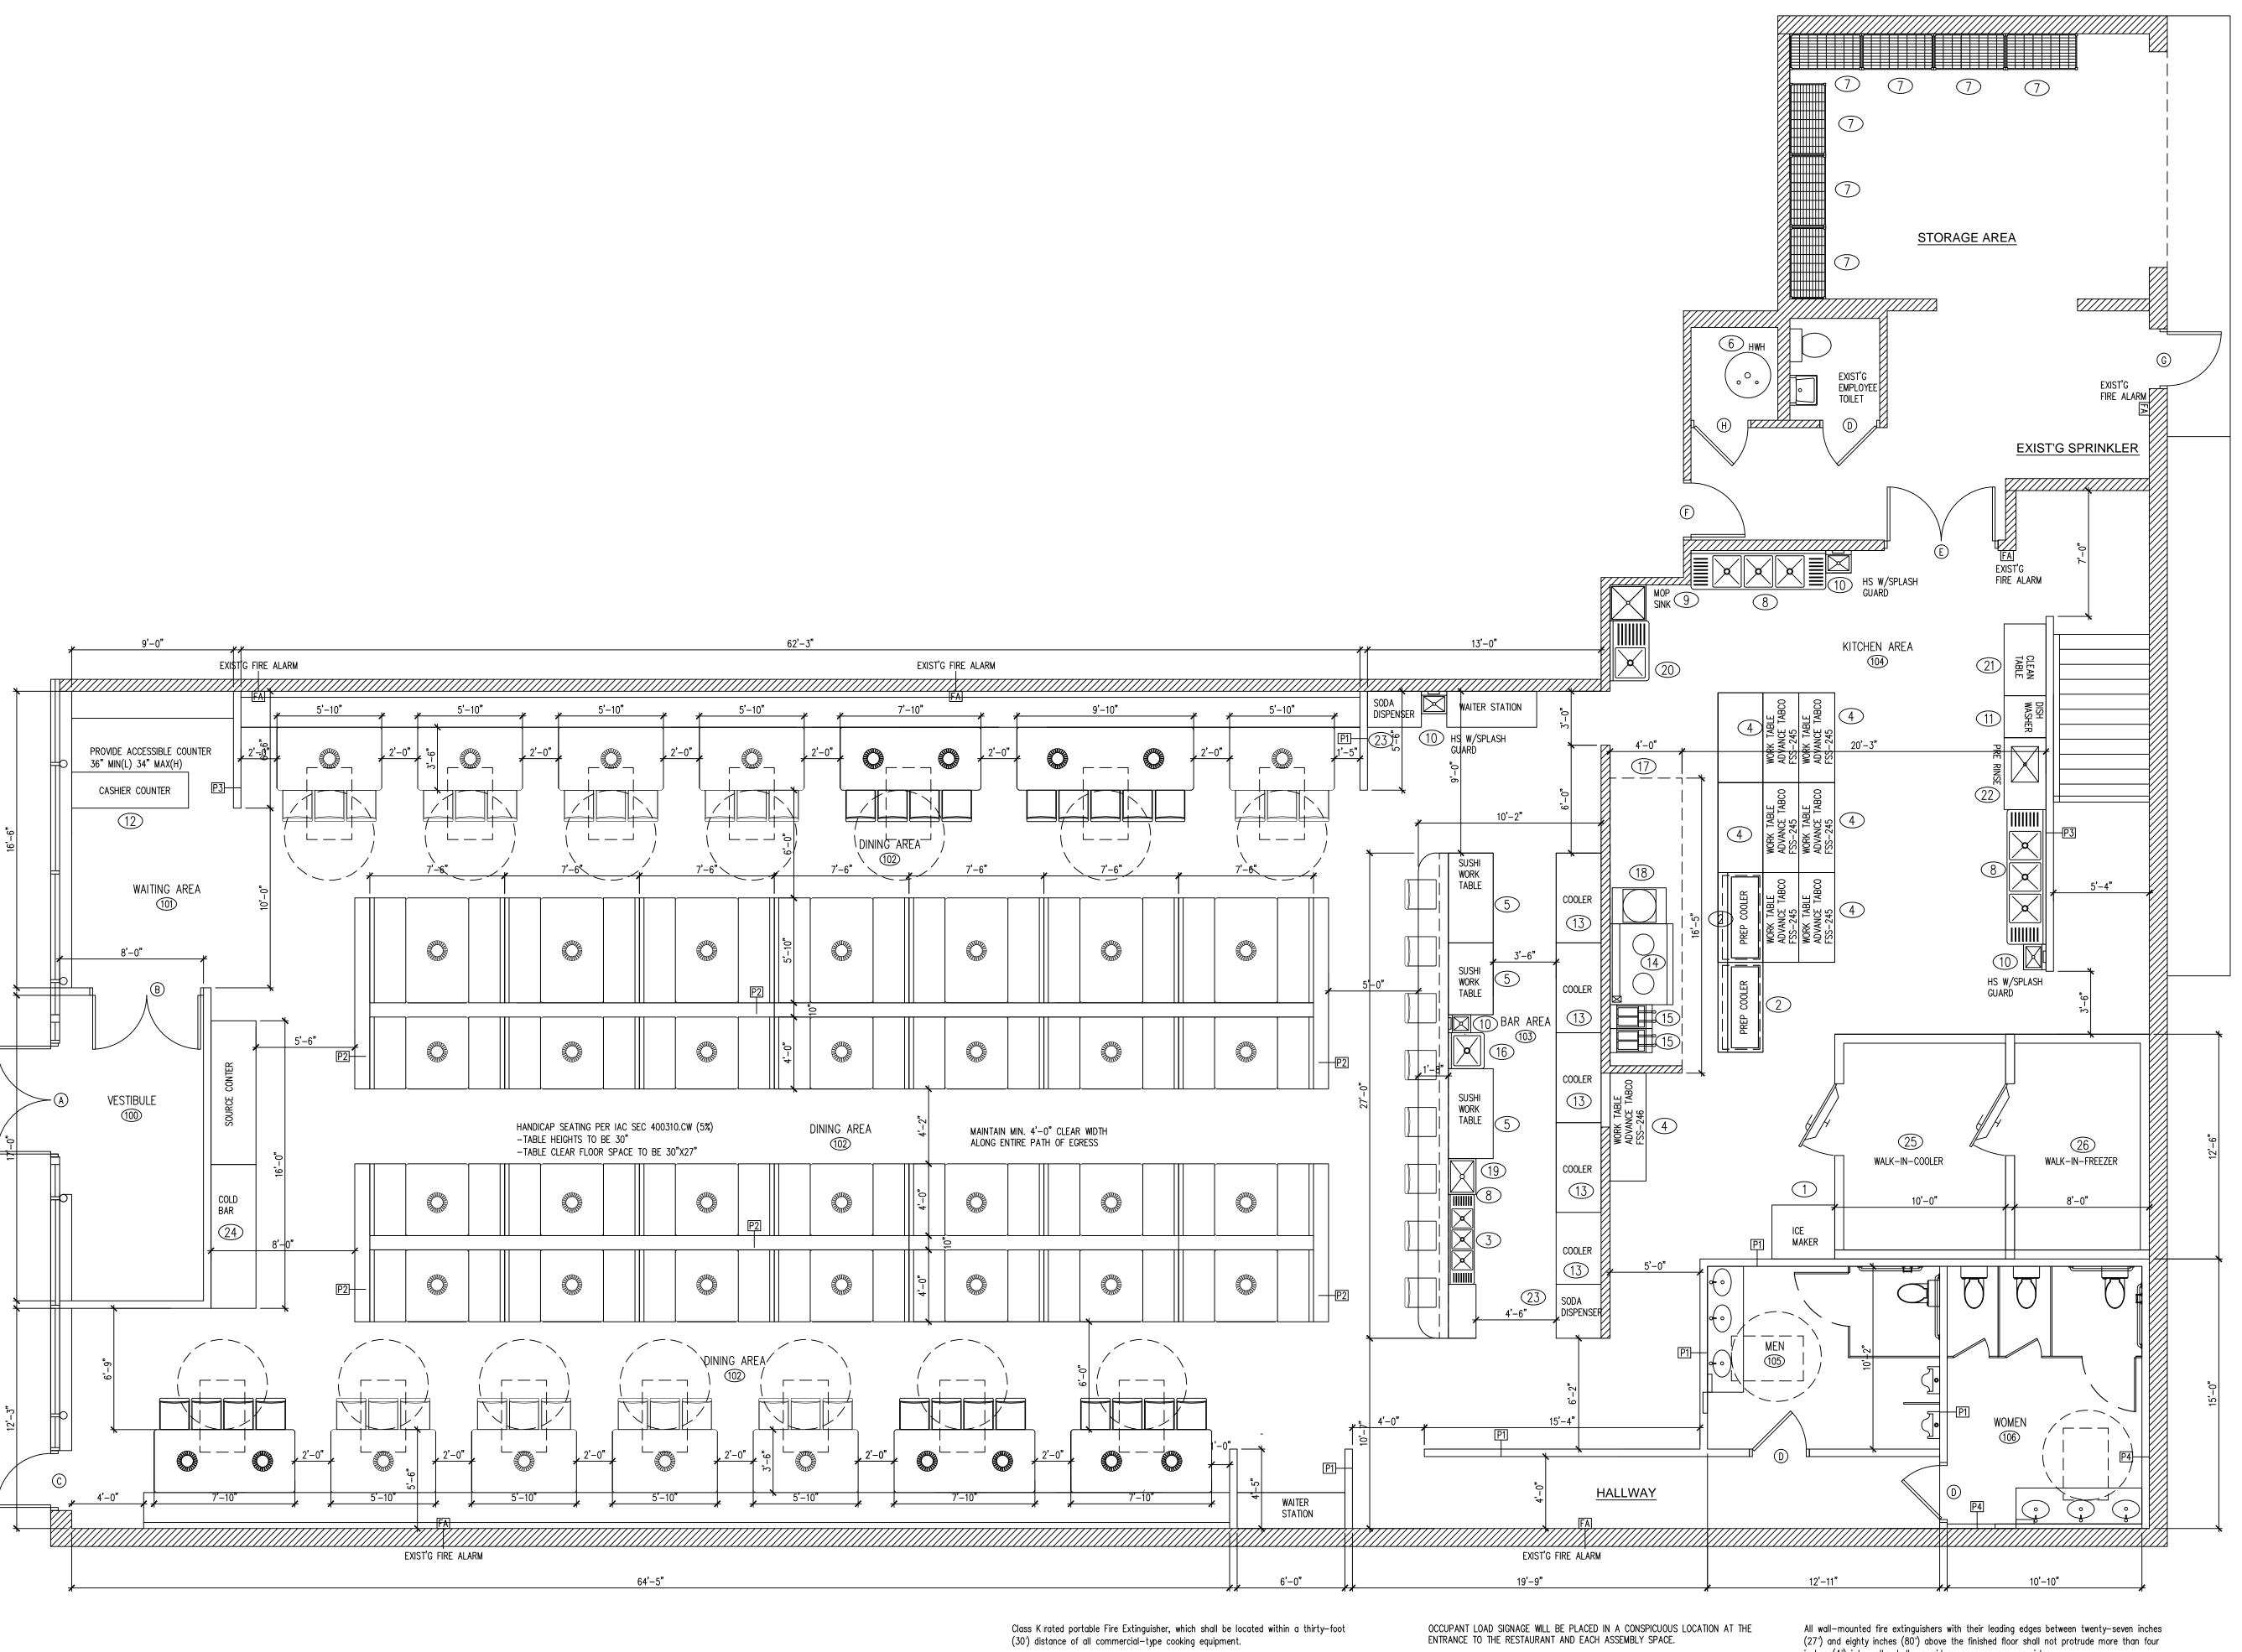


Emergency lighting systems shall be designed and installed so that the failure of any individual lighting element cannot leave in total darkness any space that emergency illumination. A two-lamp (incandescent) fixture, a two-LED driver fixture, or multiple fixtures in proximity to each other will accomplish this.

THE EXIT DOORS ARE EQUIPPED WITH PANIC HARDWARE. IBC 1008. 1. 9 EMERGENCY AND GENERAL EGRESS DISCHARGE LIGHTING. IBC 1006.1 ON SHEET E4 inches (4") into walks, halls, corridors, passageways, or aisles. On each floor of the structure under construction, not less than one (1) approved

extinguisher shall be provided and sized for not less than an ordinary hazard occupancy.

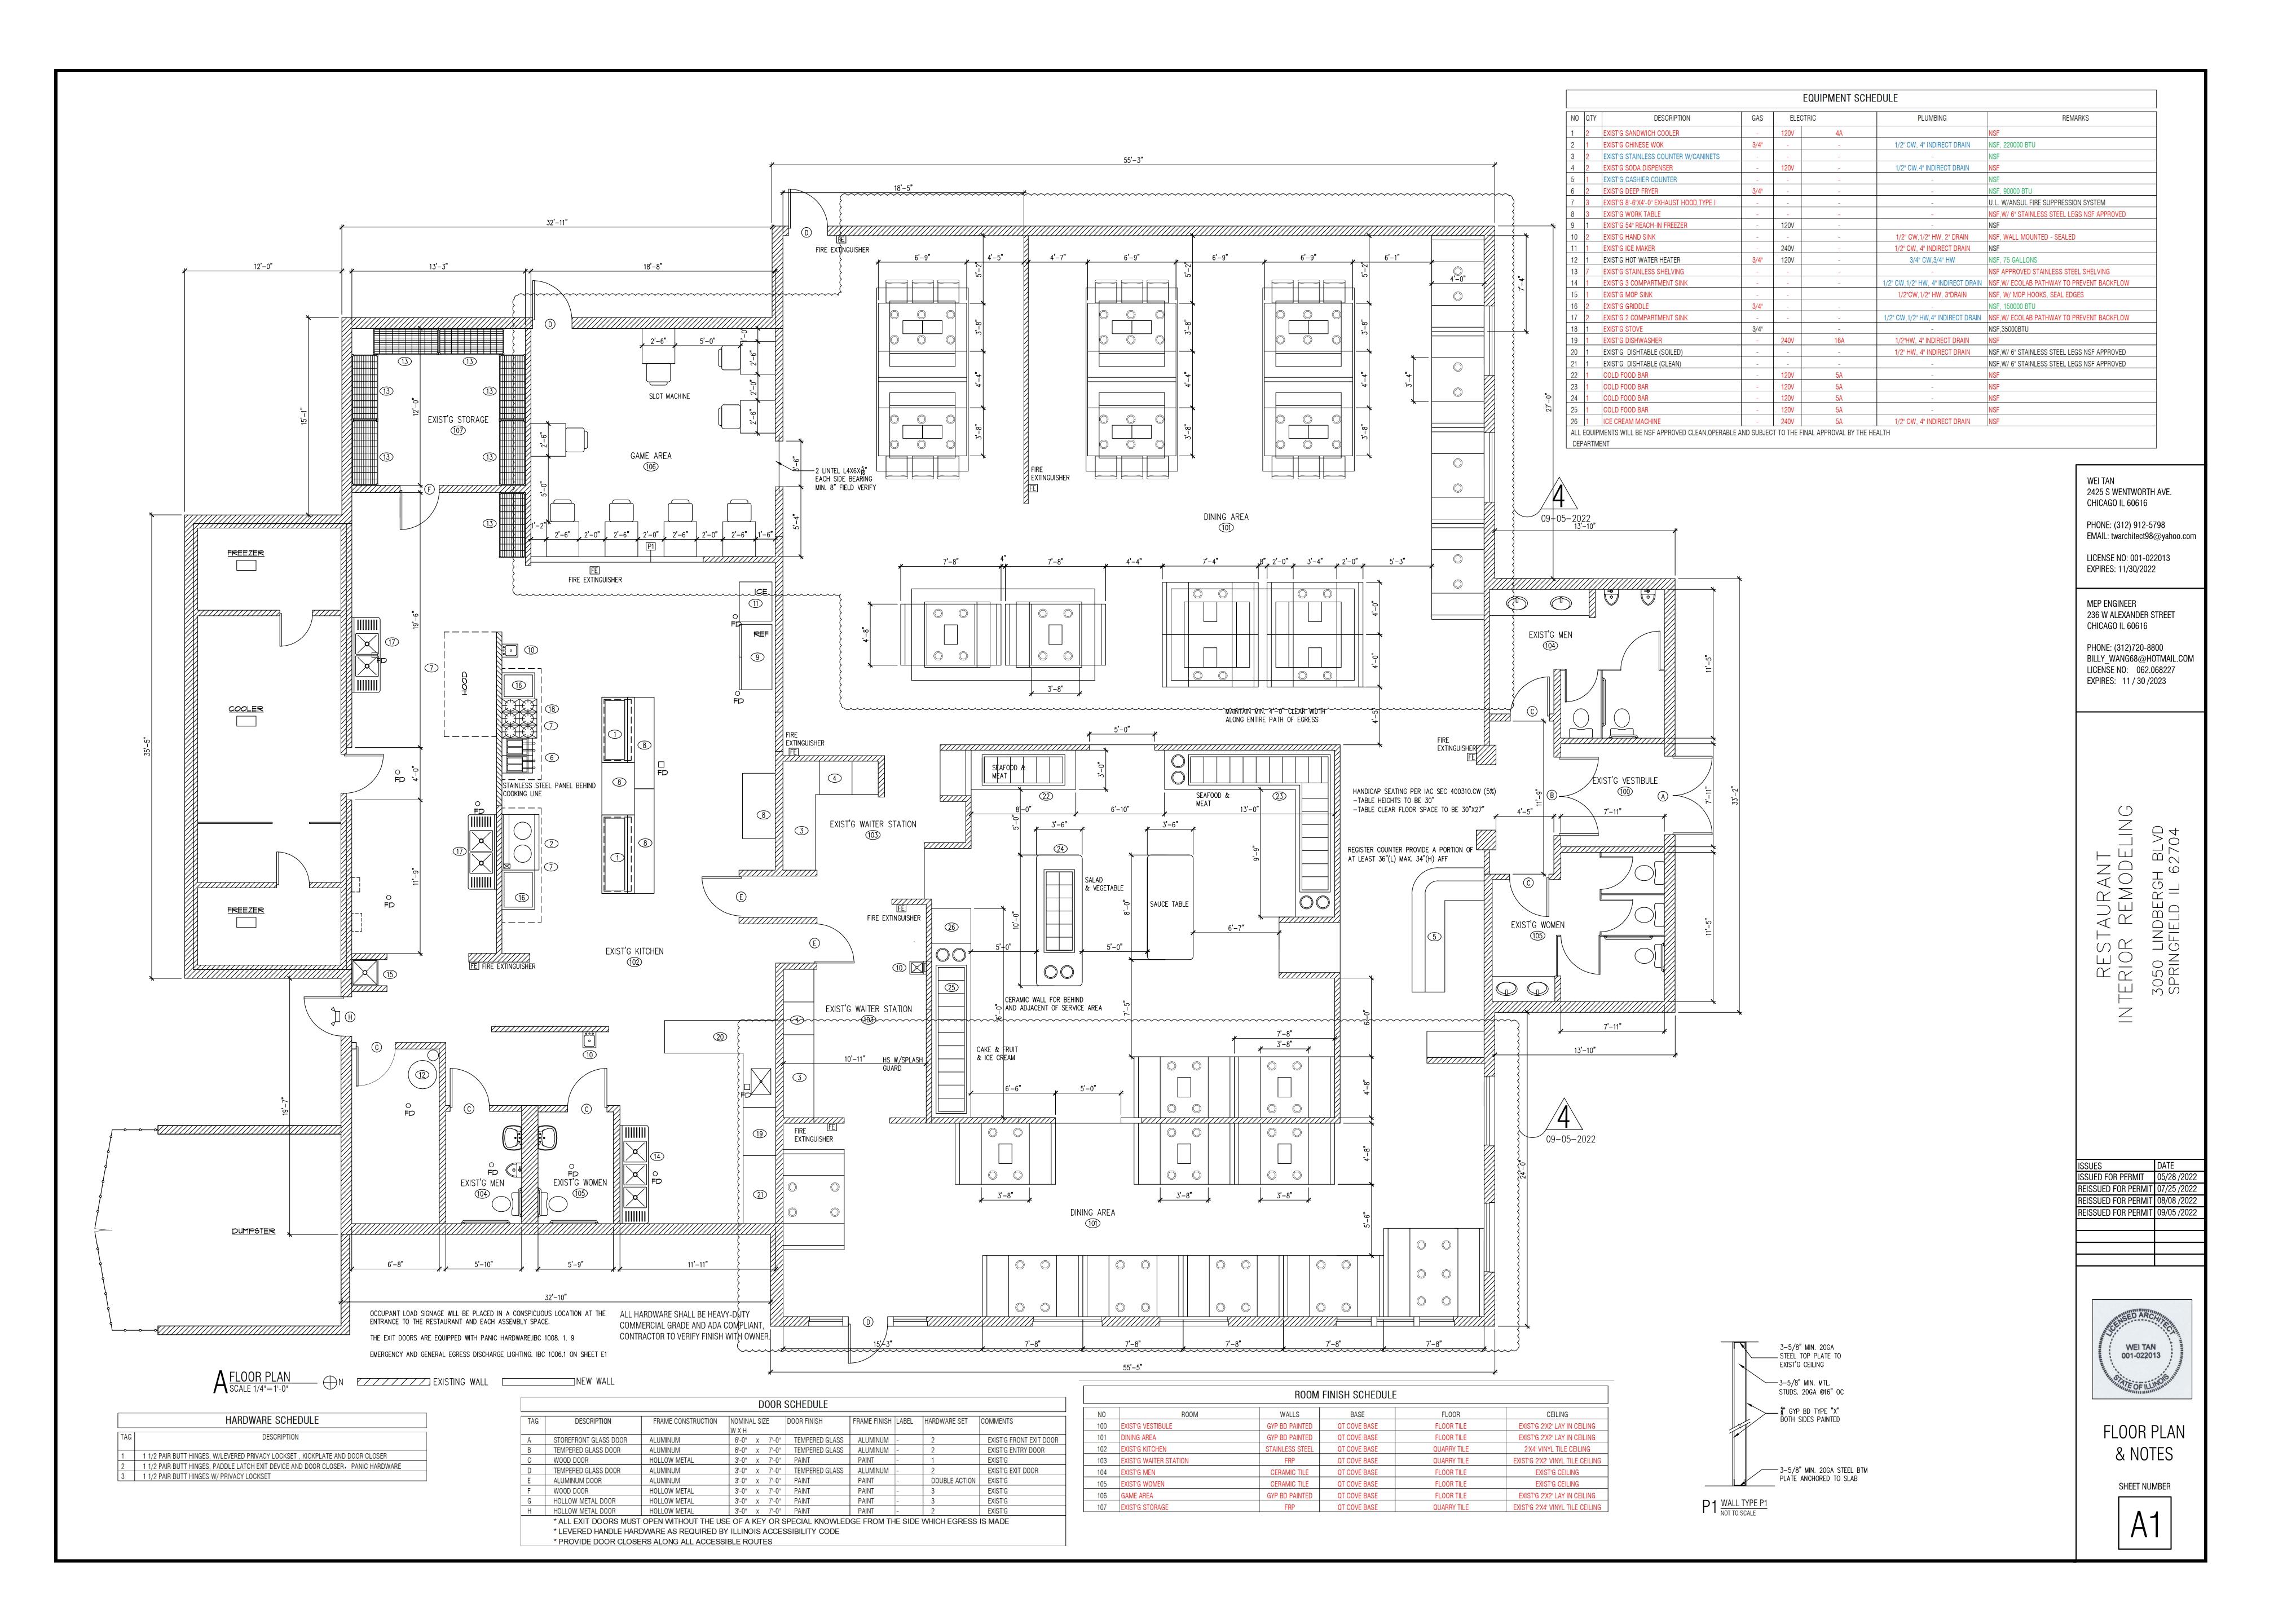

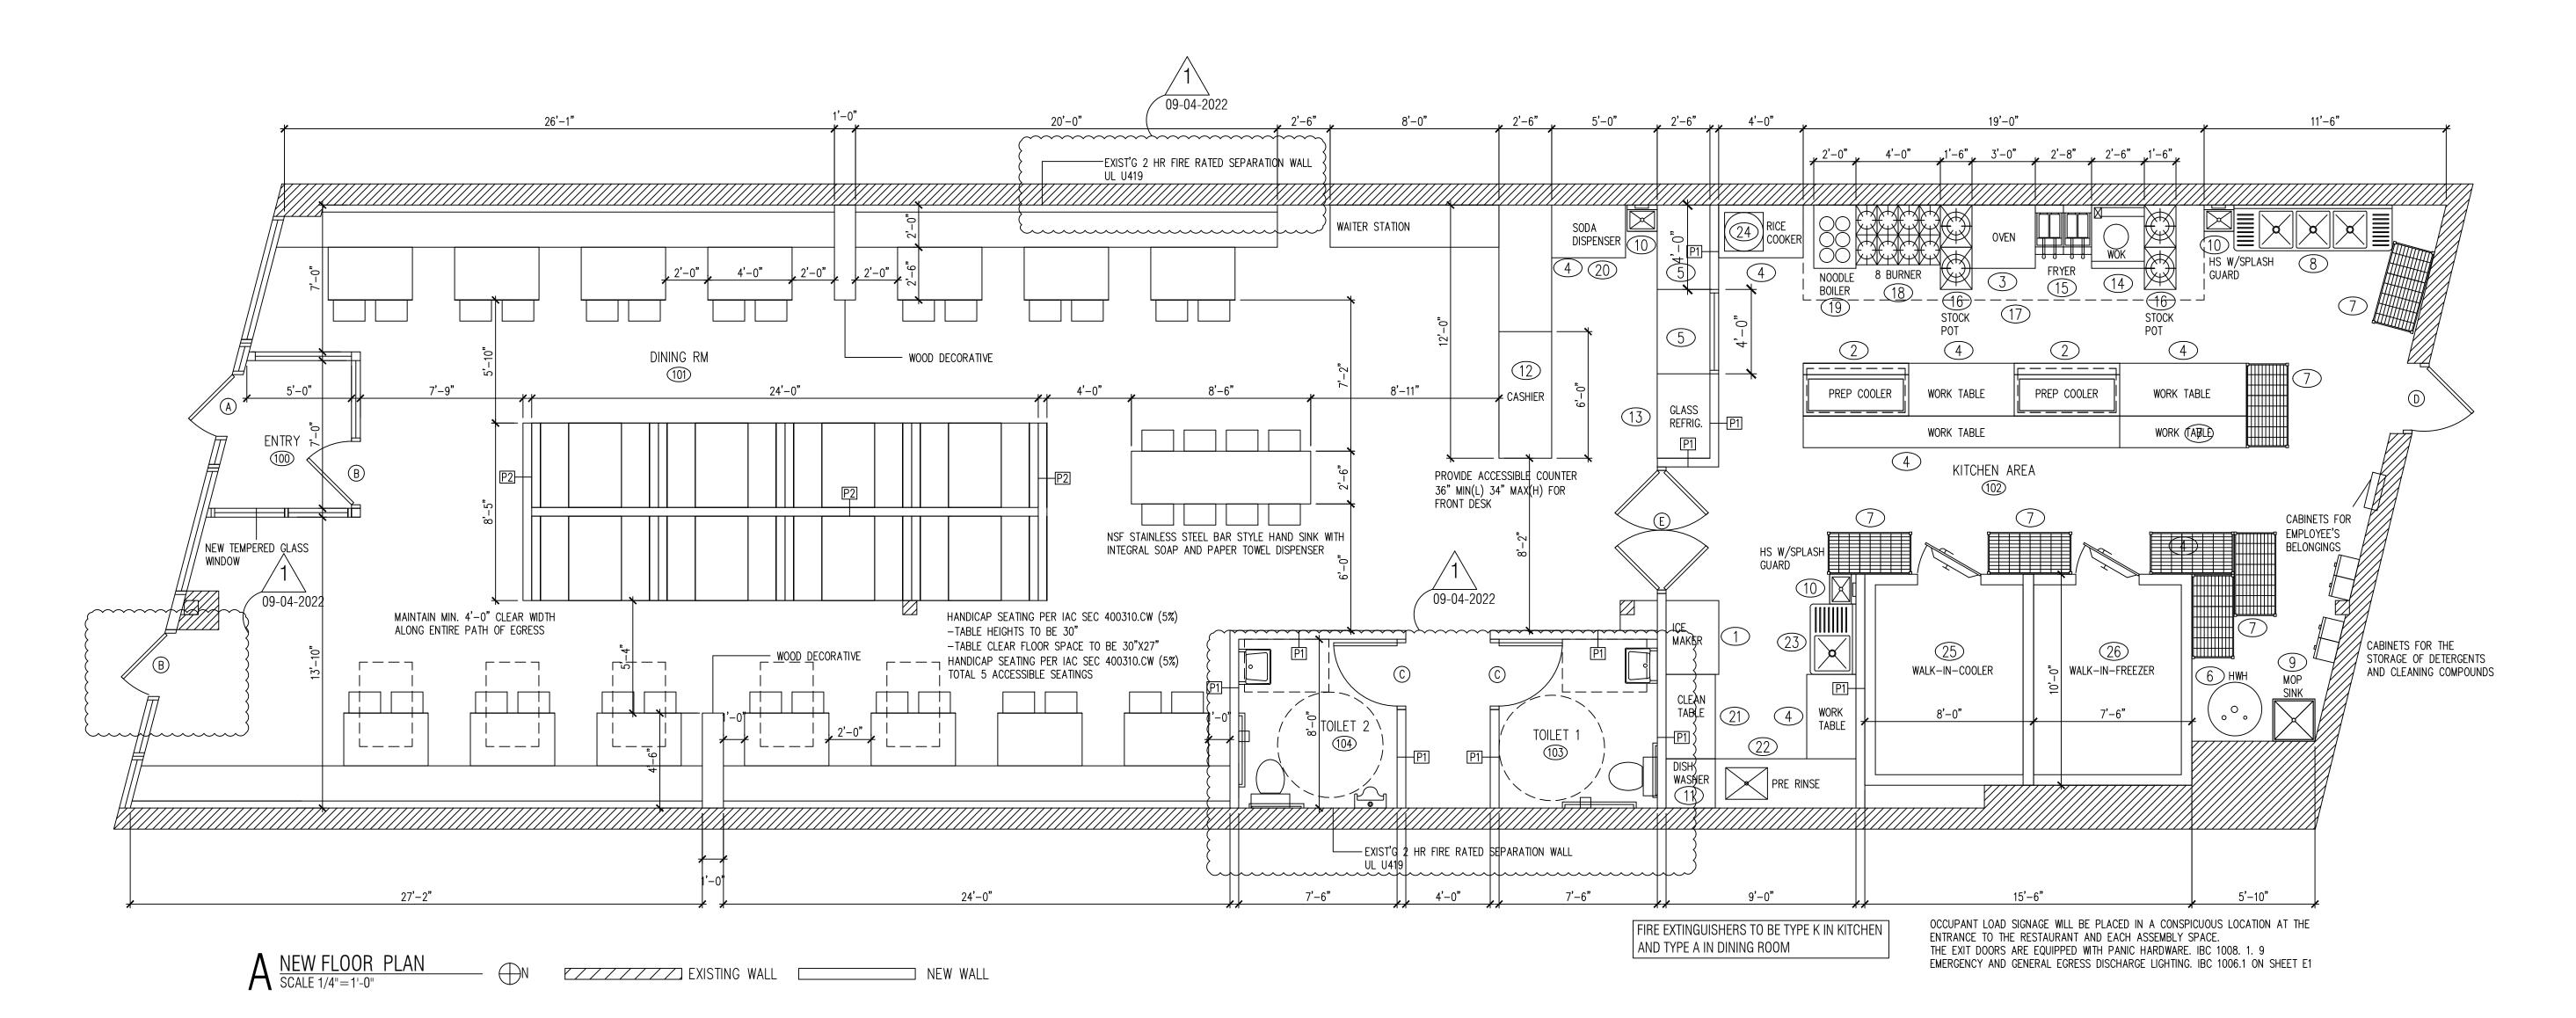

EQUIPMENT SCHEDULE								
NO Q	Y DESCRIPTION	GAS	ELEC	CTRIC	PLUMBING	REMARKS		
1 1	ICE MAKER	-	220V	8A	1/2" CW, 4" INDIRECT DRAIN	NSF,AIR COOLED CONDENSING UNIT		
2 2	60" X 30" PREP COOLER	-	120V	4A	-	NSF,W/ CASTERS		
3 1	OVEN	-	240V	3500W	-	NSF		
4 7	WORK TABLE	-	-	-	_	NSF,W/ 6" STAINLESS STEEL LEGS NSF APPROVED		
5 <mark>2</mark>	48" X 30" UNDERCOUNTER REFRIG.	-	120V	2.7A	_	NSF		
6 1	75 GALLON HWH	1"	120V	-	3/4" CW & 3/4" HW	NSF		
7 2	SHELVING	_	-	-	_	NSF APPROVED STAINLESS STEEL SHELVING		
8 1	3 COMPARTMENT SINK	-	-	-	1/2" CW,1/2" HW,4" INDIRECT DRAIN	NSF,W/ ECOLAB PATHWAY TO PREVENT BACKFLOW		
9 1	MOP SINK	-	-		1/2"CW,1/2" HW, 4" DRAIN	NSF, W/ MOP HOOKS, SEAL EDGES		
10 3	HAND SINK	-	1-	-	1/2" CW,1/2" HW, 2" DRAIN	NSF, WALL MOUNTED - SEALED		
11 1	DISHWASHER	-	240V	50A	1/2"HW, 4" INDIRECT DRAIN	NSF		
12 1	CASHIER COUNTER	-	-	-	-	NSF		
13 1	48" X 30" GLASS REFRIG.	-	120V	3A	_	NSF,W/ CASTERS		
14 1	CHINESE WOK	3/4"	<b> -</b>	÷	1/2" CW, 4" INDIRECT DRAIN	NSF, 120000 BTU		
15 2	DEEP FRYER	3/4"	-	-	-	NSF, 120000 BTU		
16 2	GAS STOCK POT RANGE	3/4"	-	-	-	NSF, 160000 BTU		
17 1	19'-0" X54' TYPE I EXHAUST HOOD	-,		-	-	U.L. W/ ANSUL FIRE SUPPRESSION SYSTEM		
18 1	8 BURNER	3/4"	-	-	-	NSF, 80000BTU		
19 1	NOODLE BOILER	3/4"	~		1/2" CW, 4" INDIRECT DRAIN	NSF, 120000 BTU		
20 1	SODA DISPENSER	-	120V	-	1/2" CW, 4" INDIRECT DRAIN	NSF		
21 <b>1</b>	CLEAN TABLE	_	i=	1=	-	NSF,W/ 6" STAINLESS STEEL LEGS NSF APPROVED		
22 1	PRE RINSE	-	120V	16A	1/2" CW,1/2" HW,4" INDIRECT DRAIN	NSF		
23 1	1 COMPARTMENT SINK	_	-	_	1/2" CW,1/2" HW,4" INDIRECT DRAIN	NSF,W/ ECOLAB PATHWAY TO PREVENT BACKFLOW		
24 1	ELECTRIC RICE COOKER	-	120V	-		NSF		
25 1	8'X10' WALK IN COOLER	-	240V	8A	-	NSF		
26 1	8'X10' WALK IN FREEZER	-	240V	10A	_	NSF		
ALL EQI	ALL EQUIPMENTS WILL BE NSF APPROVED CLEAN, OPERABLE AND SUBJECT TO THE FINAL APPROVAL BY THE HEALTH							

	DOOR SCHEDULE									
TAG	DESCRIPTION	FRAME CONSTRUCTION	NOMINA	AL SI	ZE	DOOR FINISH	FRAME FINISH	LABEL	HARDWARE	COMMENTS
A	STORE FRONT GLASS DOOR	ALUMINUM	W X H 3'-0"	X	7'-0"	TEMPERED GLASS	ALUMINUM	-	3	EXIST'G
В	TEMPERED GLASS DOOR	ALUMINUM	3'-0"	Χ	7'-0"	TEMPERED GLASS	ALUMINUM	_	3	NEW
С	WOOD DOOR	HOLLOW METAL	3'-0"	X	6'-8"	PAINT	PAINT	-	1	NEW
D	HOLLOW METAL DOOR	PRE-HUNG METAL	3'-0"	Χ	7'-0"	PAINT	PAINT	,-	3	EXIST'G
E	WOOD DOOR	ALUMINUM	6'-0"	X	7'-0"	PAINT	PAINT	-	DOUBLE ACTION	NEW
ALL EXIT DOORS MUST OPEN WITHOUT THE USE OF A KEY OR SPECIAL KNOWLEDGE FROM THE SIDE WHICH EGRESS IS MADE										
	LEVERED HANDLE HARDWARE AS REQUIRED BY ILLINOIS ACCESSIBILITY CODE									
	PROVIDE DOOR CLOSERS ALONG ALL ACCESSIBLE ROUTES									

DEPARTMENT

	ROOM FINISH SCHEDULE							
NO	ROOM	WALLS	BASE	FLOOR	CEILING			
100	ENTRY	TEMPERED GLASS	QT COVE BASE	FLOOR TILE	2X2 TILE CEILING			
101	DINING RM	GYP. BD. PAINTED	QT COVE BASE	FLOOR TILE	OPEN CEILING			
102	KITCHEN	STAINLESS STEEL	QT COVE BASE	QUARRY TILE	2X4 VINYL TILE CEILING			
103	TOILET 1	CERAMIC TILE	CERAMIC TILE	FLOOR TILE	2X4 VINYL TILE CEILING			
104	TOILET 2	CERAMIC TILE	CERAMIC TILE	FLOOR TILE	2X4 VINYL TILE CEILING			

#### KITCHEN EQUIPMENT NOTES

CONTRACTOR SHALL INSTALL AND CONNECT ALL EQUIPMENT AS PER EQUIPMENT SUPPLIER'S SPECIFICATIONS. ALL LOCATIONS TO BE VERIFIED WITH OWNER PRIOR TO INSTALLATION.

PLUMBING CONTRACTOR SHALL PROVIDE ALL ROUGH-INS. INSULATE ALL COLD/HOT WATER PIPES AS REQUIRED. MAINTAIN MIN 36" IN FRONT OF ALL COOKING EQUIPMENT.

ELECTRICAL CONTRACTOR SHALL PROVIDE ALL ELECTRICAL OUTLETS FOR EQUIPMENT. VERIFY ALL ELECTRICAL REQUIREMENTS WITH EQUIPMENT SUPPLIER. VERIFY ALL GAS AND WATER REQUIREMENTS WITH EQUIPMENT SUPPLIER.

ALL PERMANENT EQUIPMENT MUST BE LOCATED SO THAT AREAS BEHIND, UNDERNEATH, AND ON THE SIDES OF THE EQUIPMENT CAN BE EASILY CLEANED.

TWO DRAIN BOARDS ARE REQUIRED AT ALL THREE-COMPARTMENT SINKS ALONG WITH AN APPROPRIATELY SIZED FAUCET, LOCKABLE DRAIN PLUGS, AND AN INDIRECT CONNECTION TO THE SEWER.

## DRY STORAGE

DRY STORAGE : 25% OF 800SF (KITCHEN AREA.)=200SF REQ'D ACTUAL DRY STORAGE 7X4X4X2= 224SF PROVIDED.

ALL FOOD AND FOOD RELATED ITEMS MUST BE STORED OFF THE FLOOR ON DURABLE WASHABLE SHELVES. THE STORAGE AREA MUST BE APPROPRIATELY SIZED BASED ON THE NUMBER OF MEALS SERVED DAILY AND THE NUMBER OF DELIVERIES WEEKLY.

ALL FOOD EQUIPMENT TO BE ON CASTERS, 6" LEGS, OR SEALED TO THE FLOOR FOR EASY CLEANING.

NO RAW WOOD SURFACES PERMITTED ANYWHERE. UNDERSIDES OF COUNTERTOPS, INSIDE OF CABINETRY, AND WATER HEATER PLATFORMS MUST BE SEALED.

- Dial stem thermometers (ranging from 0° to 220°F) are required in all preparation areas.
- Chemical test kits (specific to the sanitizer) are required for the appropriate sanitizer.
- pH meter and log for acidifying rice.

of 15 seconds

- All cooling/freezing units must have accurate thermometers.
- Covered waste cans are required in all restrooms.
- Toilets, urinals, hand sinks, 3 compartment sinks, mop sink, prep sinks, and permanent counters/cabinets must be sealed to floors and walls with a silicone caulk seal.
   Anti-siphon devices are required on all toilet tanks, urinals, and faucets with hose
- connections.
- Soap and paper towels are required at all hand sinks.
- Provide hair restraints and disposable gloves for all food handlers.
   If sinks are provided with spring-loaded faucets, the faucets must remain running for a minimum

Doors leading to the outside and restroom doors are required to be self-closing and tight-fitting. Please confirm that the doors leading to the outside are equipped with a self-closer and weather strips to eliminate any air gaps.


PROVIDE THE FOLLOWING: NSF STAINLESS STEEL OPEN WIRE SHELVING UNITS.
NSF STAINLESS STEEL SHELF OVER 3-COMPTMENT SINK. ICE MAKER A MIN. 8" FROM ALL WALLS.
HEAVY-DUTY MOP RACKS LOCATED OVER MOP SINK.

HEAVY-DUTY BROOM RACKS IN JANITORIAL AREA. METAL GARBAGE CANS WITH LIDS FOR RESTROOMS. SANITARY BOX IN WOMEN'S RESTROOMS. METAL GARBAGE CANS WITH LIDS FOR DIAPER CHANGING STATION.

ALL NSF APPROVED HAND SINKS TO BE WITH BLADE HANDLED FAUCETS.
BEVERAGE STATION & BAR COUNTER TOP -STAINLESS STEEL .
ALL CABINET SHELVES -STAINLESS STEEL.

ALL CABINET BASE - 6" STAINLESS STEEL LEGS (NO KICK BASE)
LAVATORY COUNTERTOP TO BE SOLID SURFACE (NO PLASTIC LAMINATE OR CABINETRY)
ANY PAINTED FINISHES TO BE SEMI-GLOSS OR GLOSS (NO FLAT, NO EGG SHELL,NO TEXTURE),
PROVIDE TILE ON WALL AND UNDERSIDE OF BAR.

STAINLESS STEEL WALL FINISH FOR BEHIND AND ADJACENT TO COOK LINE

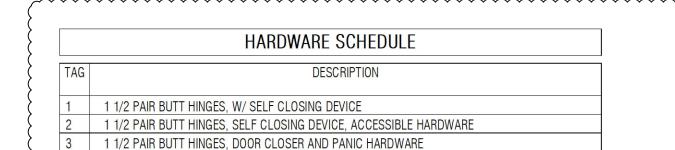


IBC 714.3 - Fire-Resistance Rated Walls - Penetrations into or through fire-resistance rated walls shall comply with this section. Separating walls are rated, so any penetrations should be treated in accordance with this section.

IBC 714 - Penetrations - All penetrations through membranes of rated assemblies or through rated assemblies shall be constructed as required by this section. This is same as the previous comment regarding existing demising walls.

Verify thresholds at all locations. Especially concerned with front door out of space, as there have been significant issues on most projects at Pacifica Square with this detail. Need to make sure it is code compliant installation



09-04-2022

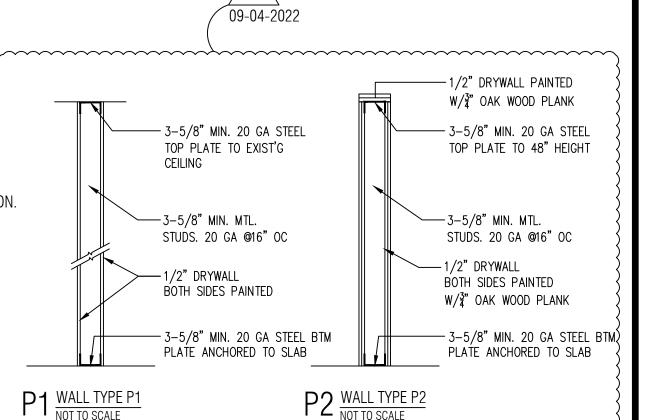

WEI TAN 2425 S WENTWORTH AVE CHICAGO IL 60616

Phone: (312) 912-5798 Email: twarchitect98@yahoo.com

LICENSE NO: 001-022013

EXPIRES: 11/30/2022

NTERIOR REMODELING

ISSUES DATE
ISSUED FOR PERMIT 07/28/2022
REISSUED FOR PERMIT 09/04/2022



FLOOR PLANS &



## LANDSCAPING NOTES

- 1. CONTRACTOR SHALL CONSTRUCT THIS PROJECT IN STRICT ACCORDANCE WITH ALL SPECIFICATIONS RELATED TO THIS PROJECT INCLUDING LANDSCAPE GRADING, HYDROSEEDING, AND PLANT MATERIAL.
- 2. CONTRACTOR IS RESPONSIBLE FOR VERIFYING ALL QUANTITIES SHOWN ON PLANS BEFORE PRICING THE WORK.
- 3. STANDARDS SET FORTH IN 'AMERICAN STANDARD FOR NURSERY STOCK "REPRESENT GUIDELINE SPECIFICATIONS ONLY AND SHALL CONSTITUTE MINIMUM QUALITY REQUIREMENTS FOR PLANT MATERIAL.
- 4. ALL PLANTS MUST BE HEALTHY, VIGOROUS MATERIAL, AND FREE OF PESTS AND DISEASE.
- 5. BALLED AND BURLAPPED PLANTS SHALL BE PROVIDED FROM GROWING SOURCES WITH THE SAME CLIMATIC CONDITIONS.
- 6. TREES MUST BE STRAIGHT TRUNKED WITH FULL CROWNS AND MEET ALL REQUIREMENTS SPECIFIED. TREES SHALL BE SINGLE LEADER, UNLESS OF OTHERWISE SPECIFIED.
- 7. ANY PLANTS DUG 'IN LEAF' SHALL BE ACCLIMATED FOR TWO (2) WEEKS UNDER A MIST SYSTEM PRIOR TO INSTALLATION.
- 8. ALL PLANTS ARE SUBJECT TO OWNER'S APPROVAL BEFORE, DURING AND AFTER INSTALLATION.
- 9. PRIOR TO CONSTRUCTION, THE CONTRACTOR SHALL LOCATE ALL UNDERGROUND UTILITIES AND SHALL AVOID DAMAGE TO UTILITIES DURING CONSTRUCTION. CONTRACTOR SHALL REPAIR ANY DAMAGE TO UTILITIES, STRUCTURES, SITE APPURTENANCES, ETC. WHICH OCCUR AS A RESULT OF OPERATIONS.
- 10. SAFE, CLEARLY MARKED PEDESTRIAN AND VEHICULAR ACCESS TO ALL ADJACENT PROPERTIES MUST BE MAINTAINED THROUGHOUT THE CONSTRUCTION PROCESS.
- 11. OWNER SHALL APPROVE STAKED LOCATIONS OF ALL PLANT MATERIAL PRIOR TO INSTALLATION.
- 12. ALL PLANTS SHALL BE MULCHED AS SPECIFIED USING SHREDDED HARDWOOD MULCH. SHRUBS IN MASSES OR ROWS WILL BE MULCHED CONTINUOUSLY BETWEEN PLANTS.BEDS SHALL BE MULCHED CONTINUOUSLY.
- 13. CONTRACTOR SHALL FULLY MAINTAIN (INCLUDING WATERING, TRIMMING, TREATMENT OF INSECTS OR DISEASE) ALL SEED AREAS AND PLANTS FOR TWO (2) FULL MONTHS OR UNTIL FINAL PROJECT ACCEPTANCE, WHICHEVER IS LONGER WORK WILL BE ACCEPTED ONLY WHEN TURF AND PLANT MATERIAL IS IN HEALTHY AND ATTRACTIVE CONDITION.
- 14. CONTRACTOR SHALL GUARANTEE ALL PLANT MATERIAL AND SEEDING FOR A PERIOD OF ONE (1) YEAR PLUS ONE GROWING SEASON BEGINNING ON THE DATE OF PROJECT ACCEPTANCE. ANY MATERIAL THAT DIES, IN PART OF WHOLE, OR DEFOLIATES SHALL BE PROMPTLY REMOVED FROM THE SITE AND REPLACED WITH MATERIAL OF THE SAME SPECIES, SIZE AND QUANTITY. THE CONTRACTOR SHALL MAKE REPLACEMENTS PROMPTLY AS REQUESTED BY OWNER. MAINTENANCE AFTER SUBSTANTIAL COMPLETION IS THE RESPONSIBILITY OF THE OWNER. ALL UNPAVED AREAS SHOWN SHALL RECEIVE HYDROSEEDING.
- 15. PROVIDE SOIL IN PLANTING AREAS WHERE PAVING AND GRAVEL SUB-BASE WERE REMOVED.
- 16. PROVIDE PROPOSED PLANT SPECIES WITH BID FOR APPROVAL.

MARK	SYMBOL	DESCRIPTION	SIZE	
T-1		EVERGREEN TREE (TREE CLASSIFICATION)  EASTERN WHITE PINE (PINUS STROBUS)	1.5" BB 10' MIN. HT.	18 pts.  +5 pts. (NATIVE PLANTING) 23 PTS. EA.
S-1	, with	DECIDUOUS SHRUBS (SHRUB CLASSIFICATION)  'GRO-LOW' SUMAC (RHUS AROMATICA)	3-GAL. CONTAINER 24" HEIGHT	2 pts.  +3 pts. (NATIVE PLANTING) 5 PTS. EA.
S-2	*	DECIDUOUS SHRUBS (SHRUB CLASSIFICATION) SPIREA 'GOLD FLAME'	3-GAL. CONTAINER 24" HEIGHT	2 pts.  +3 pts. (NATIVE PLANTING) 5 PTS. EA.

## LANDSCAPING CALCULATIONS

STREET FRONT	100.0' = 50  PTS. REQ'D
(3) EVERGREEN TREES @ 23 PTS. EA.	= 69 PTS.
(2) DECIDOUS SHRUBS @ 5 PTS. EA.	= 10 PTS.
TOTAL	$= \overline{79}  PTS.$

TOTAL POINTS REQUIRED = 74 PTS.

TOTAL POINTS PROVIDED = 169 PTS.


## REQUIRED PARKING CALCULATIONS


1: 990SF DINING AREA /100SF = 10 PARKING SPACES
2: 578SF GAME AREA/100SF = 6 PARKING SPACES

3: THE OTHER KITCHEN AREA 868SF /100SF = 8 PARKING SPACES

TOTAL CODE REQUIRED PARKING SPACES = 10+6+8=24 PARKING SPACES AND ONE ADA PARKING SPACE REQUIRED.

03-28-2022

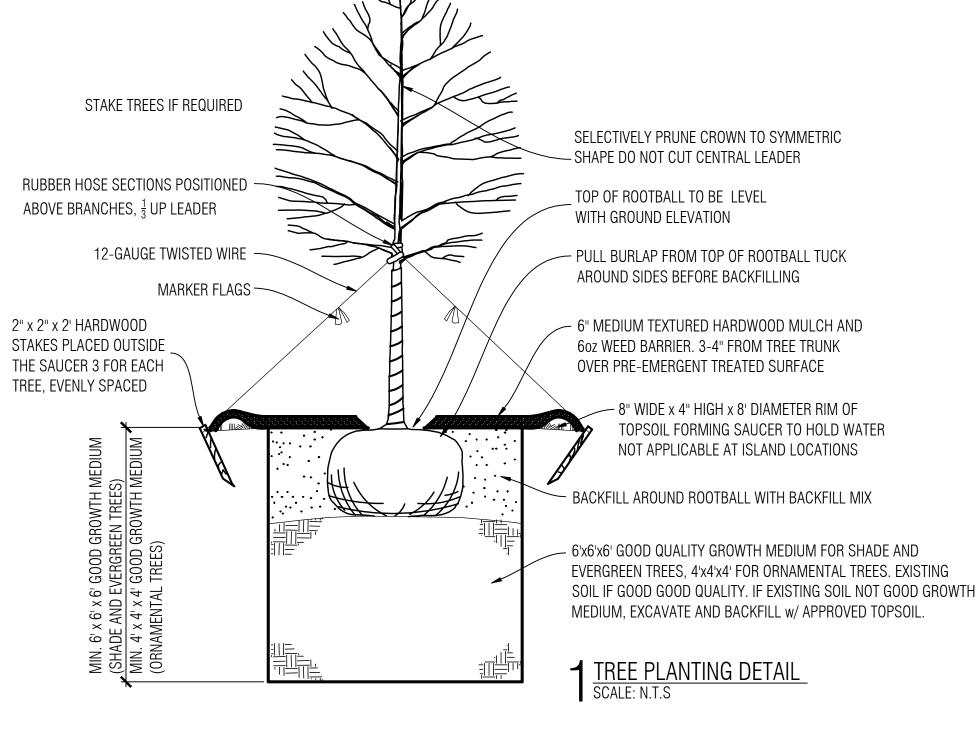

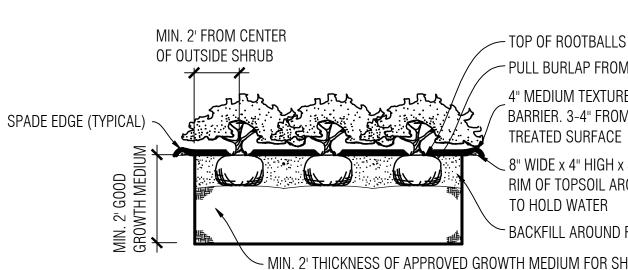

TOP OF ROOTBALLS TO BE LEVEL WITH GROUND ELEVATION

PULL BURLAP FROM TOP OF ROOTBALLS TUCK AROUND SIDES BEFORE BACKFILLING


4" MEDIUM TEXTURED HARDWOOD MULCH AND 6 oz. WEED

BARRIER. 3-4" FROM SHRUB STEMS OVER PRE-EMERGENT

RIM OF TOPSOIL AROUND HEDGE OR BED FORMING SAUCER
TO HOLD WATER

BACKFILL AROUND ROOTBALL WITH BACKFILL MIX

MIN. 2' THICKNESS OF APPROVED GROWTH MEDIUM FOR SHRUB HEDGE, 2'x2'x2' FOR INDIVIDUAL SHRUBS. MEDIUM CAN BE EXISTING SOIL IF GOOD QUALITY. IF EXISTING

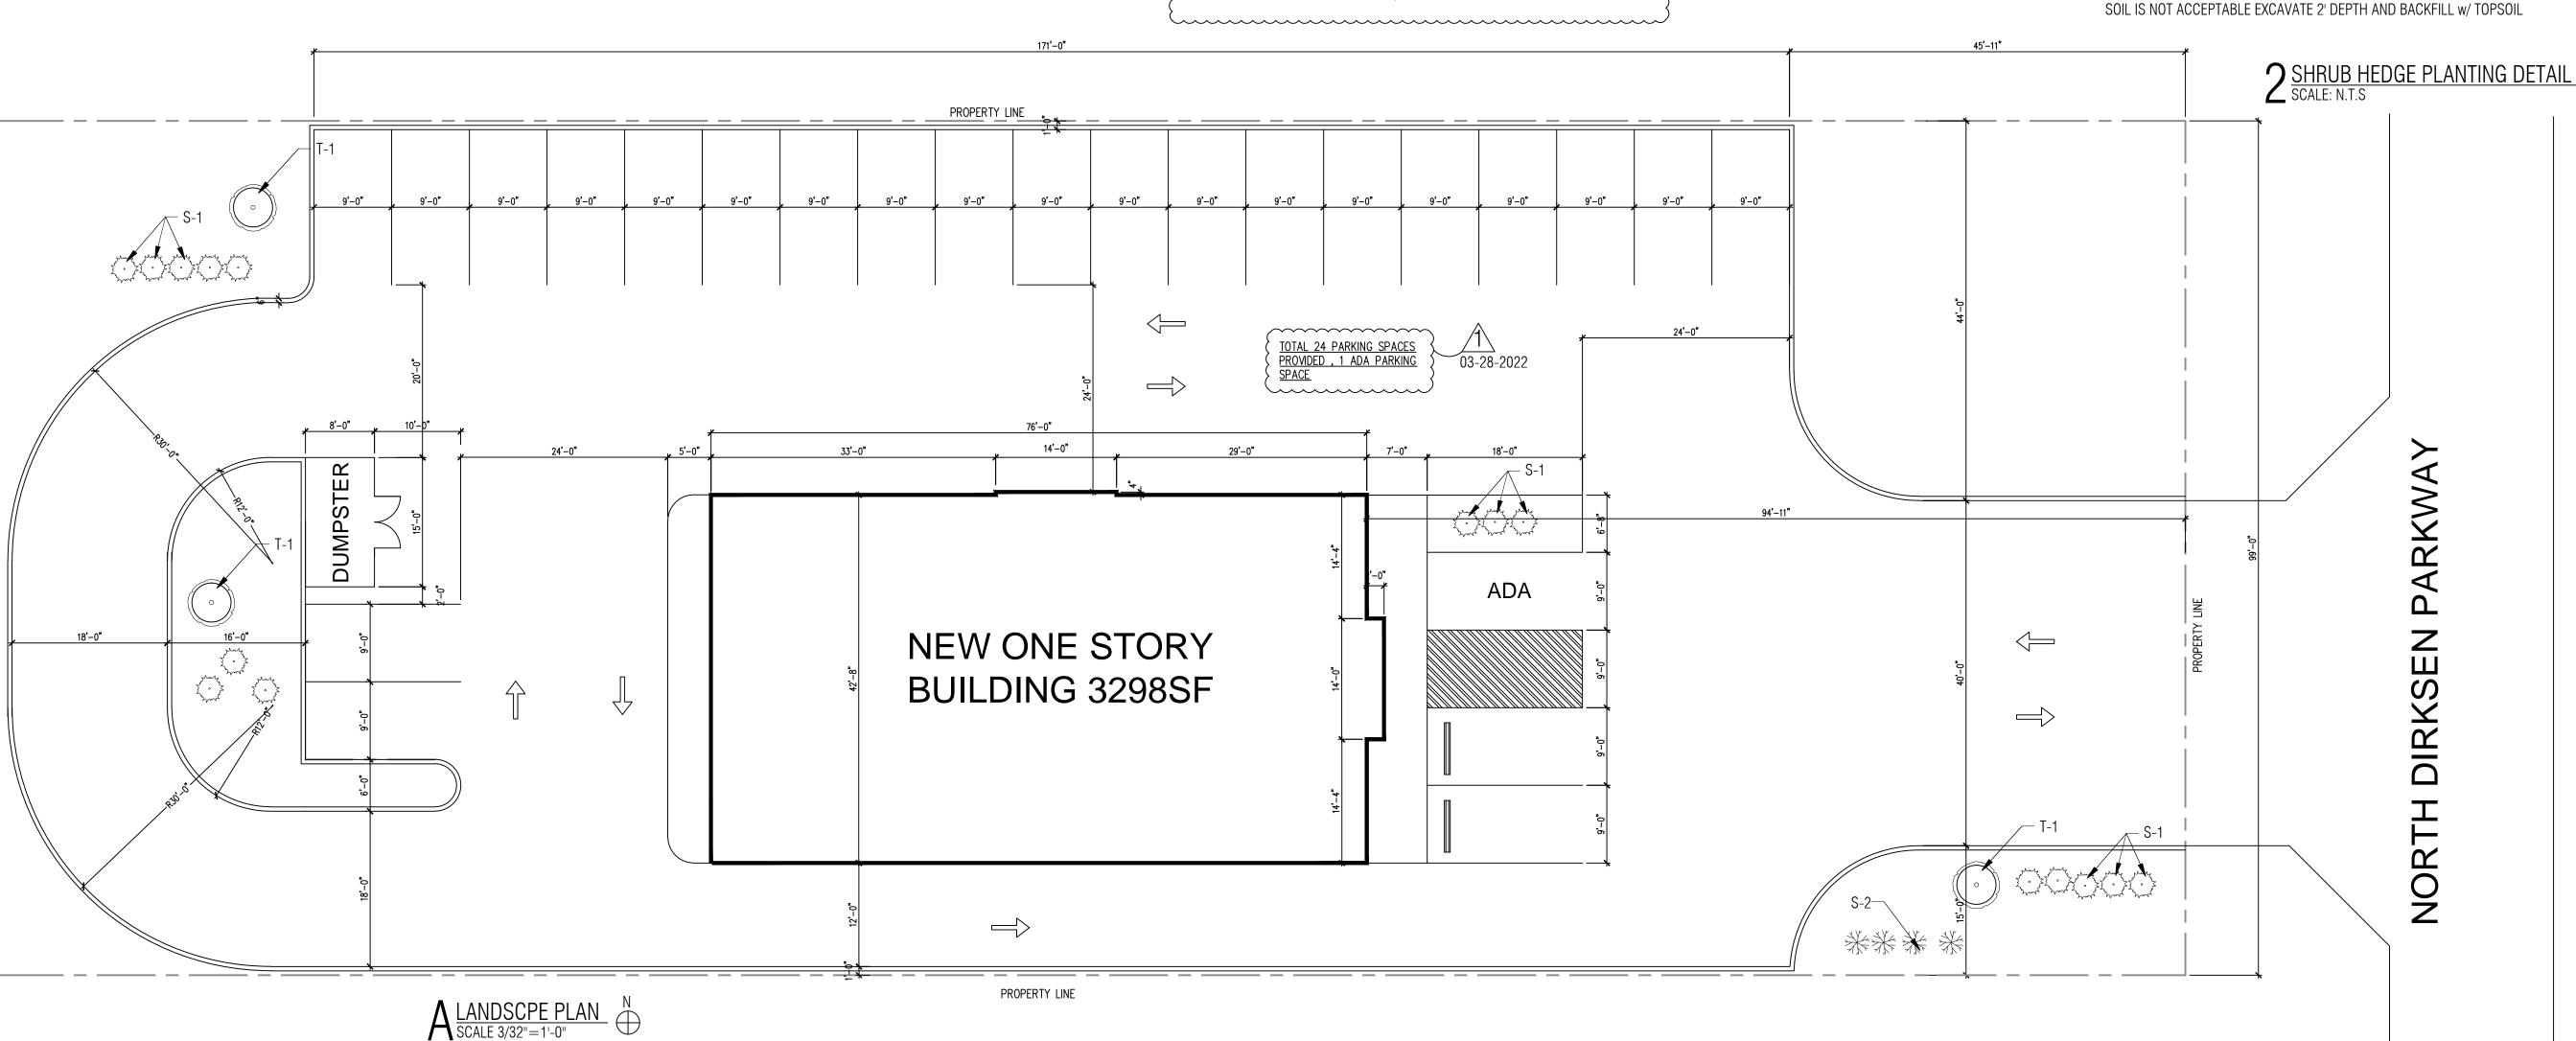

WEI TAN 2425 S WENTWORTH AVE. CHICAGO IL 60616

PHONE: (312) 912-5798 EMAIL: twarchitect98@yahoo.com

> LICENSE NO: 001-022013 EXPIRES: 11/30/2022

MEP ENGINEER 236 W ALEXANDER STREET CHICAGO IL 60616

PHONE: (312)720-8800
BILLY\_WANG68@HOTMAIL.COM
LICENSE NO: 062.068227
EXPIRES: 11 / 30 /2023

SUILD A NEW ONE STORY
COMMERCIAL BUILDING
2811 NORTH DIRKSEN PKWY


ISSUES	DATE
ISSUED FOR PERMIT	02/08 /2022
REISSUED FOR PERMIT	03/28 /2022



LANDSCAPE PLAN & NOTES

SHEET NUMBER

A1

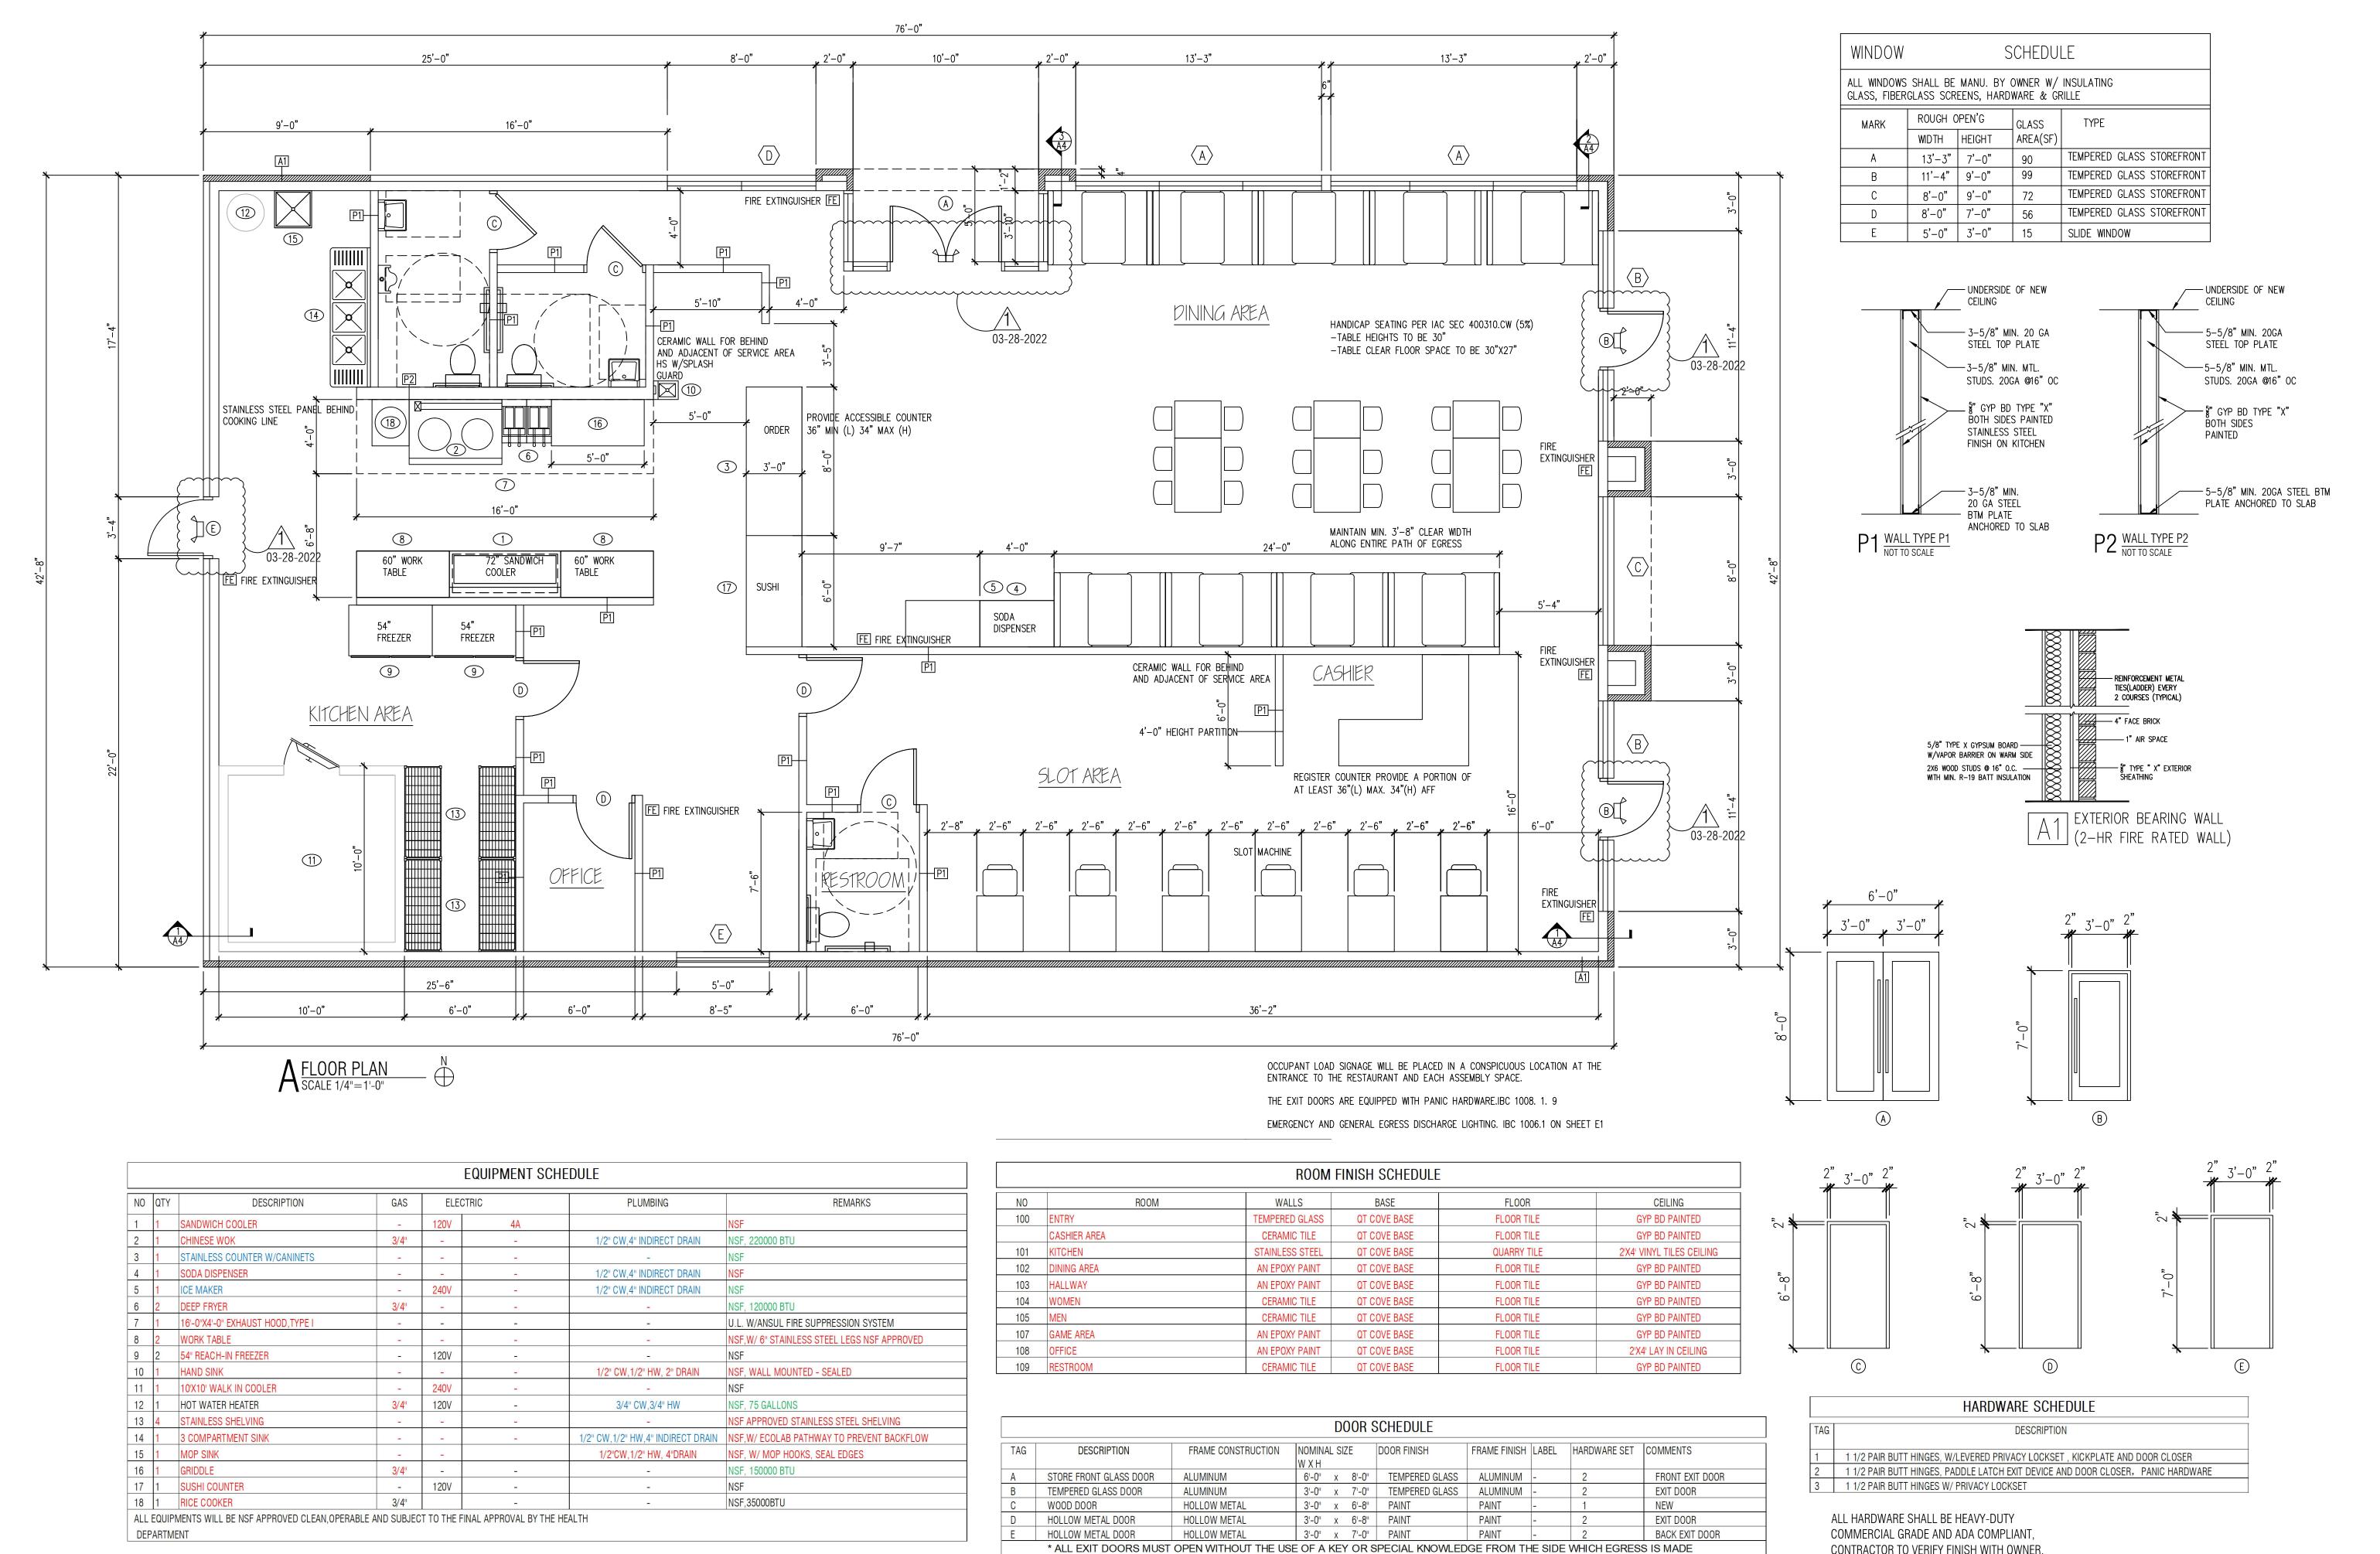

\* LEVERED HANDLE HARDWARE AS REQUIRED BY ILLINOIS ACCESSIBILITY CODE

\* PROVIDE DOOR CLOSERS ALONG ALL ACCESSIBLE ROUTES

WEI TAN 2425 S WENTWORTH AVE. CHICAGO IL 60616

PHONE: (312) 912-5798 EMAIL: twarchitect98@yahoo.com

LICENSE NO: 001-022013 EXPIRES: 11/30/2022

MEP ENGINEER 236 W ALEXANDER STREET CHICAGO IL 60616

PHONE: (312)720-8800
BILLY\_WANG68@HOTMAIL.COM
LICENSE NO: 062.068227
EXPIRES: 11 / 30 /2023


DIRKSEN REALTY LLC BUILD A NEW ONE STORY COMMERCIAL BUILDING 2811 NORTH DIRKSEN PKWY SPRINGFIELD IL 62703

ISSUES	DATE
ISSUED FOR PERMIT	02/08 /2022
REISSUED FOR PERMIT	03/28 /2022




FLOOR PLAN & NOTES




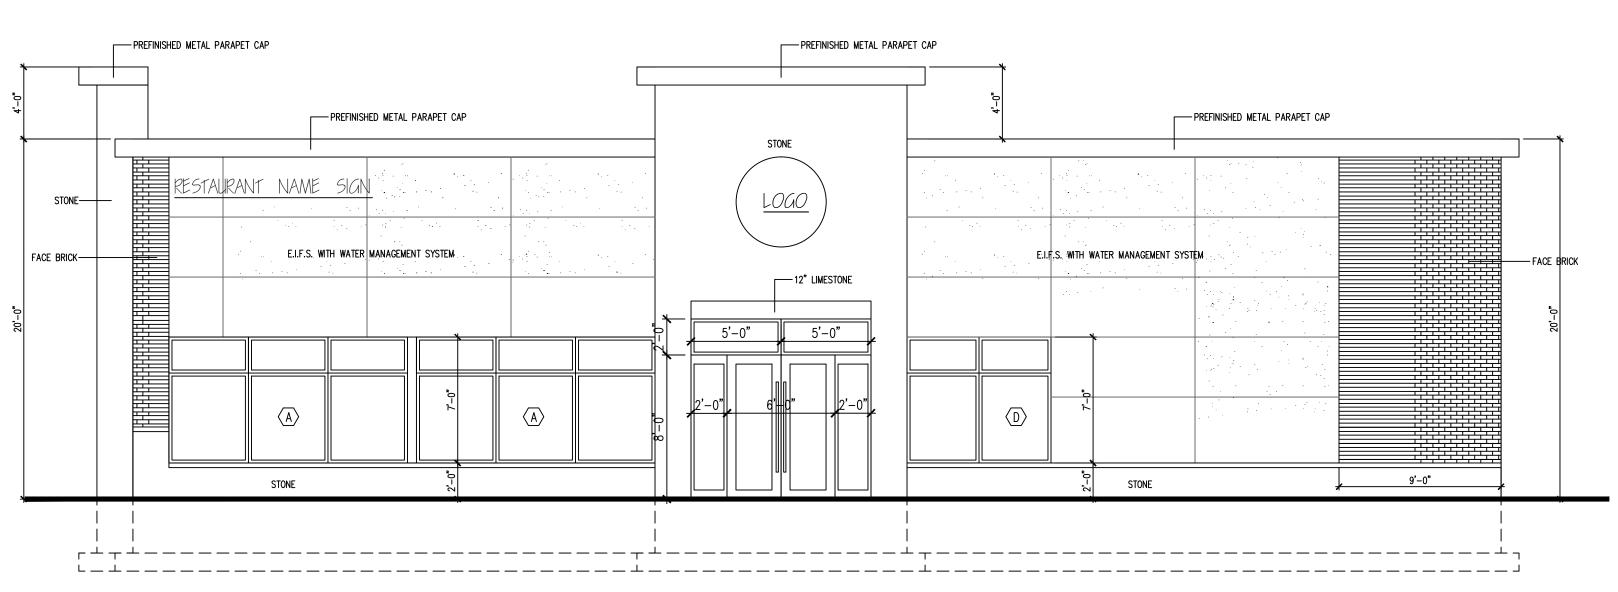


# NORTH ELEVATION SCALE: 4" = 1'-0"

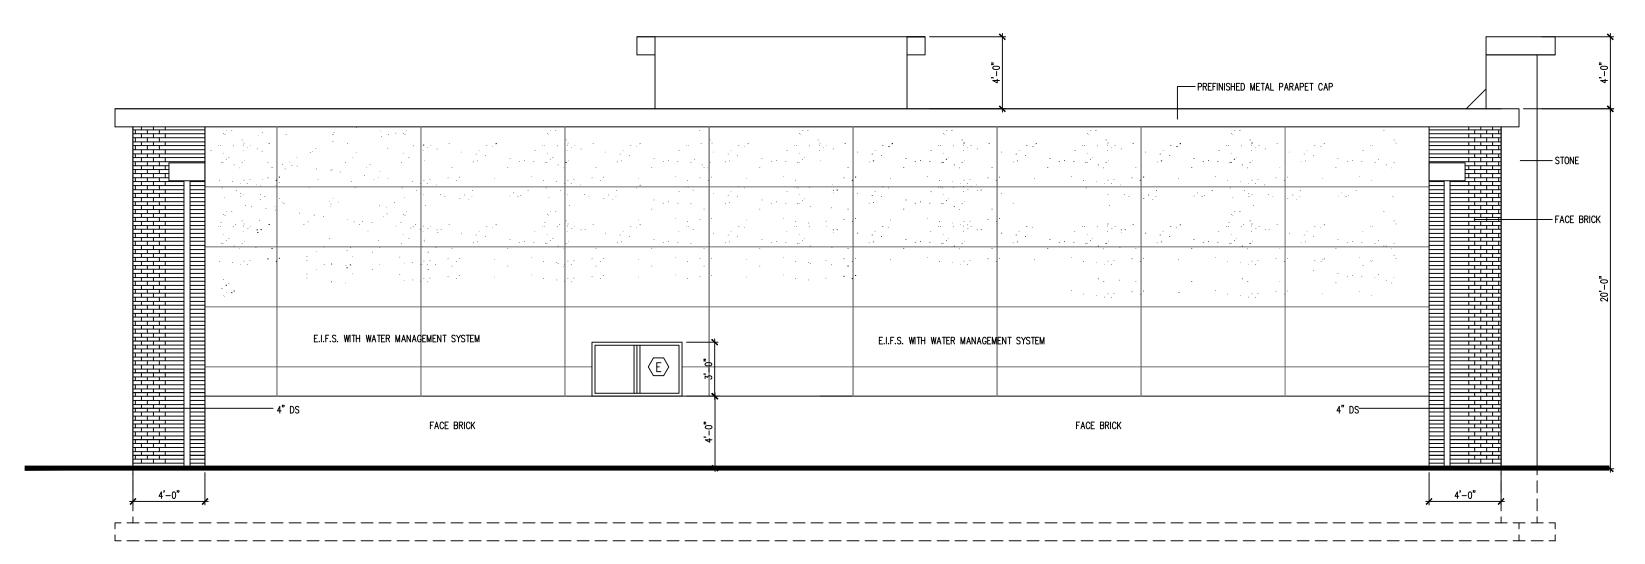


## **SOUTH ELEVATION**

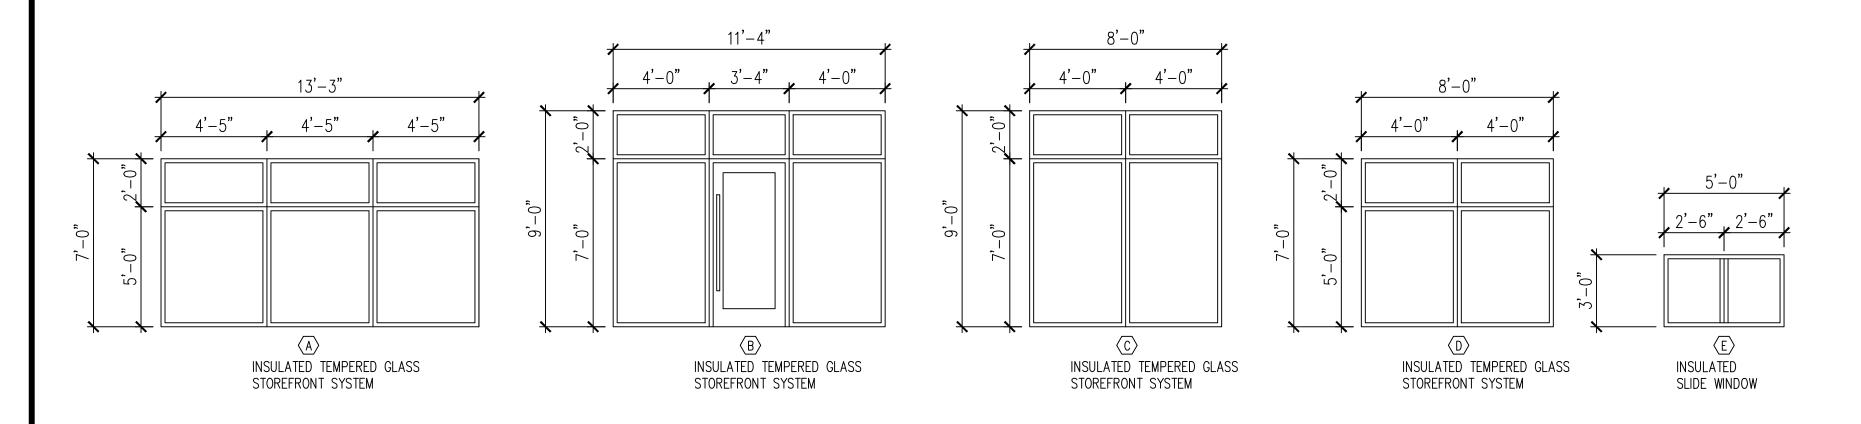

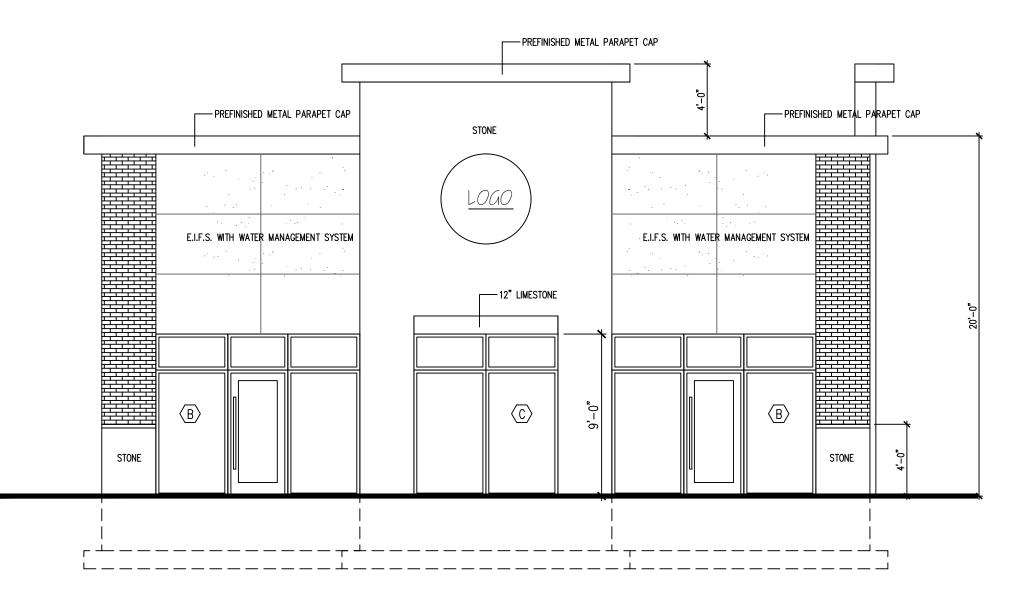

# EAST ELEVATION SCALE: 1" = 1'-0"

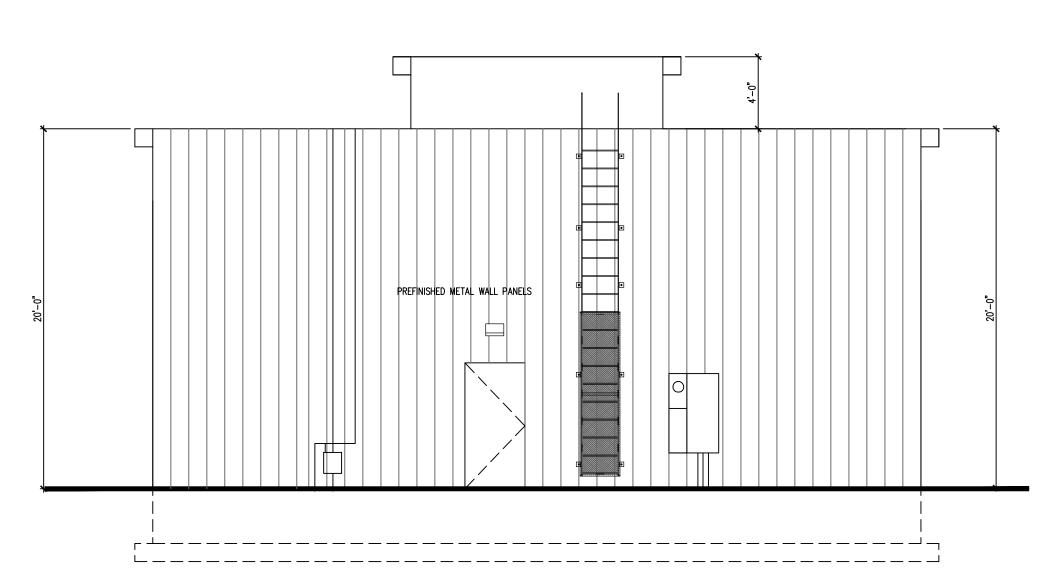

## **WEST ELEVATION**

SCALE:  $\frac{1}{4}$ " = 1'-0"

## E.I.F.S. SPECIFICATIONS

SYSTEM CONSISTING OF, BUT NOT LIMITED TO:

E.P.S. INSULATION BOARD (THICKNESS AS SHOWN) W/ DRAINAGE STRIP

REINFORCING MESH

I.S. REINFORCING MESH

BASE COAT FINISH COAT

PROVIDE VENT ASSEMBLES, CLOSURE BLOCKS, STARTER STRIPS, ETC.

E.I.F.S. SHALL BE INSTALLED IN STRICT ACCORD w/ MANUFACTURER'S SPECIFICATIONS AND INSTALLATION DETAILS. PROVIDE MANUFACTURER'S PERFORMANCE WARRANTY AGAINST WATER INTRUSION THROUGH THE WALL CAVITY AND A (5) YEAR LABOR WARRANTY FROM THE CONTRACTOR. COLOR AND TEXTURE TO BE SELECTED BY THE OWNER.

THE E.I.F.S. SYSTEM WILL BE OF THE WATER-MANAGED VARIETY, AND WILL BE SO DESIGNATED BY THE E.I.F.S. MANUFACTURER. THE WATER-MANAGED E.I.F.S. SYSTEM WILL INCLUDE: MESH REINFORCING AT WALL JOINTS. A WATERPROOFING MEMBRANE APPLIED OVER THE BUILDING VERTICAL GROOVES IN THE POLYSTYRENE OR IN THE ADHESIVE TO CHANNEL WATER TO THE BOTTOM OF THE E.I.F.S. SYSTEM TO ALLOW WATER TO ESCAPE. PROVIDE DRAINAGE CHANNELS ABOVE DOORS AND WINDOWS, AND EXPANSION JOINTS AT DISSIMILAR WALL MATERIALS. THE E.I.F.S. CONTRACTOR WILL BE CERTIFIED BY THE E.I.F.S. MANUFACTURER TO INSTALL A WATER-MANAGED E.I.F.S. SYSTEM, AND THE CONTRACTOR WILL CALL THE CITY BUILDING DEPARTMENT TO SCHEDULE A BUILDING INSPECTION TO OCCUR ON THE DAY THE E.I.F.S. INSTALLATION BEGINS.

2425 S WENTWORTH AVE. CHICAGO IL 60616

PHONE: (312) 912-5798 EMAIL: twarchitect98@yahoo.com

LICENSE NO: 001-022013 EXPIRES: 11/30/2022

MEP ENGINEER 236 W ALEXANDER STREET CHICAGO IL 60616


PHONE: (312)720-8800 BILLY WANG68@HOTMAIL.COM LICENSE NO: 062.068227 EXPIRES: 11 / 30 /2023


BUILD A NEV COMMERCIA 2811 NORTH SPRINGFIE

ISSUES	DATE
ISSUED FOR PERMIT	02/08 /2022
REISSUED FOR PERMIT	03/28 /2022



**ELEVATIONS** 

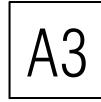

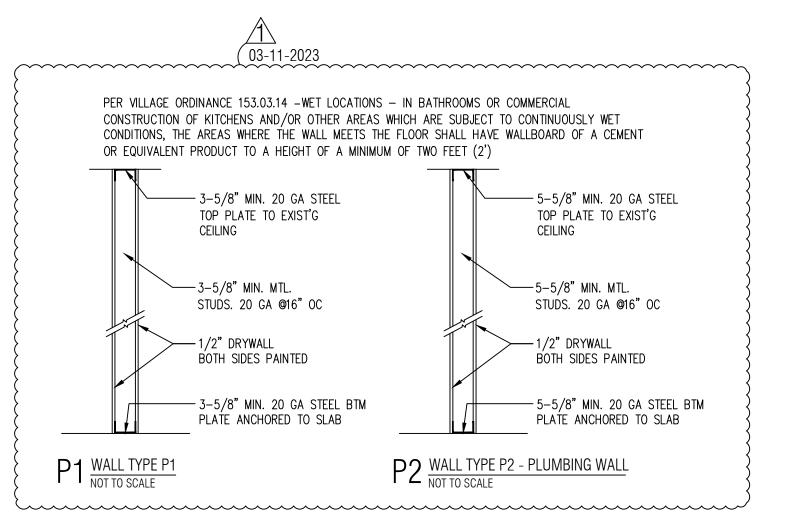

#### KITCHEN EQUIPMENT NOTES

CONTRACTOR SHALL INSTALL AND CONNECT ALL EQUIPMENT AS PER EQUIPMENT SUPPLIER'S SPECIFICATIONS. ALL LOCATIONS TO BE VERIFIED WITH OWNER PRIOR TO INSTALLATION.

PLUMBING CONTRACTOR SHALL PROVIDE ALL ROUGH-INS. INSULATE ALL COLD/HOT WATER PIPES AS REQUIRED. MAINTAIN MIN 36" IN FRONT OF ALL COOKING EQUIPMENT.

ELECTRICAL CONTRACTOR SHALL PROVIDE ALL ELECTRICAL OUTLETS FOR EQUIPMENT. VERIFY ALL ELECTRICAL REQUIREMENTS WITH EQUIPMENT SUPPLIER. VERIFY ALL GAS AND WATER REQUIREMENTS WITH EQUIPMENT SUPPLIER.

ALL PERMANENT EQUIPMENT MUST BE LOCATED SO THAT AREAS BEHIND, UNDERNEATH, AND ON THE SIDES OF THE EQUIPMENT CAN BE EASILY CLEANED.

TWO DRAIN BOARDS ARE REQUIRED AT ALL THREE-COMPARTMENT SINKS ALONG WITH AN APPROPRIATELY SIZED FAUCET, LOCKABLE DRAIN PLUGS, AND AN INDIRECT CONNECTION TO THE SEWER.

#### DRY STORAGE

DRY STORAGE: 25% OF 384SF (KITCHEN AREA.)=96SF REQ'D ACTUAL DRY STORAGE 3X3X4X2+4X4X2=104SF PROVIDED.

ALL FOOD AND FOOD RELATED ITEMS MUST BE STORED OFF THE FLOOR ON DURABLE WASHABLE SHELVES. THE STORAGE AREA MUST BE APPROPRIATELY SIZED BASED ON THE NUMBER OF MEALS SERVED DAILY AND THE NUMBER OF DELIVERIES WEEKLY.

ALL FOOD EQUIPMENT TO BE ON CASTERS, 6" LEGS, OR SEALED TO THE FLOOR FOR EASY CLEANING.

NO RAW WOOD SURFACES PERMITTED ANYWHERE. UNDERSIDES OF COUNTERTOPS, INSIDE OF CABINETRY, AND WATER HEATER PLATFORMS MUST BE SEALED.

- Dial stem thermometers (ranging from 0° to 220°F) are required in all preparation areas.
- Dial stem thermometers (ranging from 0° to 220°F) are required in all preparation are
   Chemical test kits (specific to the sanitizer) are required for the appropriate sanitizer.
- pH meter and log for acidifying rice.
- All cooling/freezing units must have accurate thermometers.
- Covered waste cans are required in all restrooms.
- Toilets, urinals, hand sinks, 3 compartment sinks, mop sink, prep sinks, and permanent counters/cabinets must be sealed to floors and walls with a silicone caulk seal.
- Anti-siphon devices are required on all toilet tanks, urinals, and faucets with hose connections.
- Soap and paper towels are required at all hand sinks.
- Provide hair restraints and disposable gloves for all food handlers.
- If sinks are provided with spring-loaded faucets, the faucets must remain running for a minimum of 15 seconds

Doors leading to the outside and restroom doors are required to be self-closing and tight-fitting. Please confirm that the doors leading to the outside are equipped with a self-closer and weather strips to eliminate any air gaps.

PROVIDE THE FOLLOWING: NSF STAINLESS STEEL OPEN WIRE SHELVING UNITS.


NSF STAINLESS STEEL SHELF OVER 3-COMPTMENT SINK. ICE MAKER A MIN. 8" FROM ALL WALLS.

HEAVY-DUTY MOP RACKS LOCATED OVER MOP SINK.

HEAVY-DUTY BROOM RACKS IN JANITORIAL AREA. METAL GARBAGE CANS WITH LIDS FOR RESTROOMS. SANITARY BOX IN WOMEN'S RESTROOMS. METAL GARBAGE CANS WITH LIDS FOR DIAPER CHANGING STATION.

ALL NSF APPROVED HAND SINKS TO BE WITH BLADE HANDLED FAUCETS.

- BEVERAGE STATION & COUNTER TOP -STAINLESS STEEL
- ALL CABINET SHELVES -STAINLESS STEEL.
- ALL CABINET BASE 6" STAINLESS STEEL LEGS (NO KICK BASE)
  LAVATORY COUNTERTOP TO BE SOLID SURFACE (NO PLASTIC LAMINATE OR CABINETRY)
- ANY PAINTED FINISHES TO BE SEMI-GLOSS OR GLOSS (NO FLAT, NO EGG SHELL, NO TEXTURE),
- PROVIDE TILE ON WALL AND UNDERSIDE OF SERVICE AREA.
- STAINLESS STEEL WALL FINISH FOR BEHIND AND ADJACENT TO COOK LINE

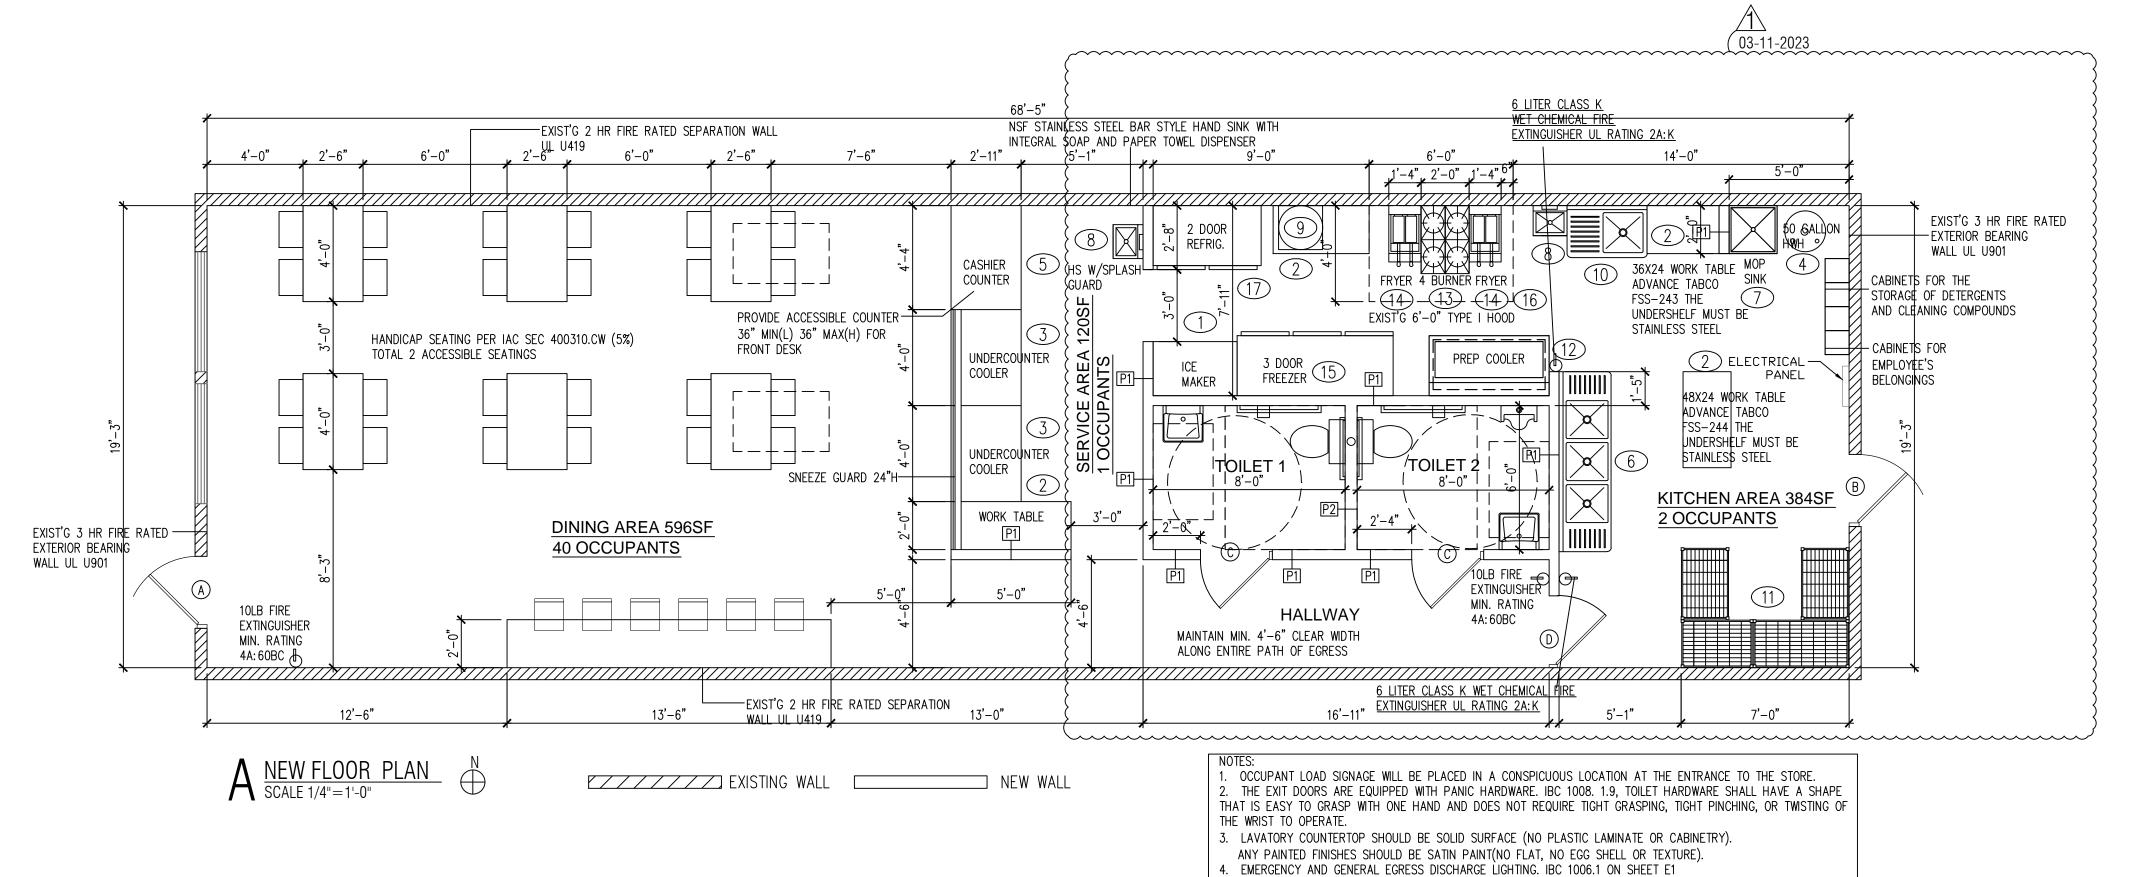

	EQUIPMENT SCHEDULE									
NO	QTY	DESCRIPTION	GAS	ELEC	CTRIC	PLUMBING	REMARKS			
1	1	ICE MAKER		240V	10A	1/2" CW,4" INDIRECT DRAIN	NSF,AIR COOLED CONDENSING UNIT			
2	4	WORK TABLE	-	-	H	=	NSF,W/ 6" STAINLESS STEEL LEGS NSF APPROVED			
3	2	48"X30" UNDERCOUNTER REFRIG.	ı	120V	2.7A	-	NSF			
4	1	50 GAL HWH	3/4"	120V	-	3/4" CW & 3/4" HW	NSF 50000BTU			
5	1	CASHIER COUNTER	ī	-	_	-	NSF			
6	1	3 COMPARTMENT SINK	Ī	-	=	1/2" CW,1/2" HW,4" INDIRECT DRAIN	NSF,W/ ECOLAB PATHWAY TO PREVENT BACKFLOW			
7	1	MOP SINK	1	_		1/2"CW,1/2" HW, 4" DRAIN	NSF, W/ MOP HOOKS, SEAL EDGES			
8	2	HAND SINK	ī	-	=	1/2" CW,1/2" HW, 2" DRAIN	NSF, WALL MOUNTED - SEALED			
9	1	ELECTRIC RICE COOKER	1	120V	4A	9	NSF			
10	1	PREP SINK	I	-	<b>=</b> 3	1/2"CW,1/2" HW, 4" INDIRECT DRAIN	NSF,W/ ECOLAB PATHWAY TO PREVENT BACKFLOW			
11	2	STAINLESS STEEL SHELVING	-		-	-	NSF			
12	1	72" X 30" PREP COOLER	-	120V	4A	H	NSF			
13	1	4 BURNER	3/4"	-	-	-	NSF,147000BTU			
14	2	DEEP FRYER	3/4"	-	-	-	NSF, 110000 BTU			
15	1	3 DOOR FREEZER		120V	4A	-	NSF			
16	1	EXISTING 6'-0" X 4'-0" TYPE I EXHAUST HOOD	=	-	-	-	U.L. W/ ANSUL FIRE SUPPRESSION SYSTEM			
17	1	2 DOOR REFRIG.	=	120V	4A	-	NSF			
ALL	EQUIP	MENTS WILL BE NSF APPROVED CLEAN,OPERAB	LE AND SUE	BJECT TO T	HE FINAL APPROVAL BY T	THE HEALTH				
DEF	ARTM	ENT								

	ROOM FINISH SCHEDULE									
NO	ROOM	WALLS	BASE	FLOOR	CEILING					
100	DINING AREA	GYP BD PAINTED	QT COVE BASE	FLOOR TILE	OPEN CEILING					
101	SERVICE AREA	CERAMIC TILE	QT COVE BASE	QUARRY TILE	2X2 VINYL TILE CEILING					
102	KITCHEN	STAINLESS STEEL	QT COVE BASE	QUARRY TILE	2X2 VINYL TILE CEILING					
103	TOILET 1	CERAMIC TILE	CERAMIC TILE	FLOOR TILE	2X2 VINYL TILE CEILING					
104	TOILET 2	CERAMIC TILE	CERAMIC TILE	FLOOR TILE	2X2 VINYL TILE CEILING					
105	HALLWAY	GYP BD PAINTED	QT COVE BASE	FLOOR TILE	OPEN CEILING					

				D	00R	SCHEDULE							
TAG	DESCRIPTION	FRAME CONSTRUCTION	NOMINA W X H	L SI	ZE	DOOR FINISH	FRAME FINISH	LABEL	HARDWARE SET	COMMENTS			
Α	STORE FRONT GLASS DOOR	ALUMINUM		X	7'-0"	TEMPERED GLASS	ALUMINUM	-	3	EXIST'G FRONT EXIT DOOR			
В	METAL DOOR	HOLLOW METAL	3'-0"	X	7'-0"	PAINT	PAINT	_	3	EXIST'G			
С	WOOD DOOR	HOLLOW METAL	3'-0"	X	6'-8"	PAINT	PAINT	-	2	NEW			
D	WOOD DOOR	HOLLOW METAL	3'-0"	Χ	6'-8"	PAINT	PAINT	_	1	NEW			
	* ALL EXIT DOORS MUST OPEN WITHOUT THE USE OF A KEY OR SPECIAL KNOWLEDGE FROM THE SIDE WHICH EGRESS IS MADE												
	* LEVERED HANDLE HARD	WARE AS REQUIRED BY	* LEVERED HANDLE HARDWARE AS REQUIRED BY ILLINOIS ACCESSIBILITY CODE										

Exposed and concealed insulation shall have a flame spread index of not more than 25 and a smoke development index of not more than 450

wall and or Ceiling Finishes meet the Fire Performance and Smoke Development requirements of the IBC section 803 (IBC 801.2). Interior Exit Passageway

in a non-sprinklered B use must be Class A when tested in accordance with ASTM E84 of UL 723.

The Means of Egress, including the Exit Discharge, shall be illuminated at all times the building is occupied (IBC 1006.1).

. Ground and floor surfaces a long accessible routes cannot have changes in level over X" and be vertical (IAC 400.310.a.7). Indicated on Al,Room Finish Schedule, please verify that the transition from floor tile finish to hardwood finish does not exceed X" vertically.

	HARDWARE SCHEDULE									
TAG	DESCRIPTION									
1	1 1/2 PAIR BUTT HINGES, W/ SELF CLOSING DEVICE									
2	1 1/2 PAIR BUTT HINGES, SELF CLOSING DEVICE, ACCESSIBLE HARDWARE									
3	1 1/2 PAIR BUTT HINGES, EXIT DEVICE AND DOOR CLOSER & PANIC HARDWARE									

\* PROVIDE DOOR CLOSERS ALONG ALL ACCESSIBLE ROUTES

2425 S WENTWORTH AVE CHICAGO IL 60616

Phone: (312) 912-5798

Email: twarchitect98@yahoo.com
LICENSE NO: 001-022013

EXPIRES: 11/30/2024


INTERIOR REMODELING

ISSUES DATE
ISSUED FOR PERMIT 02/28/2023
REISSUED FOR PERMIT 03/11/2023



FLOOR PLANS &



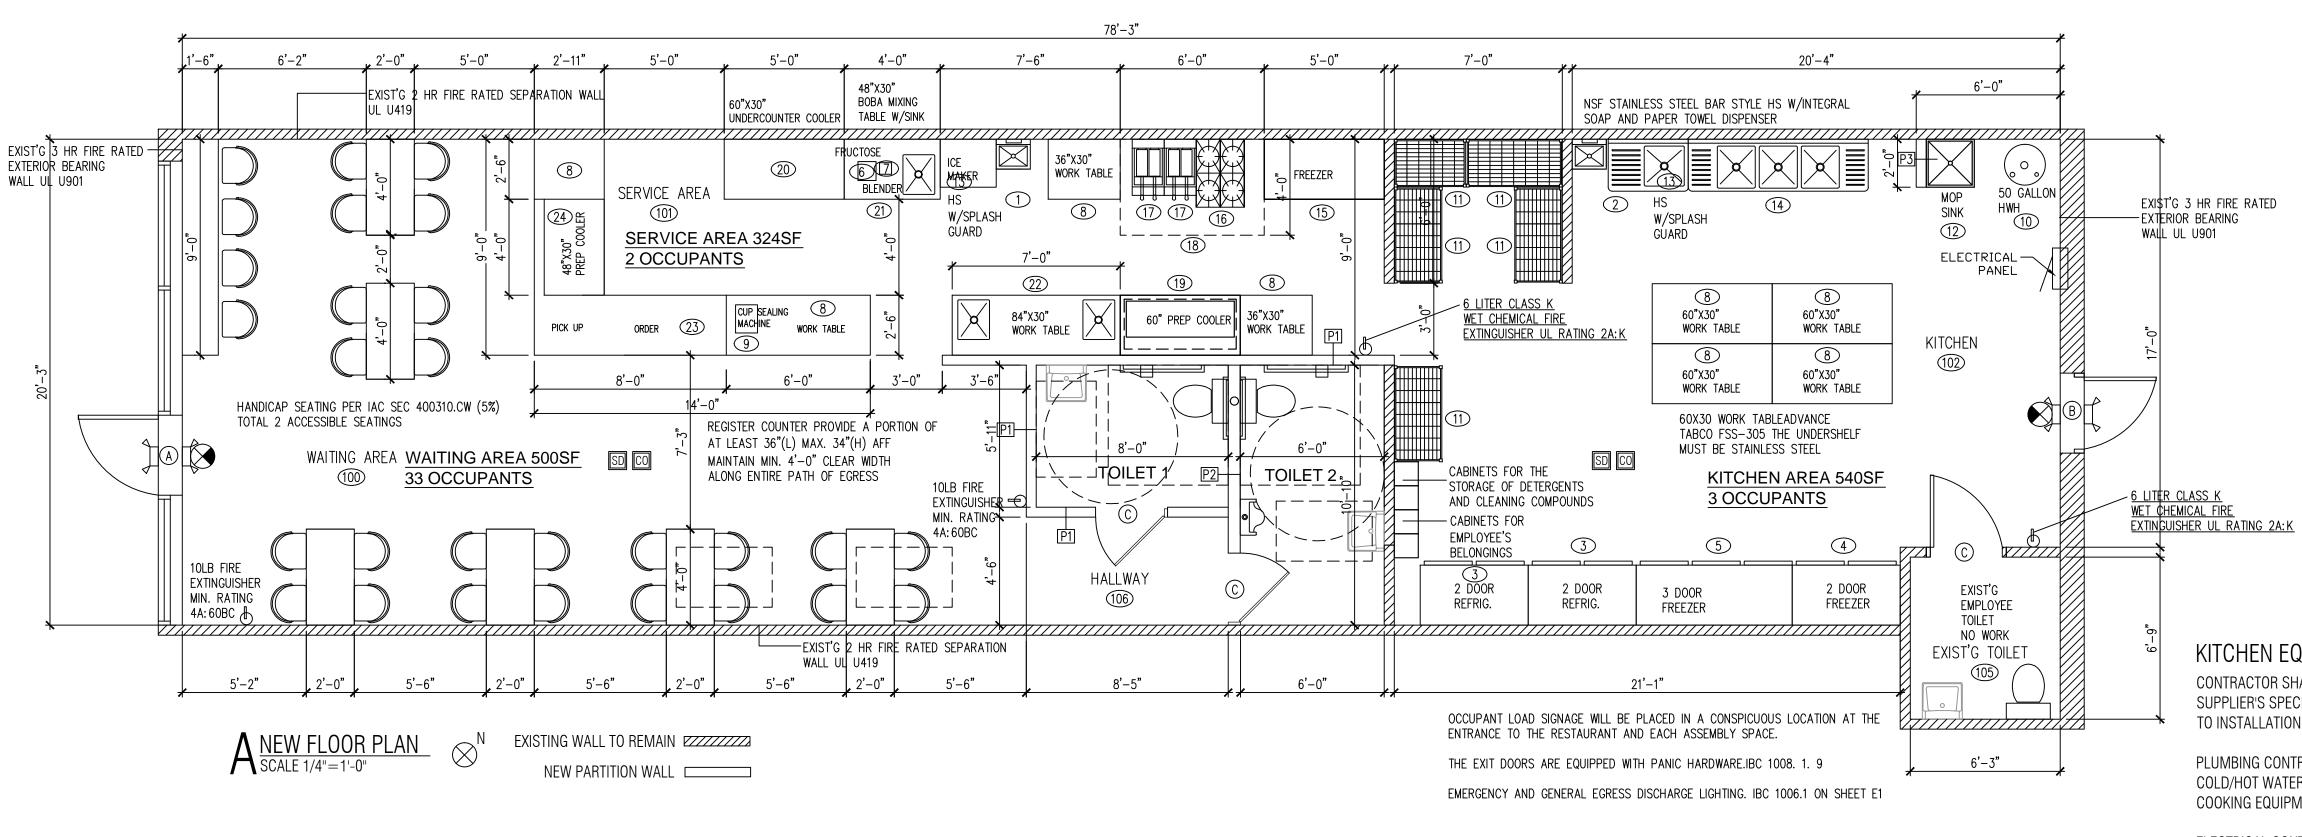

			I	EQUIPMENT SC	HEDULE	
NO	QTY DESCRIPTION	GAS	ELECT	TRIC	PLUMBING	REMARKS
1	1 ICE MAKER	-	240V	10A	1/2" CW, 4" INDIRECT DRAIN	NSF,AIR COOLED CONDENSING UNIT
2	1 1 COMPARTMENT SINK	-	=	÷	1/2" CW,1/2" HW,4" INDIRECT DRAIN	NSF,W/ ECOLAB PATHWAY TO PREVENT BACKFLOW
3	2 2 DOOR REFRIG.	-	120V	5A	-	NSF
4	1 2 DOOR FREEZER	_	120V	5A	-	NSF
5	1 3 DOOR FREEZER	-	240V	6A	-	NSF
6	1 FRUCTOSE	_	-	=	-	NSF
7	1 BLENDER	-	120V	2A	-	NSF
8	8 WORK TABLE	-	-	-	-	NSF,W/ 6" STAINLESS STEEL LEGS NSF APPROVED
9	1 CUP SEALING MACHINE	_	120V	2A	_	NSF
10	1 HOT WATER HEATER	3/4"	120V	-	3/4" CW & 3/4" HW	NSF, 50GALLONS
11	5 SHELVING	=	=	=	Ε	NSF APPROVED STAINLESS STEEL SHELVING
12	1 MOP SINK	_	-		1/2"CW,1/2" HW, 4" DRAIN	NSF, W/ MOP HOOKS, SEAL EDGES
13	2 HAND SINK	_	-	=	1/2" CW,1/2" HW, 2" DRAIN	NSF, WALL MOUNTED - SEALED
14	1 3 COMPARTMENT SINK	_	-	-	1/2" CW,1/2" HW,4" INDIRECT DRAIN	NSF,W/ ECOLAB PATHWAY TO PREVENT BACKFLOW
15	1 60" X 30" FREEZER	_	120V	5A	-	NSF
16	1 GAS STOCK POT BURNER	3/4"	_	-	_	NSF, 160000 BTU
17	2 DEEP FRYER	3/4"	-	-	-	NSF, 120000 BTU
18	1 6'-0" X 4'-0" TYPE I EXHAUST HOOD	-	-	-	*	U.L. W/ ANSUL FIRE SUPPRESSION SYSTEM
19	1 PREP COOLER	-	120V	4A	-	NSF
20	1 UNTERCOUNTER COOLER	_	120V	4A	-	NSF
21	1 48" X 30" BOBA MIXING TABLE W/SINK	_	-	-	1/2"CW,1/2" HW, 4" INDIRECT DRAIN	NSF
22	1 84" X 30" WORK TABLE W/SINK	_	-	-	1/2"CW,1/2" HW, 4" INDIRECT DRAIN	NSF
23	1 CASHIER COUNTER	_	-	-	-	NSF
24	1 PREP COOLER	-	120V	3A	-	NSF

	ROOM FINISH SCHEDULE											
NO	ROOM	WALLS	BASE	FLOOR	CEILING							
100	WAITING AREA	GYP. BD. PAINTED	QT COVE BASE	FLOOR TILE	OPEN CEILING							
101	SERVICE AREA	CERAMIC TILE	QT COVE BASE	QUARRY TILE	OPEN CEILING							
102	KITCHEN	STAINLESS STEEL	QT COVE BASE	QUARRY TILE	2X4 VINYL TILE CEILING							
103	NEW TOILET1	CERAMIC TILE	QT COVE BASE	FLOOR TILE	EXIST'G CEILING							
104	NEW TOILET2	CERAMIC TILE	QT COVE BASE	FLOOR TILE	EXIST'G CEILING							
105	EXIST'G TOILET	CERAMIC TILE	QT COVE BASE	FLOOR TILE	EXIST'G CEILING							
106	HALLWAY	GYP. BD. PAINTED	QT COVE BASE	FLOOR TILE	OPEN CEILING							

DEPARTMENT


	DOOR SCHEDULE									
TAG	DESCRIPTION	FRAME CONSTRUCTION	NOMIN/	AL SI	ZE	DOOR FINISH	FRAME FINISH	LABEL	HARDWARE SET	COMMENTS
			WXH							
Α	STORE FRONT GLASS DOOR	ALUMINUM	3'-0"	X	7'- <mark>0</mark> "	TEMPERED GLASS	ALUMINUM	L	3	EXIST'G
В	HOLLOW METAL DOOR	PRE-HUNG METAL	3'-0"	X	7'- <mark>0"</mark>	PAINT	PAINT	Ţ	3	EXIST'G
С	WOOD DOOR	HOLLOW METAL	3'-0"	X	6'-8"	PAINT	PAINT	Ī	2	NEW
	* ALL EXIT DOORS MUST OPEN WITHOUT THE USE OF A KEY OR SPECIAL KNOWLEDGE FROM THE SIDE WHICH EGRESS IS MADE									
	* LEVERED HANDLE HARDW	ARE AS REQUIRED E	Y ILLII	NOIS	S ACC	ESSIBILITY CODE				

TAG DESCRIPTION

1 1 1/2 PAIR BUTT HINGES, W/ PRIVACY LOCKSET
2 1 1/2 PAIR BUTT HINGES, W/LEVERED PRIVACY LOCKSET, KICKPLATE AND DOOR CLOSER
3 1 1/2 PAIR BUTT HINGES, PADDLE LATCH EXIT DEVICE AND DOOR CLOSER, PANIC HARDWARE

\* PROVIDE DOOR CLOSERS ALONG ALL ACCESSIBLE ROUTES

PER VILLAGE ORDINANCE 153.03.14 -WET LOCATIONS - IN BATHROOMS OR COMMERCIAL CONSTRUCTION OF KITCHENS AND/OR OTHER AREAS WHICH ARE SUBJECT TO CONTINUOUSLY WET CONDITIONS, THE AREAS WHERE THE WALL MEETS THE FLOOR SHALL HAVE WALLBOARD OF A CEMENT OR EQUIVALENT PRODUCT TO

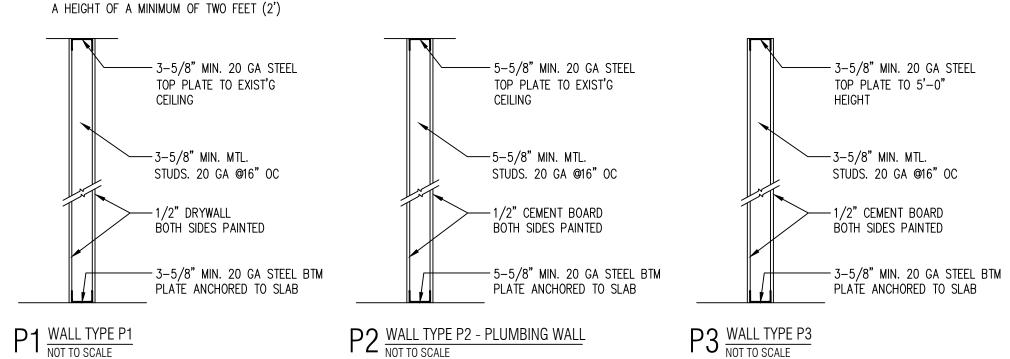

CONTRACTOR SHALL INSTALL AND CONNECT ALL EQUIPMENT AS PER EQUIPMENT SUPPLIER'S SPECIFICATIONS. ALL LOCATIONS TO BE VERIFIED WITH OWNER PRIOR TO INSTALLATION.

KITCHEN EQUIPMENT NOTES

PLUMBING CONTRACTOR SHALL PROVIDE ALL ROUGH-INS. INSULATE ALL COLD/HOT WATER PIPES AS REQUIRED. MAINTAIN MIN 36" IN FRONT OF ALL COOKING EQUIPMENT.

ELECTRICAL CONTRACTOR SHALL PROVIDE ALL ELECTRICAL OUTLETS FOR EQUIPMENT. VERIFY ALL ELECTRICAL REQUIREMENTS WITH EQUIPMENT SUPPLIER. VERIFY ALL GAS AND WATER REQUIREMENTS WITH EQUIPMENT SUPPLIER.

ALL PERMANENT EQUIPMENT MUST BE LOCATED SO THAT AREAS BEHIND, UNDERNEATH, AND ON THE SIDES OF THE EQUIPMENT CAN BE EASILY CLEANED.

TWO DRAIN BOARDS ARE REQUIRED AT ALL THREE-COMPARTMENT SINKS ALONG WITH AN APPROPRIATELY SIZED FAUCET, LOCKABLE DRAIN PLUGS, AND AN INDIRECT CONNECTION TO THE SEWER.

#### DRY STORAGE

DRY STORAGE: 25% OF 540SF (KITCHEN AREA.)=135SF REQ'D ACTUAL DRY STORAGE 152SF PROVIDED.

4 SHELVINGS X 4X4X2 = 128 + 3X4X2 = 152SF

ALL FOOD AND FOOD RELATED ITEMS MUST BE STORED OFF THE FLOOR ON DURABLE WASHABLE SHELVES. THE STORAGE AREA MUST BE APPROPRIATELY SIZED BASED ON THE NUMBER OF MEALS SERVED DAILY AND THE NUMBER OF DELIVERIES WEEKLY.

ALL FOOD EQUIPMENT TO BE ON CASTERS, 6" LEGS, OR SEALED TO THE FLOOR FOR EASY CLEANING.

NO RAW WOOD SURFACES PERMITTED ANYWHERE. UNDERSIDES OF COUNTERTOPS, INSIDE OF CABINETRY, AND WATER HEATER PLATFORMS MUST BE SEALED.

WEI TAN 2425 S WENTWORTH AVE CHICAGO IL 60616

Phone: (312) 912-5798

Email: twarchitect98@yahoo.com

LICENSE NO: 001-022013 EXPIRES: 11/30/2024


NTERIOR REMODELING


IUUULU	DATE
ISSUED FOR PERMIT	03/18/2023



FLOOR PLAN & NOTES



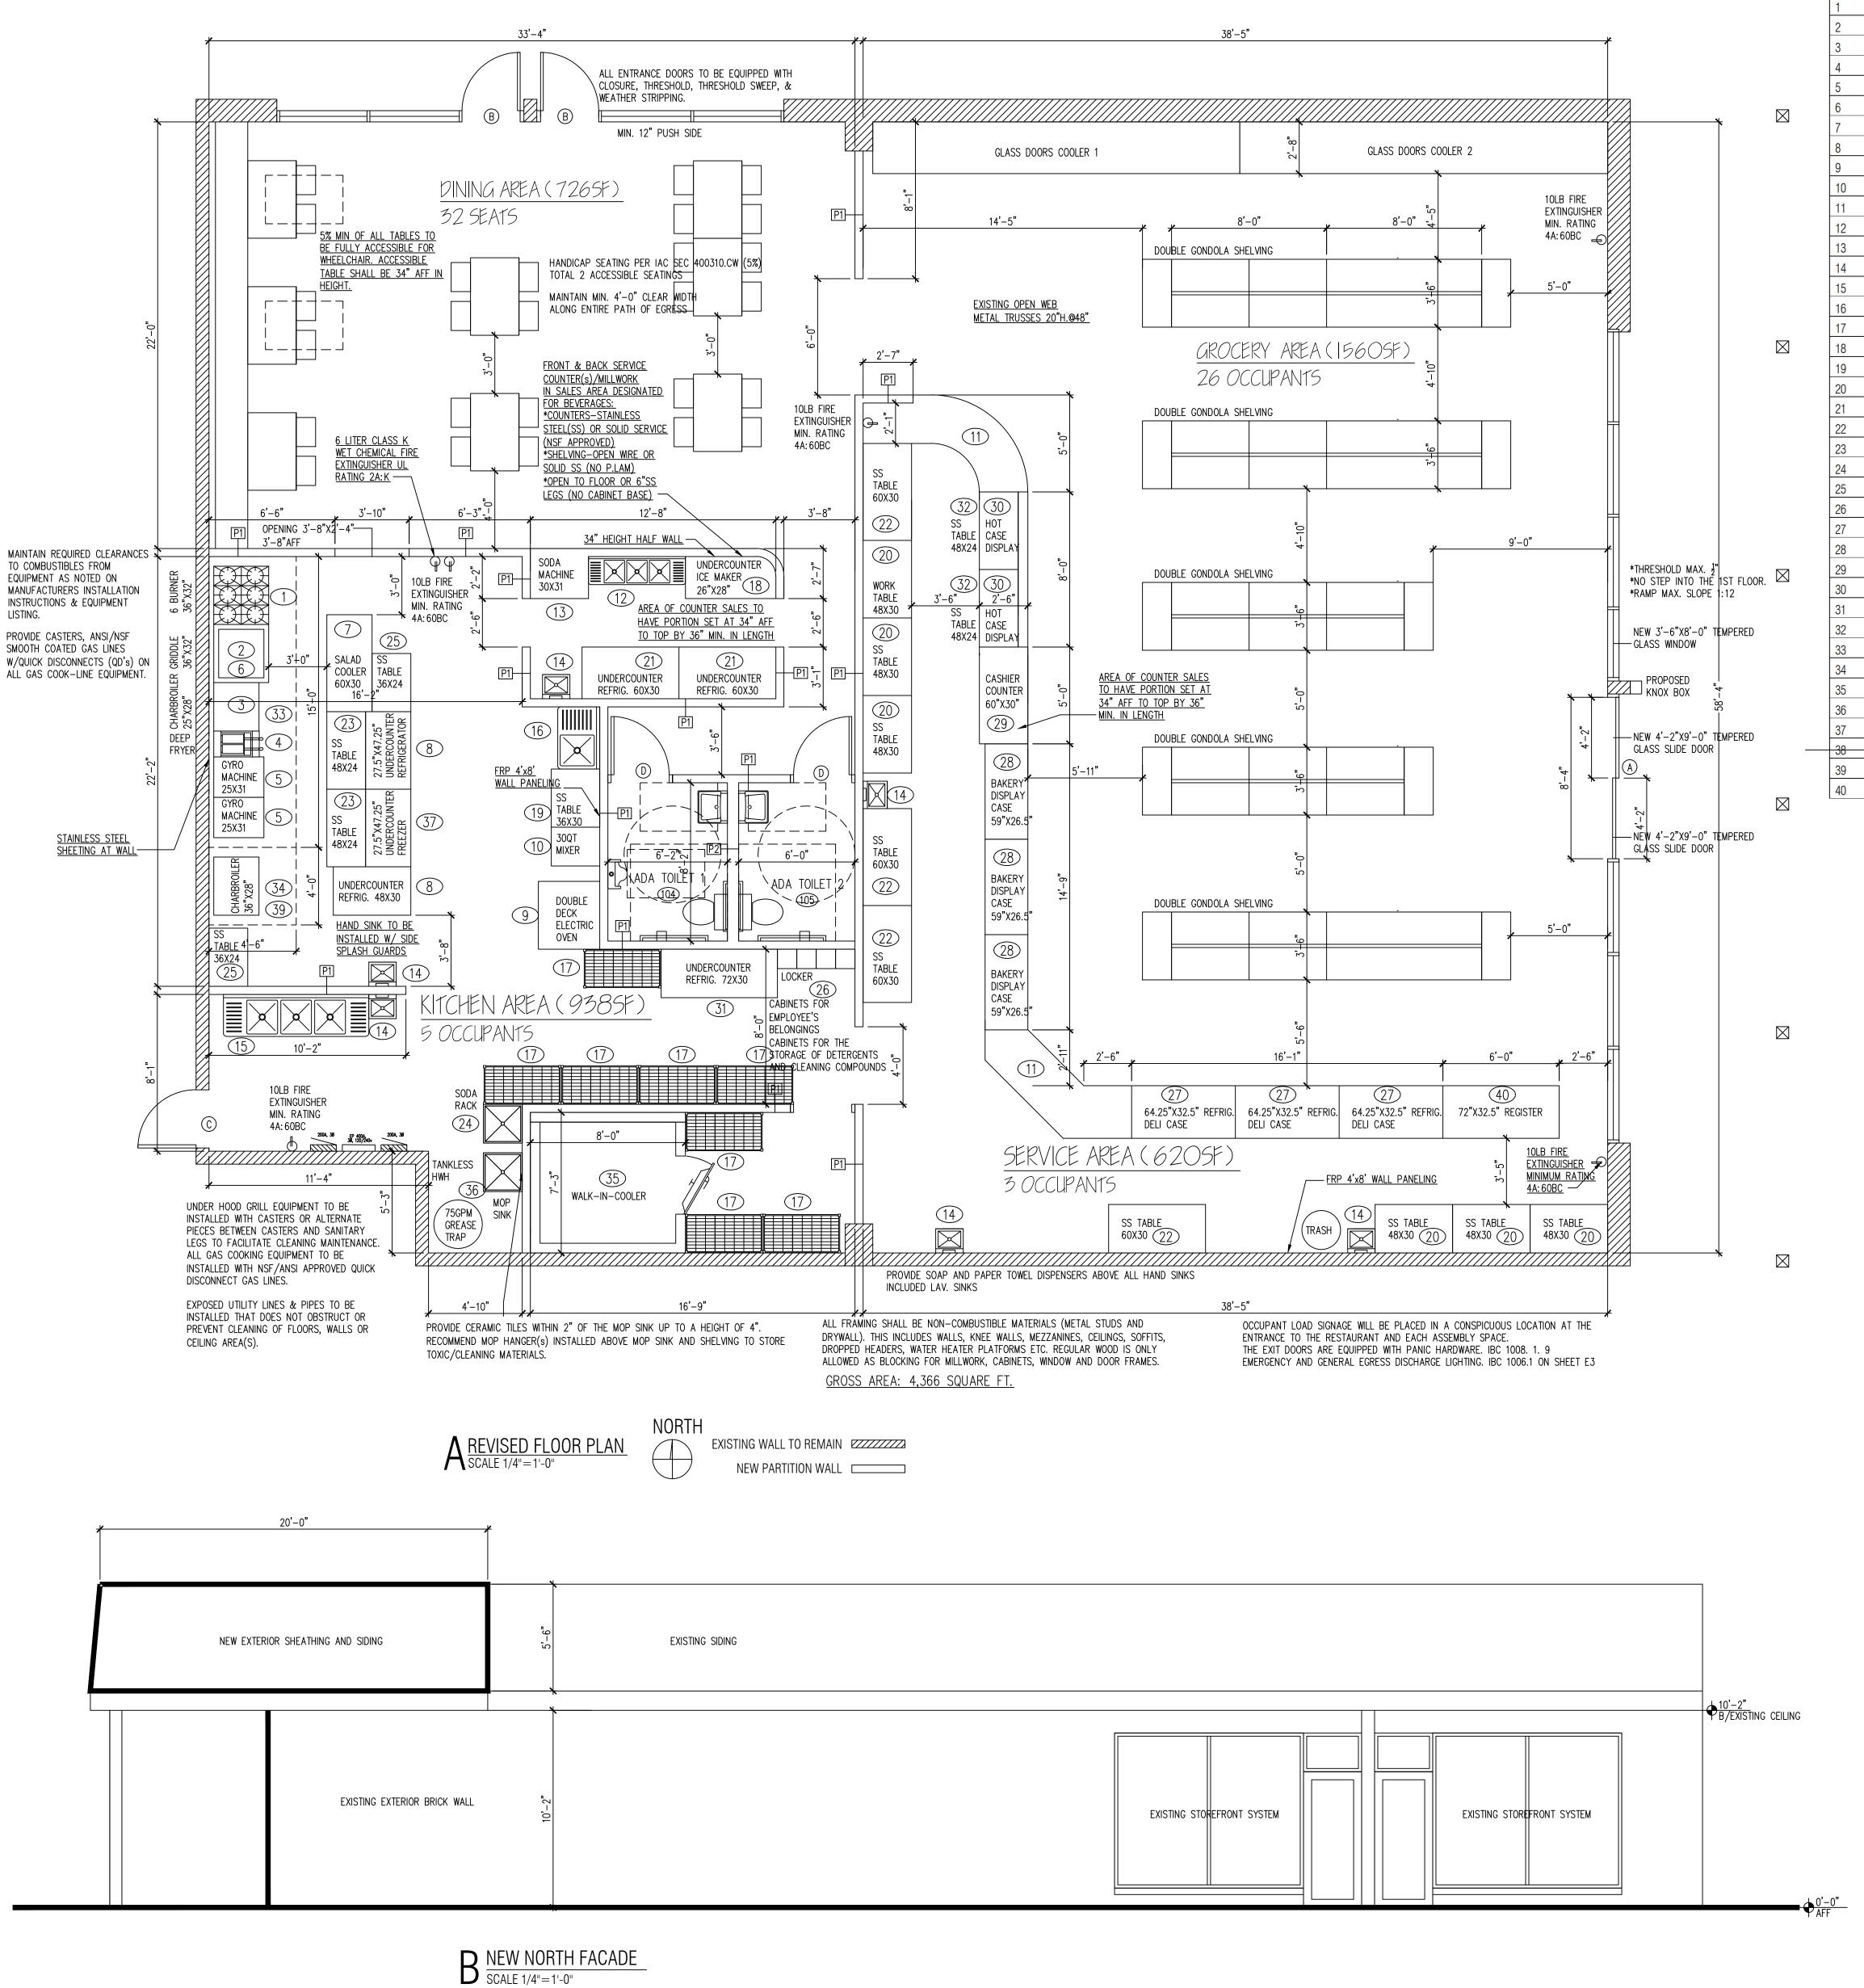

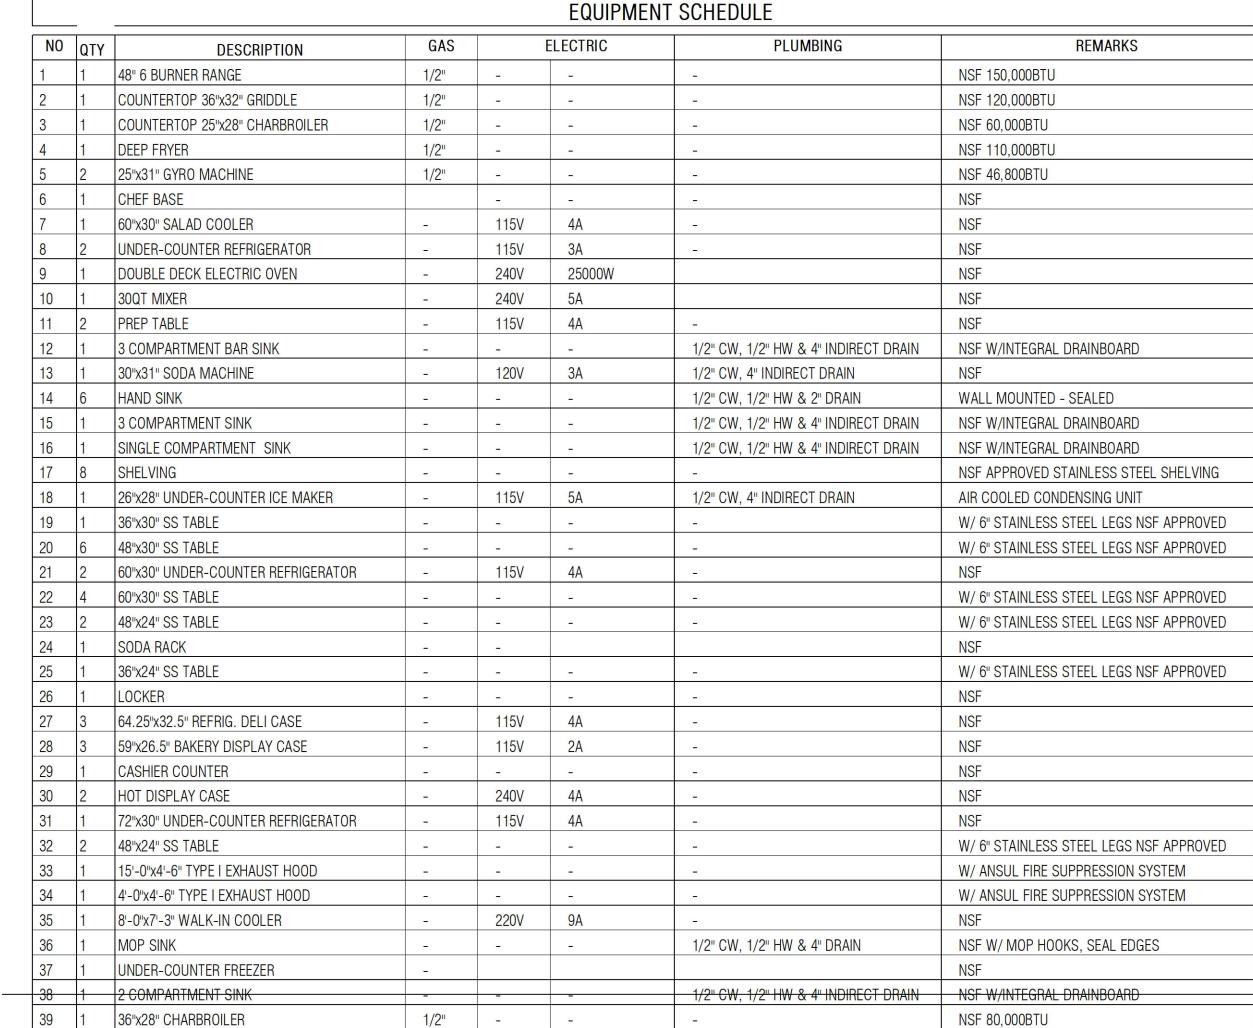

COOKLINE EQUIPMENT AND REACH-IN REFRIGERATION AND FREEZER UNITS TO BE INSTALLED ON CASTERS. PROVIDE THE FOLLOWING: NSF STAINLESS STEEL OPEN WIRE SHELVING UNITS IN STORAGE ROOM. NSF STAINLESS STEEL SHELF OVER 3-COMPTMENT SINK. HEAVY-DUTY MOP RACKS LOCATED OVER MOP SINK. HEAVY-DUTY BROOM RACKS IN JANITORIAL AREA. METAL GARBAGE CANS WITH LIDS FOR RESTROOMS. SANITARY BOX IN WOMEN'S RESTROOMS. METAL GARBAGE CANS WITH LIDS FOR DIAPER CHANGING STATION.

ALL NSF APPROVED HAND SINKS TO BE WITH BLADE HANDLED FAUCETS. BEVERAGE STATION & COUNTER TOP -STAINLESS STEEL ALL CABINET SHELVES -STAINLESS STEEL. ALL CABINET BASE - 6" STAINLESS STEEL LEGS (NO KICK BASE) LAVATORY COUNTERTOP TO BE SOLID SURFACE (NO PLASTIC LAMINATE OR CABINETRY) ANY PAINTED FINISHES TO BE SEMI-GLOSS OR GLOSS (NO FLAT, NO EGG SHELL, NO TEXTURE), PROVIDE FRP ON WALL AND SERVICE AREA.

STAINLESS STEEL WALL FINISH FOR BEHIND AND ADJACENT TO COOK LINE

FIRE EXTINGUISHERS TO BE TYPE K IN KITCHEN AND TYPE A IN DINING ROOM

KITCHEN EQUIPMENT NOTES

CONTRACTOR SHALL INSTALL AND CONNECT ALL EQUIPMENT AS PER EQUIPMENT SUPPLIER'S SPECIFICATIONS. ALL LOCATIONS TO BE VERIFIED WITH OWNER PRIOR TO INSTALLATION.

PLUMBING CONTRACTOR SHALL PROVIDE ALL ROUGH-INS. INSULATE ALL COLD/HOT WATER PIPES AS REQUIRED. MAINTAIN MIN 36" IN FRONT OF ALL COOKING EQUIPMENT.

ELECTRICAL CONTRACTOR SHALL PROVIDE ALL ELECTRICAL OUTLETS FOR EQUIPMENT. VERIFY ALL ELECTRICAL REQUIREMENTS WITH EQUIPMENT SUPPLIER. VERIFY ALL GAS AND WATER REQUIREMENTS WITH EQUIPMENT SUPPLIER.

ALL PERMANENT EQUIPMENT MUST BE LOCATED SO THAT AREAS BEHIND,

UNDERNEATH, AND ON THE SIDES OF THE EQUIPMENT CAN BE EASILY CLEANED.

TWO DRAIN BOARDS ARE REQUIRED AT ALL THREE-COMPARTMENT SINKS ALONG WITH AN APPROPRIATELY SIZED FAUCET, LOCKABLE DRAIN PLUGS, AND AN INDIRECT CONNECTION TO THE SEWER.


DRY STORAGE: 25% OF 938 SF (KITCHEN AREA.)=234SF REQ'D ACTUAL DRY STORAGE 8X4X4X2 = 256SF PROVIDED.

ALL FOOD AND FOOD RELATED ITEMS MUST BE STORED OFF THE FLOOR ON DURABLE WASHABLE SHELVES. THE STORAGE AREA MUST BE APPROPRIATELY SIZED BASED ON THE NUMBER OF MEALS SERVED DAILY AND THE NUMBER OF DELIVERIES WEEKLY.

ALL FOOD EQUIPMENT TO BE ON CASTERS, 6" LEGS, OR SEALED TO THE FLOOR FOR EASY CLEANING.

NO RAW WOOD SURFACES PERMITTED ANYWHERE. UNDERSIDES OF COUNTERTOPS, INSIDE OF CABINETRY, AND WATER HEATER PLATFORMS MUST BE SEALED.

Doors leading to the outside and restroom doors are required to be self-closing and tight-fitting. Please confirm that the doors leading to the outside are equipped with a self-closer and weather strips to eliminate any air gaps.

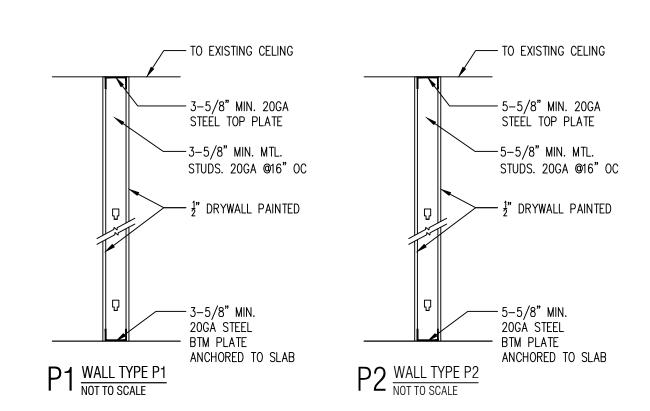

WEI TAN 2425 S WENTWORTH AVE CHICAGO IL 60616

Phone: (312) 912-5798 Email: twarchitect98@yahoo.com

LICENSE NO: 001-022013 EXPIRES: 11/30/2024

MEP ENGINEER 236 W ALEXANDER STREET CHICAGO IL 60616

NSF


PHONE: (312)720-8800 LICENSE NO: 062.068227


BILLY WANG68@HOTMAIL.COM EXPIRES: 11 / 30 /2023

SUED FOR PERMIT



FLOOR PLAN, NOTES, & SCHEDULES

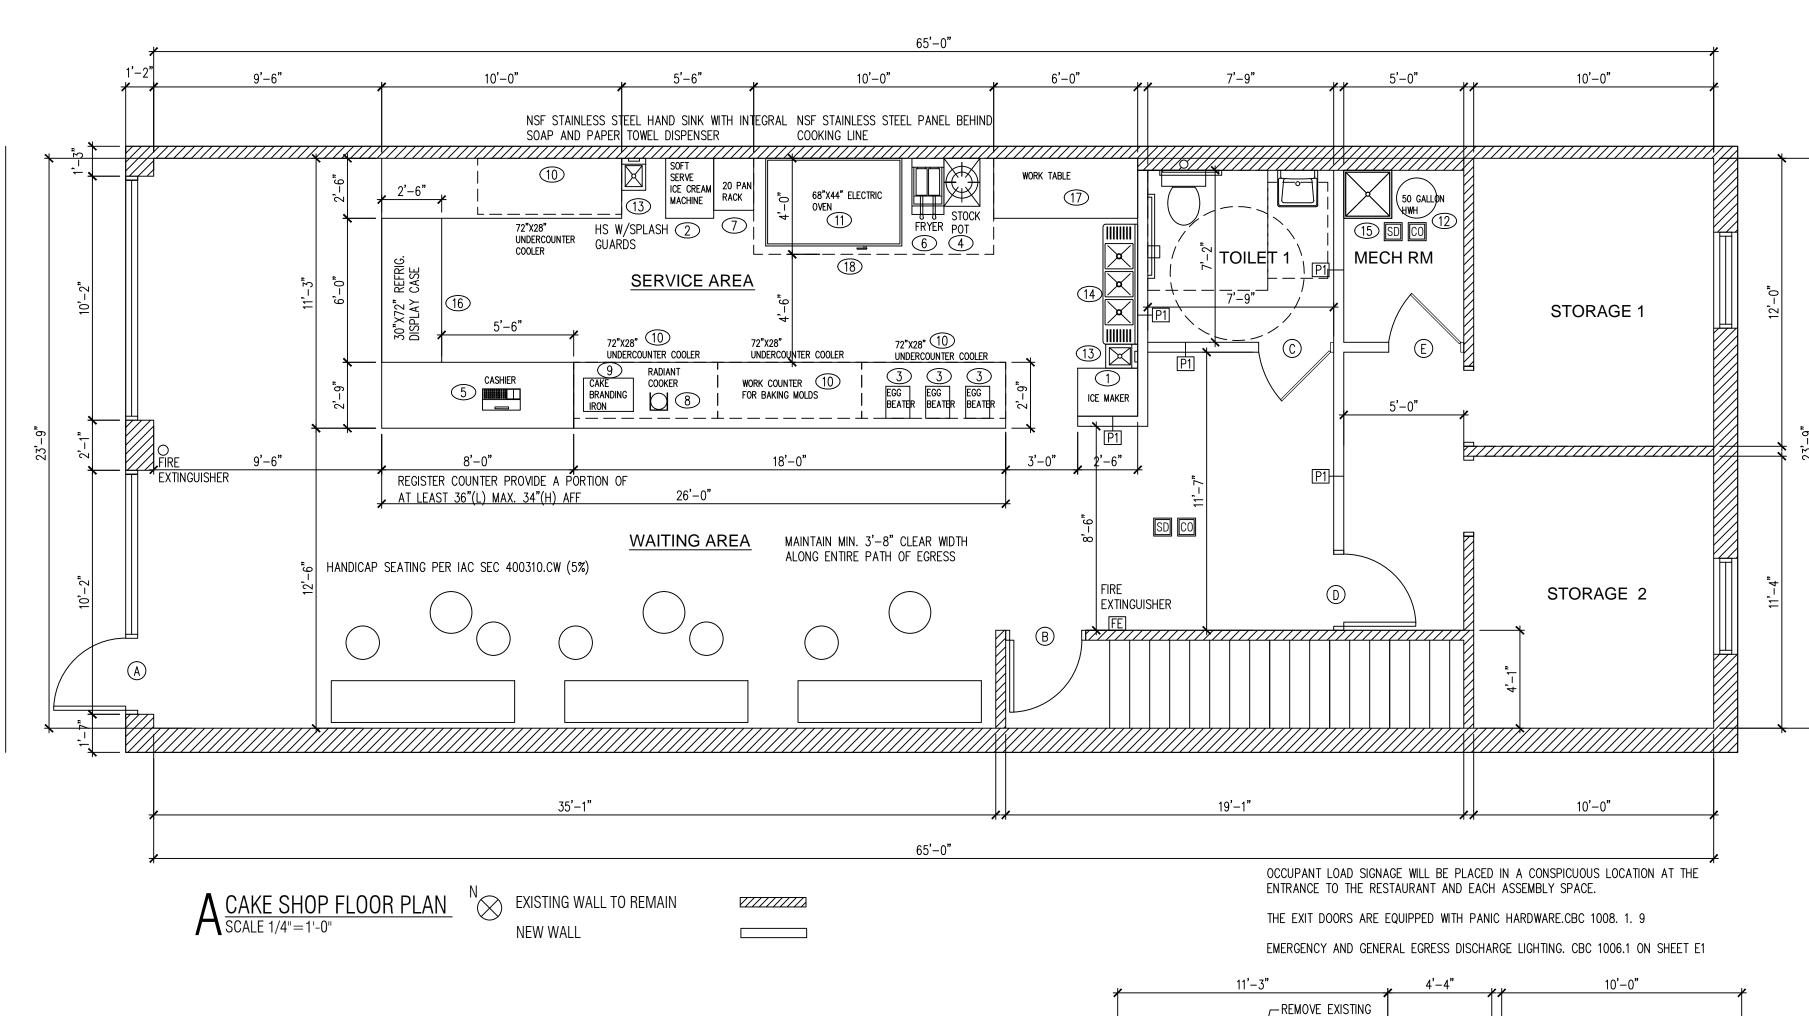

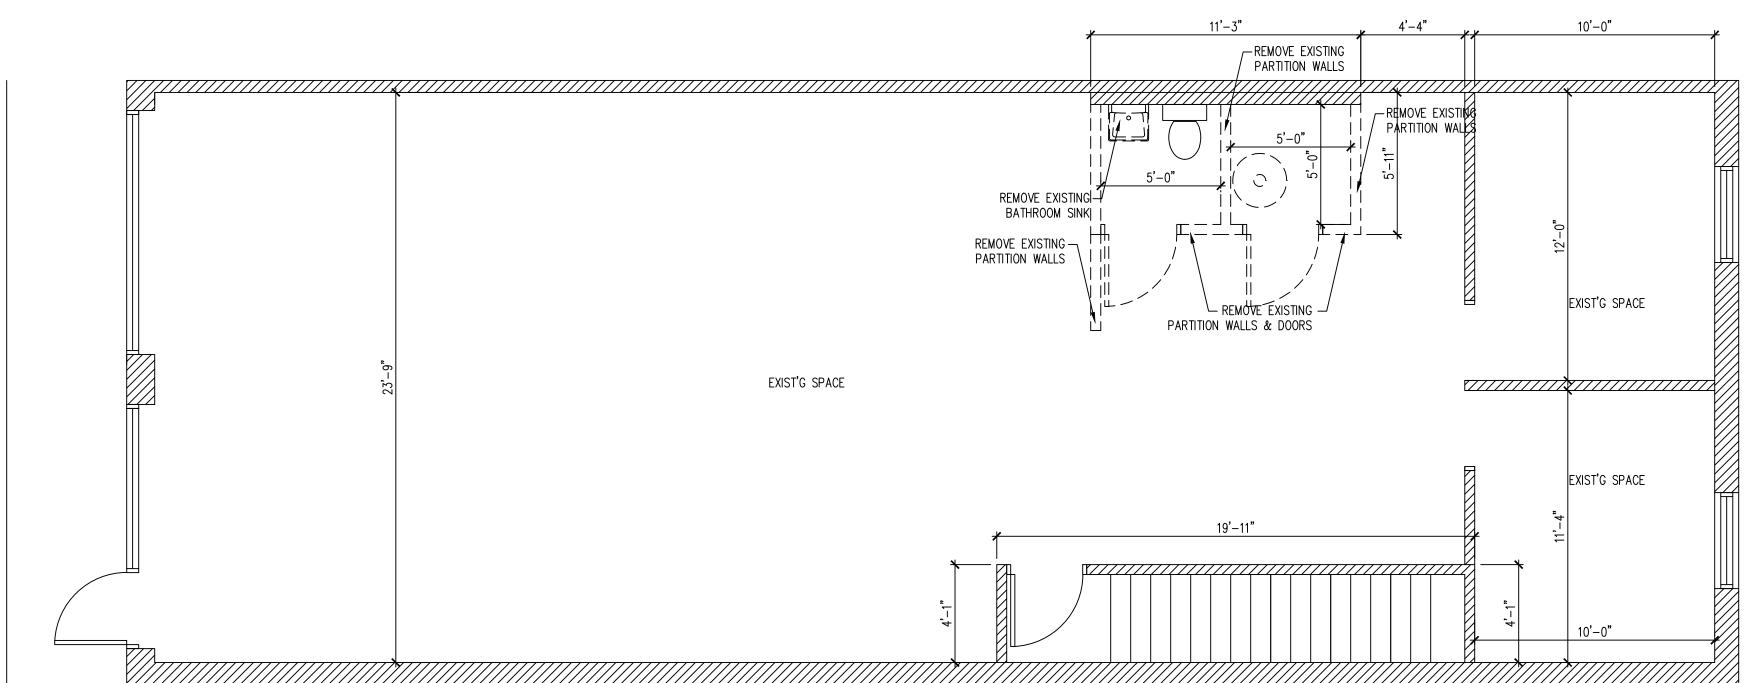

A CAKE SHOP DEMO PLAN

SCALE 1/4"=1'-0"

N

#### **EQUIPMENT NOTES**

CONTRACTOR SHALL INSTALL AND CONNECT ALL EQUIPMENT AS PER EQUIPMENT SUPPLIER'S SPECIFICATIONS. ALL LOCATIONS TO BE VERIFIED WITH OWNER PRIOR TO INSTALLATION.

PLUMBING CONTRACTOR SHALL PROVIDE ALL ROUGH-INS. INSULATE ALL COLD/HOT WATER PIPES AS REQUIRED. MAINTAIN MIN 36" IN FRONT OF ALL COOKING EQUIPMENT.

ELECTRICAL CONTRACTOR SHALL PROVIDE ALL ELECTRICAL OUTLETS FOR EQUIPMENT. VERIFY ALL ELECTRICAL REQUIREMENTS WITH EQUIPMENT SUPPLIER. VERIFY ALL GAS AND WATER REQUIREMENTS WITH EQUIPMENT SUPPLIER.

ALL PERMANENT EQUIPMENT MUST BE LOCATED SO THAT AREAS BEHIND, UNDERNEATH, AND ON THE SIDES OF THE EQUIPMENT CAN BE EASILY CLEANED.

TWO DRAIN BOARDS ARE REQUIRED AT ALL THREE-COMPARTMENT SINKS ALONG WITH AN APPROPRIATELY SIZED FAUCET, LOCKABLE DRAIN PLUGS, AND AN INDIRECT CONNECTION TO THE SEWER.

HARDWARE SCHEDULE							
TAG	DESCRIPTION						
1	1 1/2 PAIR BUTT HINGES, W/LEVERED PRIVACY LOCKSET , KICKPLATE AND DOOR CLOSER						

3 1 1/2 PAIR BUTT HINGES

1 1/2 PAIR BUTT HINGES, PADDLE LATCH EXIT DEVICE AND DOOR CLOSER, PANIC HARDWARE

					EQUIPMENT SCH	IEDULE	
NO	QTY	DESCRIPTION	GAS	ELEC	CTRIC	PLUMBING	REMARKS
1	1	ICE MAKER	_	120V	15A	1/2" CW, 4" INDIRECT DRAIN	NSF,AIR COOLED CONDENSING UNIT
2	1	SOFT SERVE ICE CREAM MACHINE	-	240V	10A	_	NSF
3	3	EGG BEATER	-	120V	3A	-	NSF
4	1	STOCK POT	3/4"			-	NSF 90000BTU
5	1	CASHIER COUNTER	-	-	1	-	NSF
6	1	DEEP FRYER	3/4"			_	NSF 120000BTU
7	1	20 PAN RACK	-	-	Į	-	NSF APPROVED STAINLESS STEEL SHELVING
8	1	RADIANT COOKER	_	120V	3A	-	NSF
9	1	CAKE BRANDING IRON	-	120V	2A	-	NSF
10	4	72" X 28" UNTERCOUNTER COOLER	-	120V	4A	-	NSF
11	3	68" X 44" ELECTRIC OVEN	-	240V	7500W	_	NSF
12	1	HOT WATER HEATER	3/4"	120V	ı	3/4" CW & 3/4" HW	NSF, 50GALLONS
13	2	HAND SINK	-	-	-	1/2" CW,1/2" HW, 2" DRAIN	NSF, WALL MOUNTED - SEALED
14	1	3 COMPARTMENT SINK	_	· ·	-	1/2" CW,1/2" HW,4" INDIRECT DRAIN	NSF,W/ ECOLAB PATHWAY TO PREVENT BACKFLOW
15	1	MOP SINK	-	-		1/2"CW,1/2" HW, 4" DRAIN	NSF, W/ MOP HOOKS, SEAL EDGES
16	1	30" X 72" REFRIGE. DISPLAY CASE	_	120V		_	NSF
17	1	WORK TABLE	-		1		NSF
18	1	10'-0"X4'-0" TYPE I EXHAUST HOOD	-1		-	-	NSF WITH ANSUL FIRE SUPPRESSION SYSTEM
ALL	EQUIP	MENTS WILL BE NSF APPROVED CLEAN, OPER.	ABLE AND SI	UBJECT TO	THE FINAL APPROVAL BY	/ THE HEALTH	

ALL EQUIPMENTS WILL BE NSF APPROVED CLEAN, OPERABLE AND SUBJECT TO THE FINAL APPROVAL BY THE HEALT DEPARTMENT

	DOOR SCHEDULE									
TAG	DESCRIPTION	FRAME CONSTRUCTION		DOOR FINISH	FRAME FINISH	LABEL	HARDWARE SET	COMMENTS		
			WXH							
A	STORE FRONT GLASS DOOR	ALUMINUM	3'-0" x 6'-8"	TEMPERED GLASS	ALUMINUM	-	3	EXIST'G		
В	HOLLOW METAL DOOR	PRE-HUNG METAL	3'-0" x 6'-8"	PAINT	PAINT		3	EXIST'G		
С	WOOD DOOR	PRE-HUNG METAL	3'-0" x 6'-8"	PAINT	PAINT	-	2	NEW		
D	WOOD DOOR	PRE-HUNG METAL	3'-0" x 6'-8"	PAINT	PAINT	-	1	NEW		
E	WOOD DOOR	PRE-HUNG METAL	3'-0" x 6'-8"	PAINT	PAINT	-		NEW		
	* ALL EXIT DOORS MUST OPEN WITHOUT THE USE OF A KEY OR SPECIAL KNOWLEDGE FROM THE SIDE WHICH EGRESS IS MADE									
	* LEVERED HANDLE HARDW	ARE AS REQUIRED E	BY ILLINOIS ACC	ESSIBILITY CODE						

	ROOM FINISH SCHEDULE											
NO	ROOM	WALLS	BASE	FLOOR	CEILING							
100	WAITING AREA	GYP. BD. PAINTED	QT COVE BASE	FLOOR TILE	OPEN CEILING							
101	SERVICE AREA	CERAMIC TILE	QT COVE BASE	QUARRY TILE	OPEN CEILING							
102	TOILET1	CERAMIC TILE	QT COVE BASE	FLOOR TILE	EXIST'G 2X2 CEILING							
103	STORAGE RM	GYP. BD. PAINTED	QT COVE BASE	FLOOR TILE	EXIST'G 2X2 CEILING							

COOKLINE EQUIPMENT AND REACH-IN REFRIGERATION AND FREEZER UNITS TO BE INSTALLED ON CASTERS. PROVIDE THE FOLLOWING: NSF STAINLESS STEEL SHELF OVER 3-COMPTMENT SINK. ICE MAKER A MIN. 8" FROM ALL WALLS. HEAVY-DUTY MOP RACKS LOCATED OVER MOP SINK. HEAVY-DUTY BROOM RACKS IN JANITORIAL AREA. METAL GARBAGE CANS WITH LIDS FOR RESTROOMS. SANITARY BOX IN WOMEN'S RESTROOMS. METAL GARBAGE CANS WITH LIDS FOR DIAPER CHANGING STATION.

ALL NSF APPROVED HAND SINKS TO BE WITH BLADE HANDLED FAUCETS. BEVERAGE STATION & BAR COUNTER TOP -STAINLESS STEEL .

STAINLESS STEEL WALL FINISH FOR BEHIND AND ADJACENT TO COOK LINE.

ALL CABINET SHELVES -STAINLESS STEEL.

ALL CABINET BASE - 6" STAINLESS STEEL LEGS (NO KICK BASE)
LAVATORY COUNTERTOP TO BE SOLID SURFACE (NO PLASTIC LAMINATE OR CABINETRY)
ANY PAINTED FINISHES TO BE SEMI-GLOSS OR GLOSS (NO FLAT, NO EGG SHELL,NO TEXTURE),
PROVIDE CERAMIC TILE ON WALL SIDE AND UNDERSIDE OF SERVICE AREA.

\* PROVIDE DOOR CLOSERS ALONG ALL ACCESSIBLE ROUTES

#### **DEMOLITON NOTES**

CONTRACTOR SHALL PERFORM DEMOLITION AT AREAS INDICATED ON CONTRACT DOCUMENTS. CONTRACTOR SHALL FAMILIARIZE HIMSELF/HERSELF WITH ALL EXISTING CONDITIONS AND INTERFACE BETWEEN AREAS OF DEMOLITION AND EXISTING AREAS TO REMAIN .ALL CHANGES/MODIFICATIONS SHALL BE SUBMITTED TO THE ARCHITECT FOR APPROVAL BEFORE WORK IS BEGUN.

CONTRACTOR SHALL REMOVE ALL EXISTING CONSTRUCTION AS NOTED ON PLANS AND SHALL REMOVE SAID ITEMS OFF SITE UNLESS NOTED OTHERWISE. APPROVAL FROM ARCHITECT/OWNER IS REQUIRED ON THE REUSE OF ANY EXISTING MATERIALS UNLESS OTHERWISE NOTED BEFORE WORK IS BEGUN.

REMOVE PLUMBING FIXTURES, PIPING, LIGHTING, WIRING, AND CONDUIT FROM ALL WALLS AND CEILINGS TO BE DEMOLISHED AND CAP OFF AT POINT OF TERMINATION. IN ALL AREAS WHERE PLUMBING FIXTURES ARE TO BE REMOVED PERMANENTLY, THE FLOORS ARE TO BE BROKEN OUT AROUND PIPING, DRAIN IS TO BE SUFFICIENTLY CAPPED BELOW FINISH FLOOR, AND SLAB IS TO BE REPAIRED TO MATCH EXISTING FLOOR SURFACE. VENTS AND WATER PIPING ARE TO BE ADEQUATELY CAPPED AND LINES REMOVED.

WHERE APPLICABLE REMOVE ALL FLOORING MATERIAL AND ASSOCIATED ADHESIVES.
THE FLOOR IS TO BE SMOOTH AND PREPARED FOR NEW FINISHED FLOORING.

REMOVE ALL EQUIPMENT IN EXISTING AREA IF APPLICABLE, INCLUDING RACKS, FIXTURES, LIFTS AND ANY RELATED DUCTWORK AND PIPING AS REQUIRED. PATCH ALL FLOORS AND WALLS AS NECESSARY.

FOR OPENINGS IN EXISTING WORK, VERIFY EXACT LOCATIONS AND MATERIALS BEFORE PERFORMING WORK. CUTTING OF STRUCTURAL AND BEARING WALLS SHALL NOT BE DONE WITHOUT WRITTEN APPROVAL OF THE ARCHITECT/ENGINEER.

CONTRACTOR TO MAKE VERIFICATION OF EXISTING WORK WHERE SHOWN ON DRAWINGS, WORK WHICH IS 'EXISTING' IS ASSUMED TO BE IN PLACE AND SUITABLE FOR THE NECESSARY ALTERATIONS AND/OR ADDITIONS REQUIRED.


#### DRY STORAGE

DRY STORAGE : 25% OF 350SF (SERVICE AREA.) = 88SF REQ'D ACTUAL DRY STORAGE 234SF PROVIDED

ALL FOOD AND FOOD RELATED ITEMS MUST BE STORED OFF THE FLOOR ON DURABLE WASHABLE SHELVES. THE STORAGE AREA MUST BE APPROPRIATELY SIZED BASED ON THE NUMBER OF MEALS SERVED DAILY AND THE NUMBER OF DELIVERIES WEEKLY.

ALL FOOD EQUIPMENT TO BE ON CASTERS, 6" LEGS, OR SEALED TO THE FLOOR FOR EASY CLEANING.

NO RAW WOOD SURFACES PERMITTED ANYWHERE. UNDERSIDES OF COUNTERTOPS, INSIDE OF CABINETRY, AND WATER HEATER PLATFORMS MUST BE SEALED.

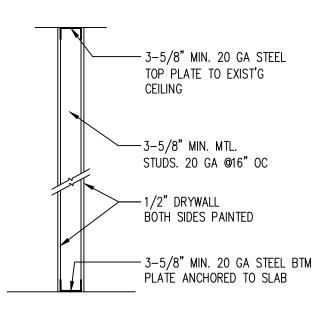

P1 WALL TYPE P1 NOT TO SCALE

2425 S WENTWORTH AVE Chicago IL 60616 Ph: 312.912.5798 twarchitect98@yahoo.com License #001-022013

TW ARCHITECT INC

OWNER 2124B S ARCHER AVE CHICAGO IL 60616


BAKERY SHOP
INTERIOR REMODELING
2124B S ARCHER AVE CHICAGO IL 6061

SSUES DATE
SSUED FOR PERMIT 03/18/2023



FLOOR PLAN, NOTES, & SCHEDULES



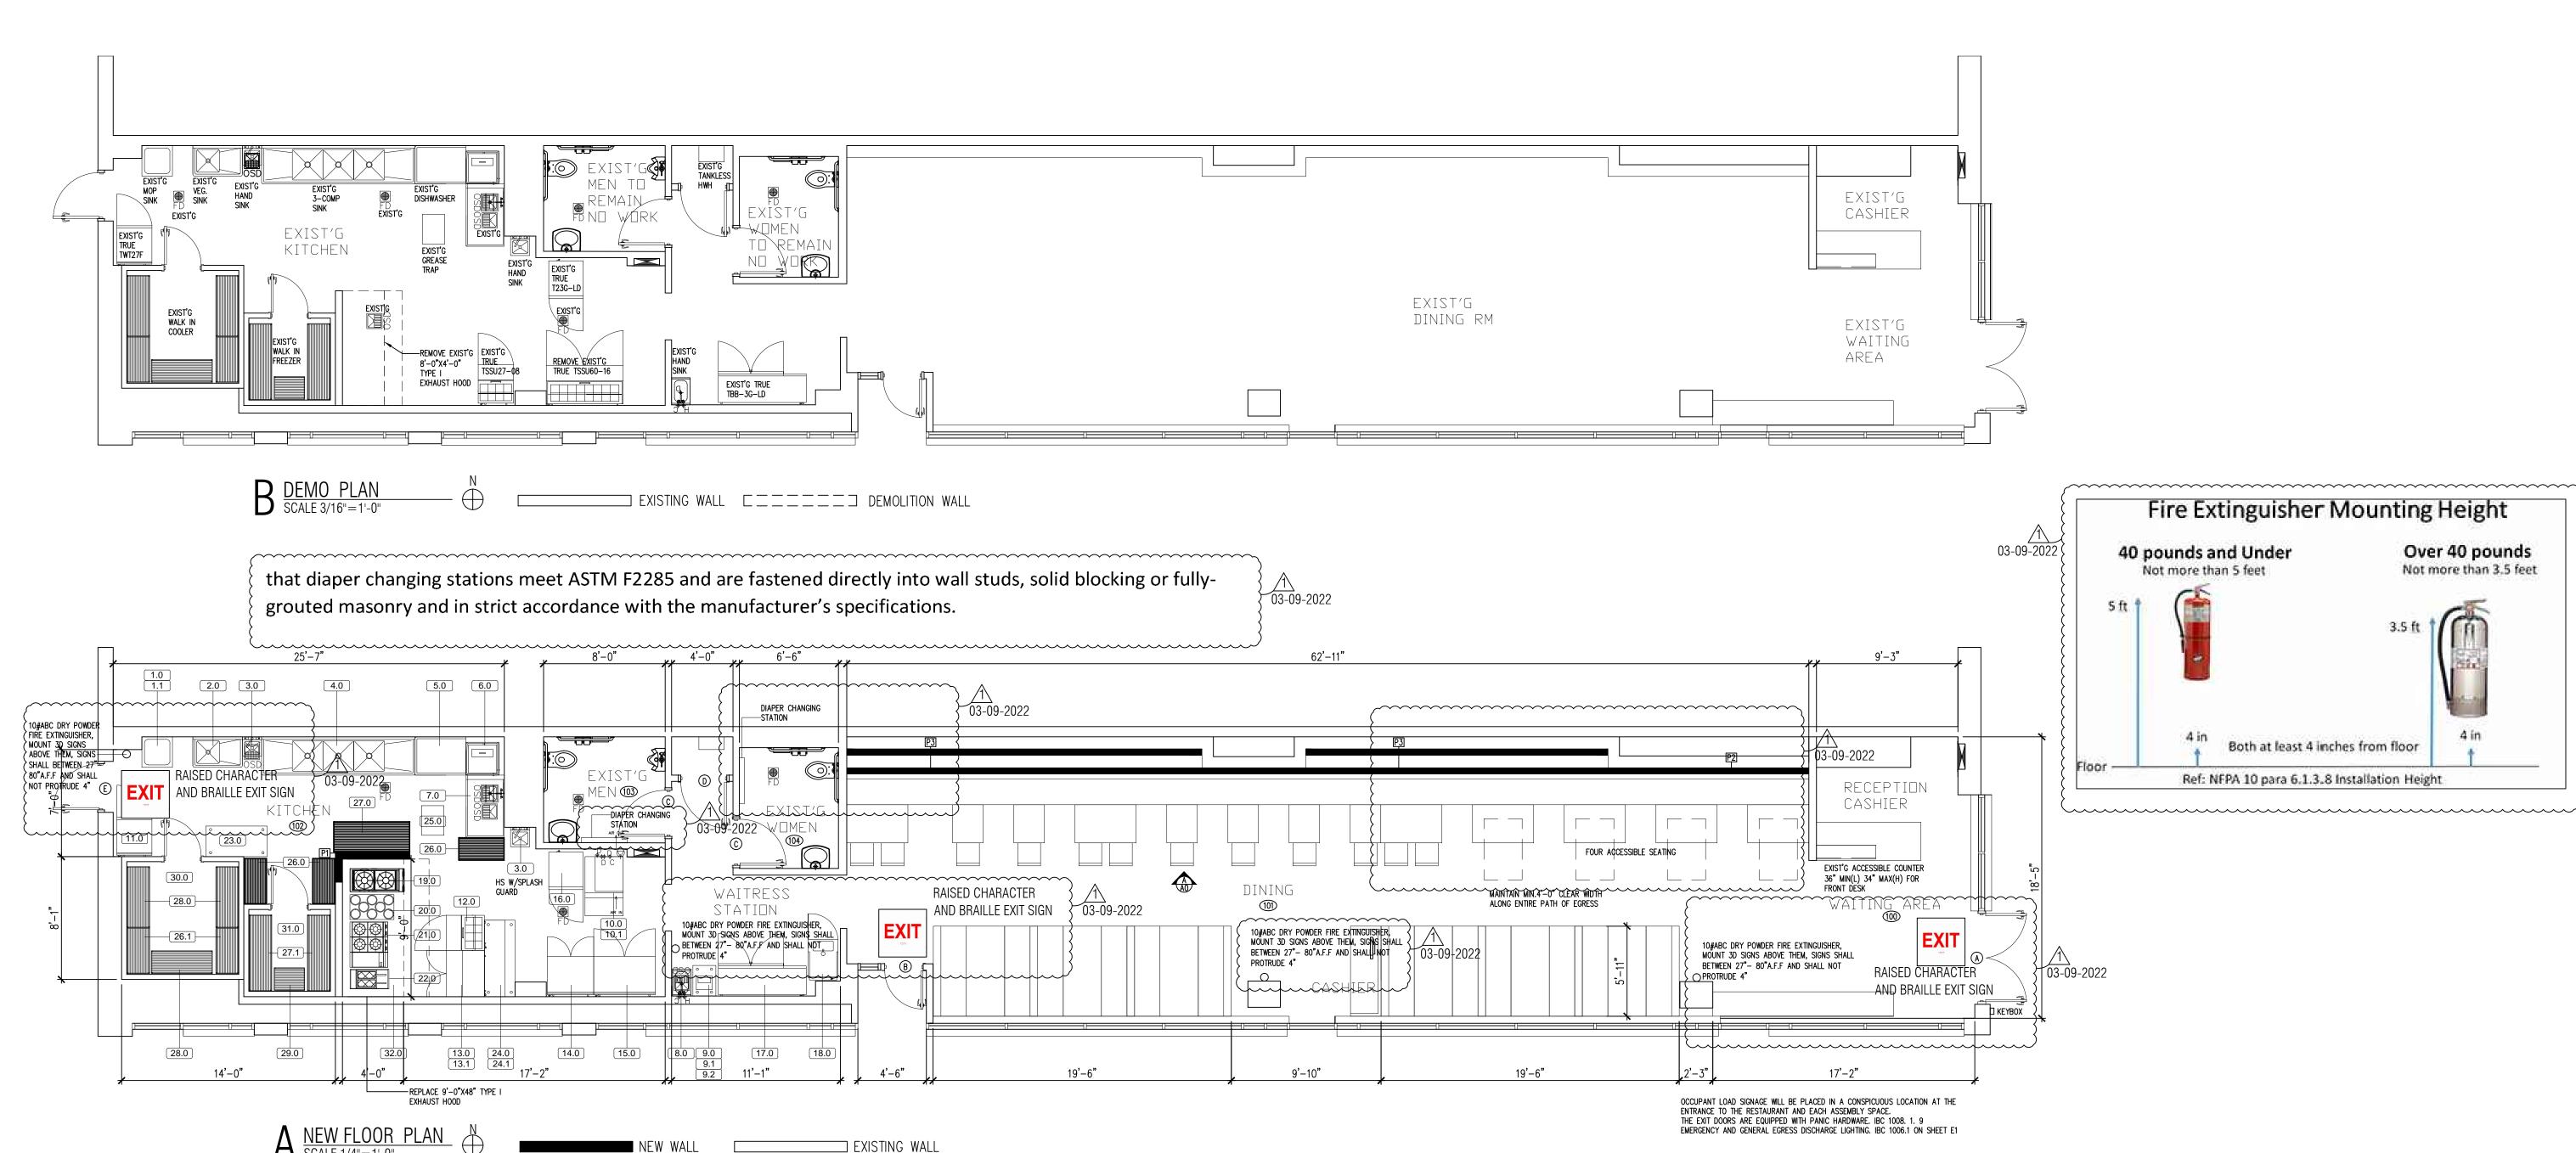

HARDWARE SCHEDULE

DESCRIPTION

1 1/2 PAIR BUTT HINGES, W/ SELF CLOSING DEVICE

1 1/2 PAIR BUTT HINGES, PADDLE LATCH EXIT DEVICE AND DOOR CLOSER, PANIC HARDWARE

PROVIDE DOOR CLOSERS ALONG ALL ACCESSIBLE ROUTES

1 1/2 PAIR BUTT HINGES, SELF CLOSING DEVICE, ACCESSIBLE HARDWARE

			D(	00R S	SCHEDULE				
TAG	DESCRIPTION	FRAME CONSTRUCTION	NOMINAL SIZ	ZE	DOOR FINISH	FRAME FINISH	LABEL	HARDWARE	COMMENTS
.,,,,,			WXH						
A	STORE FRONT GLASS DOOR	ALUMINUM	6'-0" x	7'-0"	TEMPERED GLASS	ALUMINUM	-	3	EXIST'G
В	STORE FRONT GLASS DOOR	ALUMINUM	3'-0" x	7'-0"	TEMPERED GLASS	ALUMINUM	-	3	EXIST'G
С	HOLLOW METAL DOOR	PRE-HUNG METAL	3'-0" x	7'-0"	PAINT	PAINT	-	2	EXIST'G
D	HOLLOW METAL DOOR	PRE-HUNG METAL	3'-0" x	7'-0"	PAINT	PAINT	1	1	EXIST'G
E	HOLLOW METAL DOOR	PRE-HUNG METAL	3'-0" x	7'-0"	PAINT	PAINT	-	3	EXIST'G
	ALL EXIT DOORS MUST	FOPEN WITHOUT THE	USE OF A	4 KEY	OR SPECIAL KNO	WLEDGE FRO	M THE	SIDE WHI	CH EGRESS IS MADE
	LEVERED HANDLE HAR	DWARE AS REQUIRE	D BY ILLIN	IOIS A	ACCESSIBILITY COI	DE			

			ROOM FINISH SCHEE	DULE	
NO	ROOM	WALLS	BASE	FLOOR	CEILING
100	WAITING AREA	EXIST'G GYP. BD. PAINTED	EXIST'G QT COVE BASE	EXIST'G FLOOR TILE	EXIST'G 2'X2' CEILING
101	DINING	EXIST'G GYP. BD. PAINTED	EXIST'G QT COVE BASE	EXIST'G FLOOR TILE	EXIST'G 2'X2' CEILING
102	KITCHEN	EXIST'G STAINLESS STEEL	EXIST'G QT COVE BASE	EXIST'G QUARRY TILE	EXIST'G 4'X2' CEILING
103	MEN'S TOILET	EXIST'G CERAMIC TILE	EXIST'G CERAMIC TILE	EXIST'G FLOOR TILE	EXIST'G 2'X2' CEILING
104	WOMEN'S TOILET	EXIST'G CERAMIC TILE	EXIST'G CERAMIC TILE	EXIST'G FLOOR TILE	EXIST'G 2'X2' CEILING

## KITCHEN EQUIPMENT NOTES

COOKING EQUIPMENT.

CONTRACTOR SHALL INSTALL AND CONNECT ALL EQUIPMENT AS PER EQUIPMENT SUPPLIER'S SPECIFICATIONS. ALL LOCATIONS TO BE VERIFIED WITH OWNER PRIOR

TO INSTALLATION.

PLUMBING CONTRACTOR SHALL PROVIDE ALL ROUGH-INS. INSULATE ALL COLD/HOT WATER PIPES AS REQUIRED. MAINTAIN MIN 36" IN FRONT OF ALL

ELECTRICAL CONTRACTOR SHALL PROVIDE ALL ELECTRICAL OUTLETS FOR EQUIPMENT. VERIFY ALL ELECTRICAL REQUIREMENTS WITH EQUIPMENT SUPPLIER.

ALL PERMANENT EQUIPMENT MUST BE LOCATED SO THAT AREAS BEHIND, UNDERNEATH, AND ON THE SIDES OF THE EQUIPMENT CAN BE EASILY CLEANED.

VERIFY ALL GAS AND WATER REQUIREMENTS WITH EQUIPMENT SUPPLIER.

TWO DRAIN BOARDS ARE REQUIRED AT ALL THREE-COMPARTMENT SINKS ALONG WITH AN APPROPRIATELY SIZED FAUCET, LOCKABLE DRAIN PLUGS, AND AN INDIRECT CONNECTION TO THE SEWER.

- Dial stem thermometers (ranging from 0° to 220°F) are required in all preparation areas.
- Chemical test kits (specific to the sanitizer) are required for the appropriate sanitizer.
- pH meter and log for acidifying rice.
- All cooling/freezing units must have accurate thermometers.
- Covered waste cans are required in all restrooms.
- Toilets, urinals, hand sinks, 3 compartment sinks, mop sink, prep sinks, and permanent counters/cabinets must be sealed to floors and walls with a silicone caulk seal.
- Anti-siphon devices are required on all toilet tanks, urinals, and faucets with hose
- Soap and paper towels are required at all hand sinks.
- Provide hair restraints and disposable gloves for all food handlers.

If sinks are provided with spring-loaded faucets, the faucets must remain running for a minimum of 15 seconds

Doors leading to the outside and restroom doors are required to be self-closing and tight-fitting. Please confirm that the doors leading to the outside are equipped with a self-closer and weather strips to eliminate any air gaps.

### DRY STORAGE

DRY STORAGE : 25% OF 360 SF (KITCHEN AREA.)=90SF REQ'D ACTUAL DRY STORAGE 5X4X4X2 + 3X3X1.5X4 = 94SF PROVIDED.

ALL FOOD AND FOOD RELATED ITEMS MUST BE STORED OFF THE FLOOR ON DURABLE WASHABLE SHELVES. THE STORAGE AREA MUST BE APPROPRIATELY SIZED BASED ON THE NUMBER OF MEALS SERVED DAILY AND THE NUMBER OF DELIVERIES WEEKLY.

ALL FOOD EQUIPMENT TO BE ON CASTERS, 6" LEGS, OR SEALED TO THE FLOOR FOR EASY CLEANING.

NO RAW WOOD SURFACES PERMITTED ANYWHERE. UNDERSIDES OF COUNTERTOPS, INSIDE OF CABINETRY, AND WATER HEATER PLATFORMS MUST BE SEALED.

PROVIDE THE FOLLOWING: NSF STAINLESS STEEL OPEN WIRE SHELVING UNITS.

NSF STAINLESS STEEL SHELF OVER 3-COMPTMENT SINK. ICE MAKER A MIN. 8" FROM ALL WALLS.

HEAVY-DUTY MOP RACKS LOCATED OVER MOP SINK.

HEAVY-DUTY BROOM RACKS IN JANITORIAL AREA. METAL GARBAGE CANS WITH LIDS FOR RESTROOMS.


SANITARY BOX IN WOMEN'S RESTROOMS. METAL GARBAGE CANS WITH LIDS FOR DIAPER CHANGING STATION.

ALL NSF APPROVED HAND SINKS TO BE WITH BLADE HANDLED FAUCETS.
BEVERAGE STATION & BAR COUNTER TOP -STAINLESS STEEL.
ALL CABINET SHELVES -STAINLESS STEEL.

ALL CABINET BASE - 6" STAINLESS STEEL LEGS (NO KICK BASE)
LAVATORY COUNTERTOP TO BE SOLID SURFACE (NO PLASTIC LAMINATE OR CABINETRY)
ANY PAINTED FINISHES TO BE SEMI-GLOSS OR GLOSS (NO FLAT, NO EGG SHELL,NO TEXTURE),

PROVIDE FRP ON WALL AND UNDERSIDE OF BAR.
STAINLESS STEEL WALL FINISH FOR BEHIND AND ADJACENT TO COOK LINE

FIRE EXTINGUISHERS TO BE TYPE K IN KITCHEN AND TYPE A IN DINING ROOM

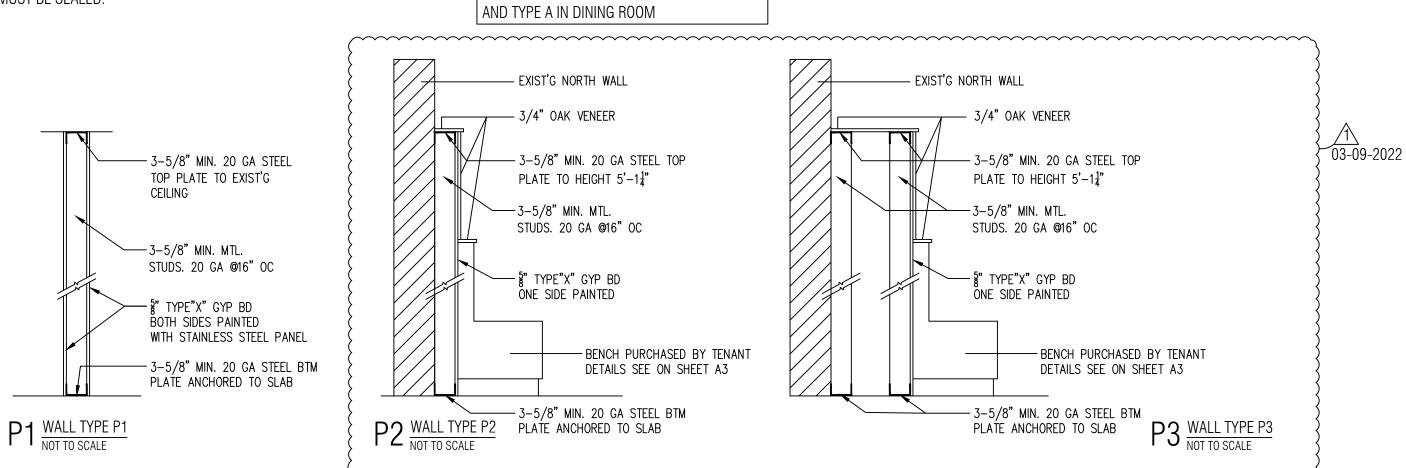

WEI TAN 2425 S WENTWORTH AVE CHICAGO, IL 60616

PHONE: (312) 912-5798 EMAIL: twarchitect98@yahoo.com

LICENSE NO: 001-022013 EXPIRES: 11/30/2022

OWNER TANAKA RAMEN

112 E GREEN STREET SUITE A CHAMPAIGN IL 61820

MEP PROFESSIONAL ENGINEER 236 W ALEXANDER STREET CHICAGO IL 60616


PHONE: (312)720-8800
BILLY\_WANG68@HOTMAIL.COM
LICENSE NO: 062.068227
EXPIRES: 11 / 30 /2023

TANAKA RAMEN
INTERIOR REMODELING
112 E GREEN SUITE A
CHAMPAIGN II 61820

ISSUES	DATE
ISSUED FOR PERMIT	11/05/2021
REISSUED FOR PERMIT	03/09/2022

FLOOR PLAN, NOTES, & SCHEDULES



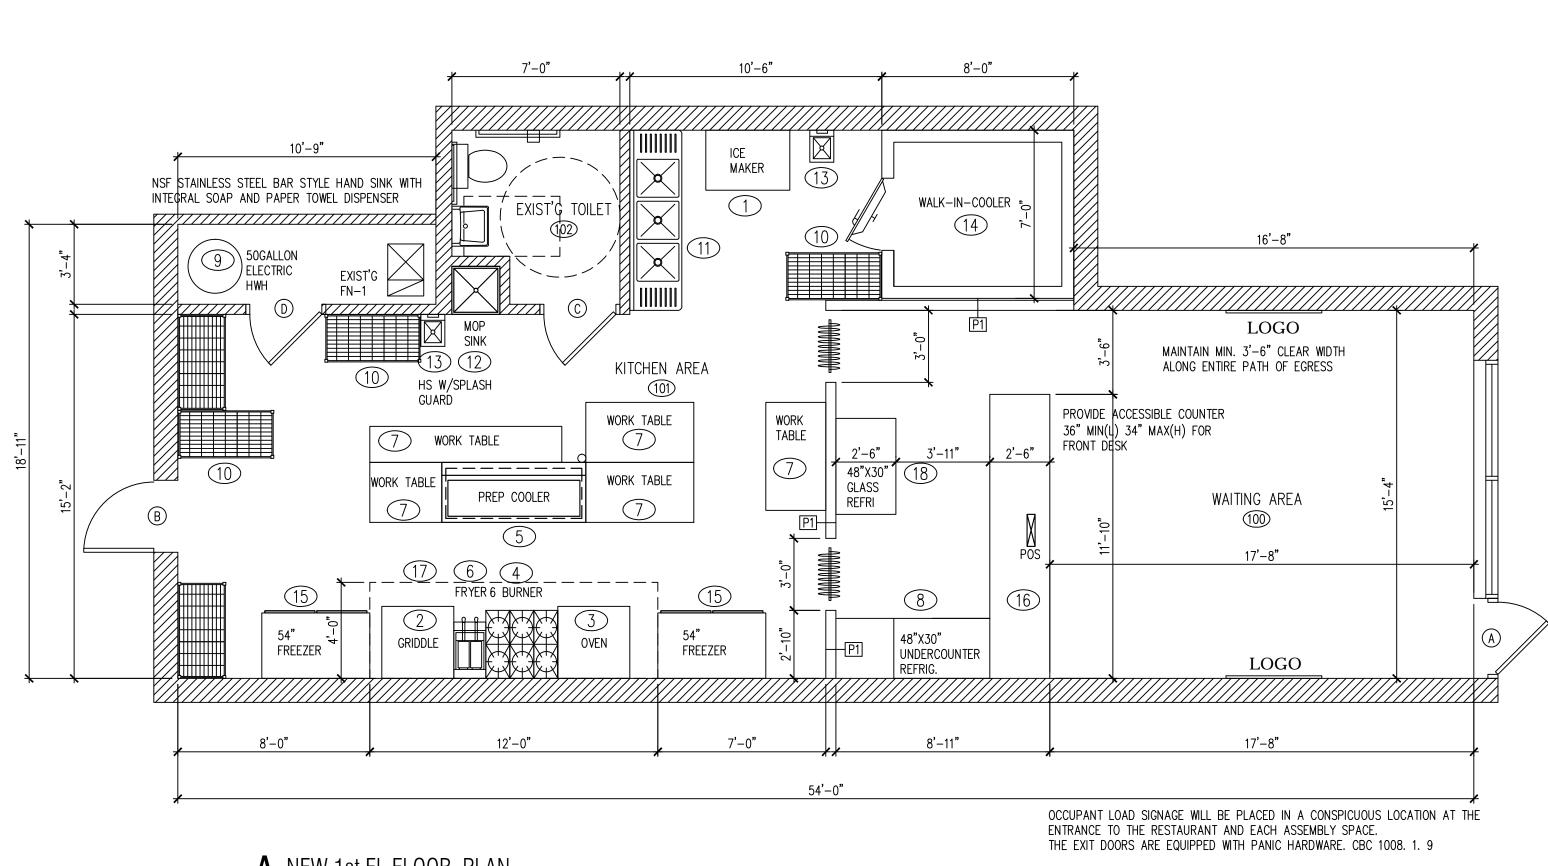

KITCHEN EQUIPMENT NOTES

CONTRACTOR SHALL INSTALL AND CONNECT ALL EQUIPMENT AS PER EQUIPMENT SUPPLIER'S SPECIFICATIONS. ALL LOCATIONS TO BE VERIFIED WITH OWNER PRIOR • pH meter and log for acidifying rice. TO INSTALLATION.

PLUMBING CONTRACTOR SHALL PROVIDE ALL ROUGH-INS. INSULATE ALL COLD/HOT WATER PIPES AS REQUIRED. MAINTAIN MIN 36" IN FRONT OF ALL COOKING EQUIPMENT.

ELECTRICAL CONTRACTOR SHALL PROVIDE ALL ELECTRICAL OUTLETS FOR EQUIPMENT, VERIFY ALL ELECTRICAL REQUIREMENTS WITH EQUIPMENT SUPPLIER. • Soap and paper towels are required at all hand sinks. VERIFY ALL GAS AND WATER REQUIREMENTS WITH EQUIPMENT SUPPLIER.

ALL PERMANENT EQUIPMENT MUST BE LOCATED SO THAT AREAS BEHIND, UNDERNEATH, AND ON THE SIDES OF THE EQUIPMENT CAN BE EASILY CLEANED.

TWO DRAIN BOARDS ARE REQUIRED AT ALL THREE-COMPARTMENT SINKS ALONG WITH AN APPROPRIATELY SIZED FAUCET, LOCKABLE DRAIN PLUGS, AND AN INDIRECT CONNECTION TO THE SEWER.


#### DRY STORAGE

DRY STORAGE: 25% OF 525 SF (KITCHEN AREA.)=131SF REQ'D ACTUAL DRY STORAGE 5X4X4X2 = 160SF PROVIDED.

ALL FOOD AND FOOD RELATED ITEMS MUST BE STORED OFF THE FLOOR ON DURABLE WASHABLE SHELVES. THE STORAGE AREA MUST BE APPROPRIATELY SIZED BASED ON THE NUMBER OF MEALS SERVED DAILY AND THE NUMBER OF DELIVERIES WEEKLY.

ALL FOOD EQUIPMENT TO BE ON CASTERS, 6" LEGS, OR SEALED TO THE FLOOR FOR EASY CLEANING.

NO RAW WOOD SURFACES PERMITTED ANYWHERE. UNDERSIDES OF COUNTERTOPS, INSIDE OF CABINETRY, AND WATER HEATER PLATFORMS MUST BE SEALED.

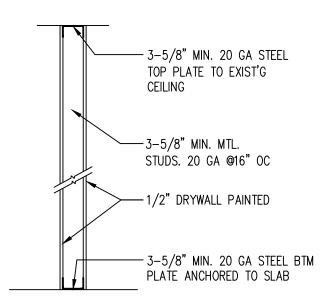

P1 WALL TYPE P1 NOT TO SCALE

- Dial stem thermometers (ranging from 0° to 220°F) are required in all preparation areas.
- Chemical test kits (specific to the sanitizer) are required for the appropriate sanitizer

EXISTING WALL

- All cooling/freezing units must have accurate thermometers.
- Covered waste cans are required in all restrooms.
- Toilets, urinals, hand sinks, 3 compartment sinks, mop sink, prep sinks, and permanent counters/cabinets must be sealed to floors and walls with a silicone caulk seal.
- Anti-siphon devices are required on all toilet tanks, urinals, and faucets with hose
- Provide hair restraints and disposable gloves for all food handlers.

If sinks are provided with spring-loaded faucets, the faucets must remain running for a minimum

Doors leading to the outside and restroom doors are required to be self-closing and tight-fitting. Please confirm that the doors leading to the outside are equipped with a self-closer and weather strips to eliminate any air gaps.

PROVIDE THE FOLLOWING: NSF STAINLESS STEEL OPEN WIRE SHELVING UNITS. NSF STAINLESS STEEL SHELF OVER 3-COMPTMENT SINK. ICE MAKER A MIN. 8" FROM ALL WALLS. HEAVY-DUTY MOP RACKS LOCATED OVER MOP SINK. HEAVY-DUTY BROOM RACKS IN JANITORIAL AREA. METAL GARBAGE CANS WITH LIDS FOR RESTROOMS.

ALL NSF APPROVED HAND SINKS TO BE WITH BLADE HANDLED FAUCETS. BEVERAGE STATION & BAR COUNTER TOP -STAINLESS STEEL

ALL CABINET SHELVES -STAINLESS STEEL.

ALL CABINET BASE - 6" STAINLESS STEEL LEGS (NO KICK BASE)

LAVATORY COUNTERTOP TO BE SOLID SURFACE (NO PLASTIC LAMINATE OR CABINETRY)

ANY PAINTED FINISHES TO BE SEMI-GLOSS OR GLOSS (NO FLAT, NO EGG SHELL, NO TEXTURE), PROVIDE TILE ON WALL AND UNDERSIDE OF BAR.

STAINLESS STEEL WALL FINISH FOR BEHIND AND ADJACENT TO COOK LINE


PROVIDE DOOR CLOSERS ALONG ALL ACCESSIBLE ROUTES

				D	00R S	SCHEDULE				
TAG	DESCRIPTION	FRAME CONSTRUCTION	NOMINA W X H	AL SI	ZE	DOOR FINISH	FRAME FINISH	LABEL	HARDWARE	COMMENTS
Α	STORE FRONT GLASS DOOR	ALUMINUM	3'-0"	X	7'-0"	TEMPERED GLASS	ALUMINUM	-	3	EXIST'G
В	HOLLOW METAL DOOR	PRE-HUNG METAL	3'-0"	X	7'-0"	PAINT	PAINT	-	3	EXIST'G
C	WOOD DOOR	PRE-HUNG METAL	3'-0"	X	6'-8"	PAINT	PAINT	-	2	EXIST'G
D	WOOD DOOR	PRE-HUNG METAL	3'-0"	X	7'-0"	PAINT	PAINT	-	1	EXIST'G
	ALL EXIT DOORS MUST	OPEN WITHOUT THE	EUSE	OF	A KEY	OR SPECIAL KNOW	WLEDGE FRO	M THE	SIDE WHI	CH EGRESS IS MADE
	LEVERED HANDLE HAR	DWARE AS REQUIRE	D BY I	LLIN	NOIS A	CCESSIBILITY CO	DE			

FIRE EXTINGUISHERS TO BE TYPE K IN KITCHEN

AND TYPE A IN WAITING AREA

		R00	M FINISH SCHED	DULE	
NO	ROOM	WALLS	BASE	FLOOR	CEILING
101	WAITING AREA	GYP. BD. PAINTED	QT COVE BASE	FLOOR TILE	EXIST'G CEILING
102	KITCHEN AREA	STAINLESS STEEL	QT COVE BASE	QUARRY TILE	2X4 VINYL TILE CEILING
103	EXIST'G TOILET	CERAMIC TILE	CERAMIC TILE	FLOOR TILE	EXIST'G CEILING

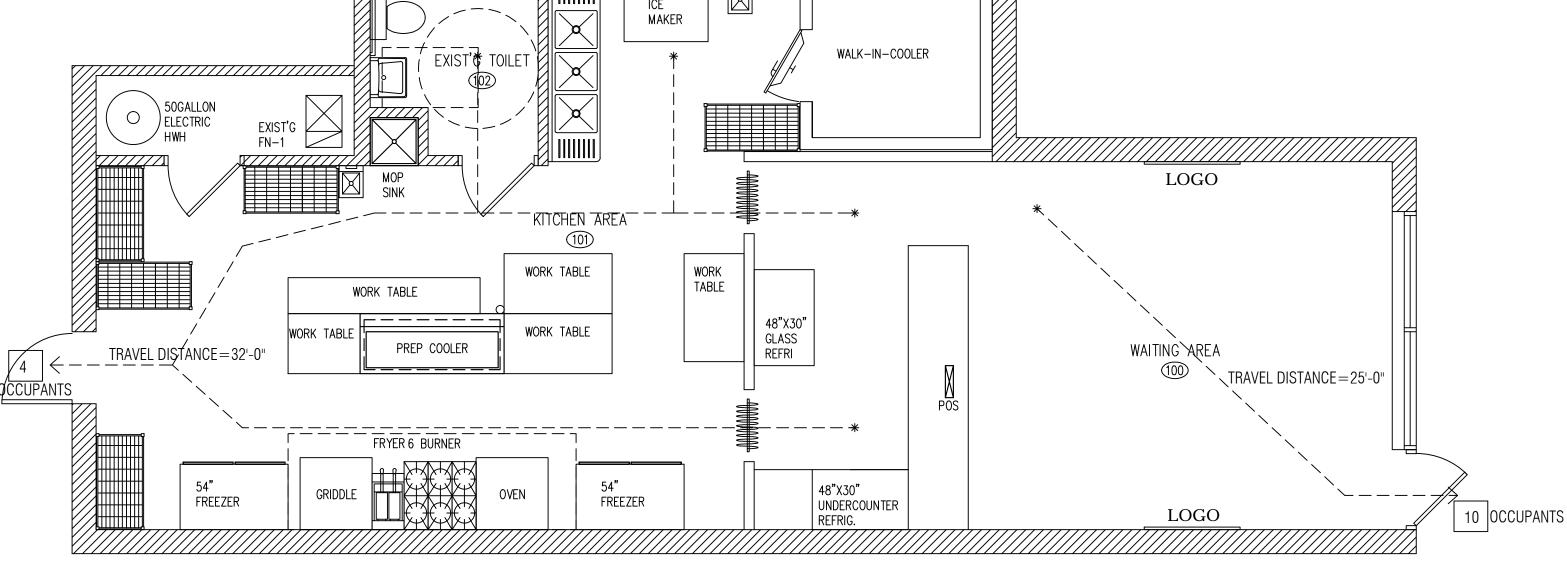

EXIST'G SPACE

EXISTING WALL [ ] DEMOLITION WALL

EXIST'G COLUMN

NEW 1st FLOOR OCCUPANCY & EXITING DIAGRAM
SCALE 1/4"=1'-0"

EXIST'G MOP

	HARDWARE SCHEDULE
TAG	DESCRIPTION
1	1 1/2 PAIR BUTT HINGES, W/ SELF CLOSING DEVICE
2	1 1/2 PAIR BUTT HINGES, SELF CLOSING DEVICE, ACCESSIBLE HARDWARE
3	1 1/2 PAIR BUTT HINGES, PADDLE LATCH EXIT DEVICE AND DOOR CLOSER, PANIC HARDWARE

					EQUIPMENT SCH	EDULE	
NO	QTY	DESCRIPTION	GAS	ELECTRIC		PLUMBING	REMARKS
1	1	ICE MAKER	-	240V	10A	1/2" CW	NSF,AIR COOLED CONDENSING UNIT
2	1	GRIDDLE	3/4"			-	NSF, 80000BTU
3	1	OVEN	3/4"		-	-	NSF,80000BTU
4	1	6 BURNER	3/4"				NSF,80000BTU
5	1	72" X 30" PREP COOLER	-	120V	4A	-	NSF,W/ CASTERS
6	1	DEEP FRYER	3/4"	-	-	-	NSF, 120000 BTU
7	5	WORK TABLE	=	-	-	-	NSF,W/ 6" STAINLESS STEEL LEGS NSF APPROVED
8	1	48" X 30" UNDERCOUNTER REFRIG.	-	120V	2.7A	-	NSF
9	1	50 GALLON ELECTRIC HWH		240V	-	3/4" CW & 3/4" HW	NSF
10	5	SHELVING	-		-	-	NSF APPROVED STAINLESS STEEL SHELVING
11	1	3 COMPARTMENT SINK	-	-	-	1/2" CW,1/2" HW,4" INDIRECT DRAIN	NSF,W/ ECOLAB PATHWAY TO PREVENT BACKFLOW
12	1	MOP SINK	-			1/2"CW,1/2" HW, 4" DRAIN	NSF, W/ MOP HOOKS, SEAL EDGES
13	2	HAND SINK	=	-	-	1/2" CW,1/2" HW, 2" DRAIN	NSF, WALL MOUNTED - SEALED
14	1	8'X7' WALK IN COOLER	-	240V	12A		NSF
15	2	54" X 30" FREEZER	-	120V	4.5A	-	NSF,W/ CASTERS
16	1	COUNTER	-		-		NSF
17	1	12'-0" X4' TYPE I EXHAUST HOOD	r <u>u</u>	H	=	-	U.L. W/ ANSUL FIRE SUPPRESSION SYSTEM
18	1	48" X 30" GLASS REFRIG.	ı=	120V	4A		NSF
ALL I	EQUIPN	MENTS WILL BE NSF APPROVED CLEAN,OPE	RABLE AND	SUBJECT	TO THE FINAL APPROVAL	BY THE HEALTH	
DEP	ARTME	ENT					

TW ARCHITECT 2425 S WENTWORTH AVE CHICAGO, IL 60616

PHONE: (312) 912-5798 EMAIL: twarchitect98@yahoo.com

LICENSE NO: 001-022013

EXPIRES: 11/30/2024


220 C

UES	DATE
UED FOR PERMIT	08/28/2022



FLOOR PLANS & NOTES



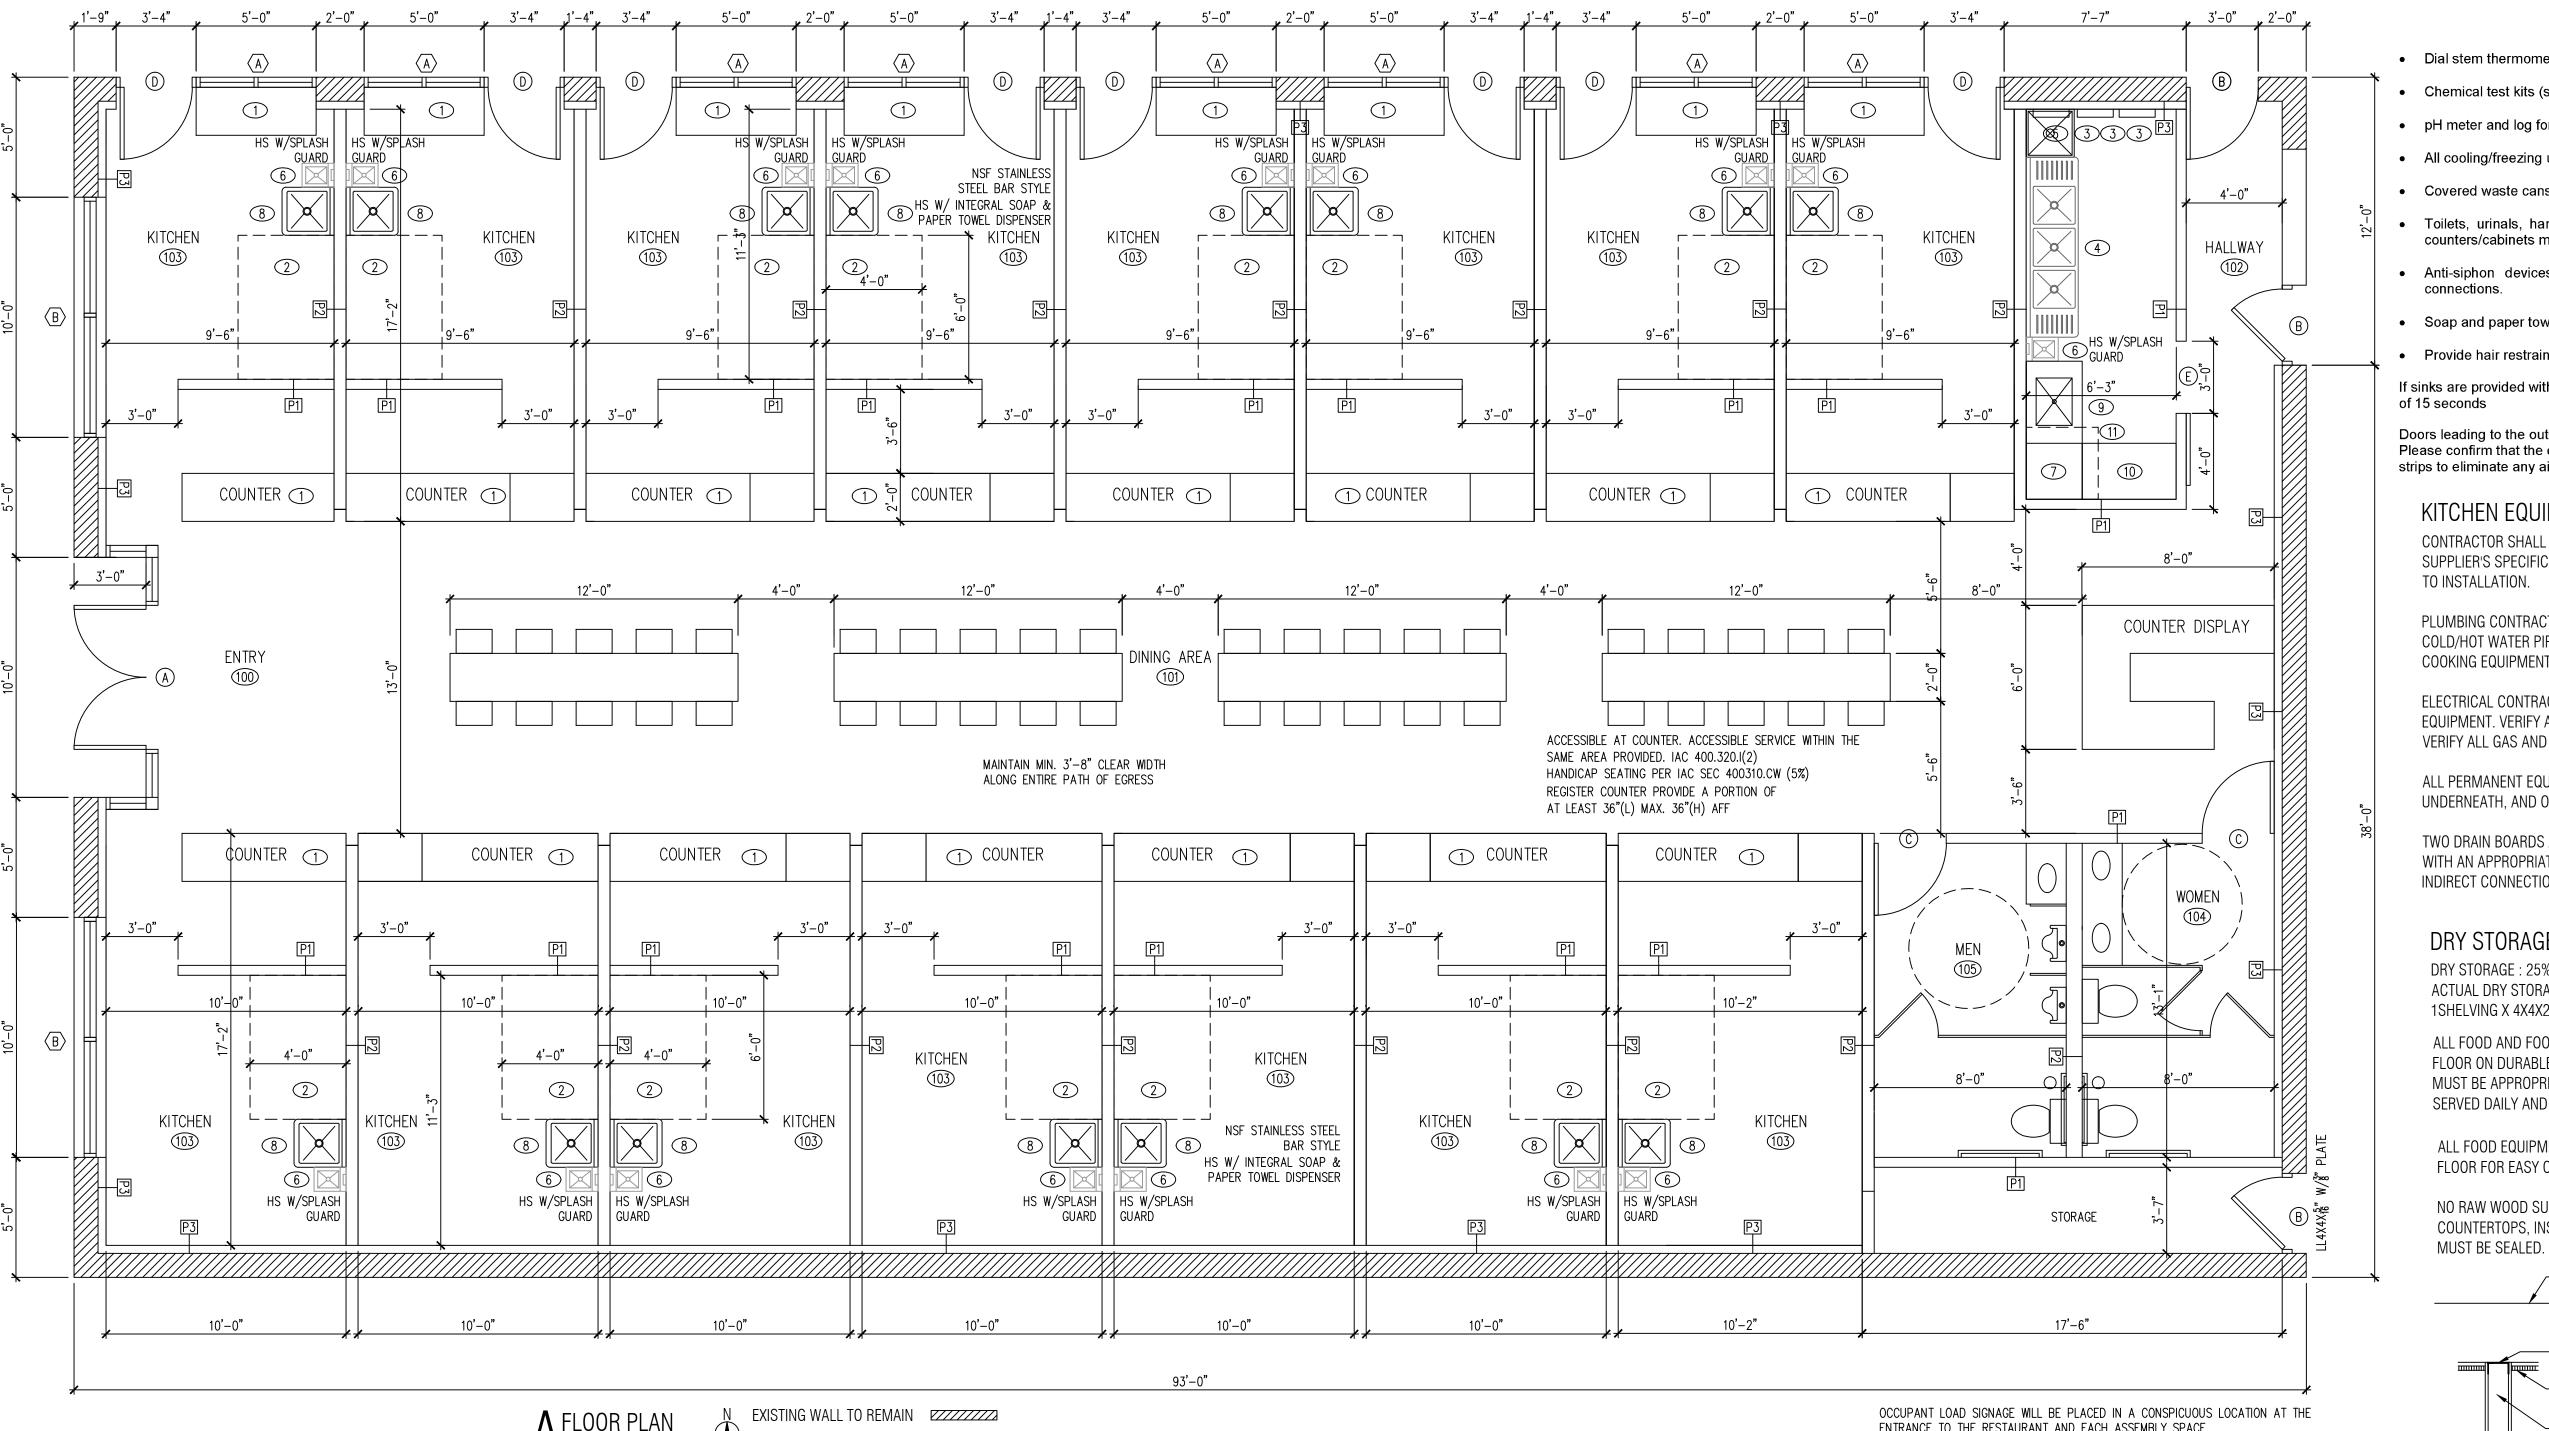

↑ FLOOR PLAN  $\overline{SCALE} \frac{1}{4}$ "=1'-0"

OPEN CEILING

NSF for dishwasher

NO	QTY	DESCRIPTION	GAS	ELE	CTRIC	PLUMBING	REMARKS
1	23	COUNTER W/CABINETS	-	-	-	-1	NSF
2	15	6'-0"X4'-0" EXHAUST HOOD, TYPE I	Ε	12	-	-	U.L. W/ANSUL FIRE SUPPRESSION SYSTEM
3	3	TANKLESS HOT WATER HEATER	3/4"	120V	-	3/4" CW & 3/4" HW	NSF, 199000 BTU
4	1	3 COMPARTMENT SINK	=	-	-	1/2" CW,1/2" HW,4" INDIRECT DRAIN	NSF,W/ ECOLAB PATHWAY TO PREVENT BACKFLOW
5	1	MOP SINK/A FLOOR BASIN UNIT	-	1-		1/2"CW,1/2" HW, 4" DRAIN	NSF, W/ MOP HOOKS, SEAL EDGES
6	16	HAND SINK	_	1=	-	1/2" CW,1/2" HW, 2" DRAIN	NSF, WALL MOUNTED - SEALED
7	1	DISHWASHER	_	240V	-	1/2" HW, 4" INDIRECT DRAIN	NSF
8	15	1 COMP SINK	_	-	-	1/2"CW,1/2" HW, 4" INDIRECT DRAIN	NSF
9	1	3' DISHTABLE (SOILED)	-	-	-	1/2" HW, 4" INDIRECT DRAIN	NSF,W/ 6" STAINLESS STEEL LEGS NSF APPROVED
10	1	4' DISHTABLE (CLEAN)	-	ı <del>-</del>	-	-	NSF,W/ 6" STAINLESS STEEL LEGS NSF APPROVED

FLOOR TILE

**EQUIPMENT SCHEDULE** 

ALL EQUIPMENTS WILL BE NSF APPROVED CLEAN, OPERABLE AND SUBJECT TO THE FINAL APPROVAL BY THE HEALTH DEPARTMENT

3'X3' EXHAUST HOOD.TYPE II

106 STORAGE

		ROOM	M FINISH SCHEDU	JLE	
NO	ROOM	WALLS	BASE	FLOOR	CEILING
100	ENTRY	GYP. BD. PAINTED	QT COVE BASE	FLOOR TILE	OPEN CEILING
101	DINING AREA	GYP. BD. PAINTED	QT COVE BASE	FLOOR TILE	OPEN CEILING
102	HALLWAY	GYP. BD. PAINTED	QT COVE BASE	FLOOR TILE	OPEN CEILING
103	KITCHEN/WASH AREA	STAINLESS STEEL	QT COVE BASE	QUARRY TILE	2'X4' VINYL TILE CLG.
104	WOMEN'S	CERAMIC TILE	CERAMIC TILE	FLOOR TILE	2'X4' CLG.
105	MEN'S	CERAMIC TILE	CERAMIC TILE	FLOOR TILE	2'X4' CLG.

GYP. BD. PAINTED QT COVE BASE

ENTRANCE TO THE RESTAURANT AND EACH ASSEMBLY SPACE.

THE EXIT DOORS ARE EQUIPPED WITH PANIC HARDWARE. CBC 1008. 1. 9 EMERGENCY AND GENERAL EGRESS DISCHARGE LIGHTING.CBC 1006.1 ON SHEET E1

			D00R	SCHEDULE				
TAG	DESCRIPTION	FRAME CONSTRUCTION	NOMINAL SIZE	DOOR FINISH	FRAME FINISH	LABEL	HARDWARE SET	COMMENTS
			WXH					
Α	STORE FRONT GLASS DOOR	ALUMINUM	6'-0" x 8'-0"	TEMPERED GLASS	ALUMINUM	-	2	NEW
В	HOLLOW METAL DOOR	HOLLOW METAL	3'-0" x 7'-0"	PAINT	PAINT	-	2	NEW
C	HOLLOW METAL DOOR	HOLLOW METAL	3'-0" x 6'-8"	PAINT	PAINT	-	1	NEW
D	TEMPERED GLASS DOOR	ALUMINUM	3'-0" x 7'-0"	TEMPERED GLASS	ALUMINUM	-	2	NEW
E	SLIDE WOOD DOOR	ALUMINUM	3'-0" x 6'-8"	PAINT	PAINT	-	3	NEW
	* ALL EXIT DOORS MUST	OPEN WITHOUT THE USE	OF A KEY OR S	PECIAL KNOWLED	GE FROM TH	E SIDE	WHICH EGRESS I	SMADE
	* LEVERED HANDLE HARD	WARE AS REQUIRED BY	ILLINOIS ACCES	SSIBILITY CODE				
	* PROVIDE DOOR CLOSE	RS ALONG ALL ACCESSI	BLE ROUTES					

	HARDWARE SCHEDULE
TAG	DESCRIPTION
1	3 HINGES, W/LEVERED PRIVACY LOCKSET , KICKPLATE AND DOOR CLOSER
2	PADDLE LATCH EXIT DEVICE AND DOOR CLOSER, PANIC HARDWARE
3	PRIVACY LOCKET

COOKLINE EQUIPMENT AND REACH-IN REFRIGERATION AND FREEZER UNITS TO BE INSTALLED ON CASTERS. NSF STAINLESS STEEL SHELF OVER 3-COMPTMENT SINK. ICE MAKER A MIN. 8" FROM ALL WALLS. HEAVY-DUTY MOP RACKS LOCATED OVER MOP SINK. HEAVY-DUTY BROOM RACKS IN JANITORIAL AREA. METAL GARBAGE CANS WITH LIDS FOR RESTROOMS.SANITARY BOX IN WOMEN'S RESTROOMS. METAL GARBAGE CANS WITH LIDS FOR DIAPER CHANGING STATION.

ALL NSF APPROVED HAND SINKS TO BE WITH BLADE HANDLED FAUCETS. COUNTER TOP -STAINLESS STEEL ALL CABINET SHELVES -STAINLESS STEEL. ALL CABINET BASE - 6" STAINLESS STEEL LEGS (NO KICK BASE) LAVATORY COUNTERTOP TO BE SOLID SURFACE (NO PLASTIC LAMINATE OR CABINETRY) ANY PAINTED FINISHES TO BE SEMI-GLOSS OR GLOSS (NO FLAT. NO EGG SHELL.NO TEXTURE). PROVIDE FRP ON KITCHEN WALL. STAINLESS STEEL WALL FINISH FOR BEHIND AND ADJACENT TO COOK LINE

• Dial stem thermometers (ranging from 0° to 220°F) are required in all preparation areas.

- Chemical test kits (specific to the sanitizer) are required for the appropriate sanitizer.
- pH meter and log for acidifying rice.
- All cooling/freezing units must have accurate thermometers.
- Covered waste cans are required in all restrooms.
- Toilets, urinals, hand sinks, 3 compartment sinks, mop sink, prep sinks, and permanent counters/cabinets must be sealed to floors and walls with a silicone caulk seal.
- Anti-siphon devices are required on all toilet tanks, urinals, and faucets with hose connections.
- Soap and paper towels are required at all hand sinks.
- Provide hair restraints and disposable gloves for all food handlers.

If sinks are provided with spring-loaded faucets, the faucets must remain running for a minimum of 15 seconds

Doors leading to the outside and restroom doors are required to be self-closing and tight-fitting. Please confirm that the doors leading to the outside are equipped with a self-closer and weather strips to eliminate any air gaps.

#### KITCHEN EQUIPMENT NOTES

CONTRACTOR SHALL INSTALL AND CONNECT ALL EQUIPMENT AS PER EQUIPMENT SUPPLIER'S SPECIFICATIONS. ALL LOCATIONS TO BE VERIFIED WITH OWNER PRIOR TO INSTALLATION.

PLUMBING CONTRACTOR SHALL PROVIDE ALL ROUGH-INS. INSULATE ALL COLD/HOT WATER PIPES AS REQUIRED. MAINTAIN MIN 36" IN FRONT OF ALL COOKING EQUIPMENT.

ELECTRICAL CONTRACTOR SHALL PROVIDE ALL ELECTRICAL OUTLETS FOR EQUIPMENT. VERIFY ALL ELECTRICAL REQUIREMENTS WITH EQUIPMENT SUPPLIER. VERIFY ALL GAS AND WATER REQUIREMENTS WITH EQUIPMENT SUPPLIER.

ALL PERMANENT EQUIPMENT MUST BE LOCATED SO THAT AREAS BEHIND, UNDERNEATH, AND ON THE SIDES OF THE EQUIPMENT CAN BE EASILY CLEANED.

TWO DRAIN BOARDS ARE REQUIRED AT ALL THREE-COMPARTMENT SINKS ALONG WITH AN APPROPRIATELY SIZED FAUCET, LOCKABLE DRAIN PLUGS, AND AN INDIRECT CONNECTION TO THE SEWER.


#### DRY STORAGE


DRY STORAGE: 25% OF 104SF (KITCHEN AREA.) = 26SF REQ'D ACTUAL DRY STORAGE 32SF PROVIDED. 1SHELVING X 4X4X2 = 32SF

ALL FOOD AND FOOD RELATED ITEMS MUST BE STORED OFF THE FLOOR ON DURABLE WASHABLE SHELVES. THE STORAGE AREA MUST BE APPROPRIATELY SIZED BASED ON THE NUMBER OF MEALS SERVED DAILY AND THE NUMBER OF DELIVERIES WEEKLY.

ALL FOOD EQUIPMENT TO BE ON CASTERS, 6" LEGS, OR SEALED TO THE FLOOR FOR EASY CLEANING.

NO RAW WOOD SURFACES PERMITTED ANYWHERE. UNDERSIDES OF COUNTERTOPS, INSIDE OF CABINETRY, AND WATER HEATER PLATFORMS

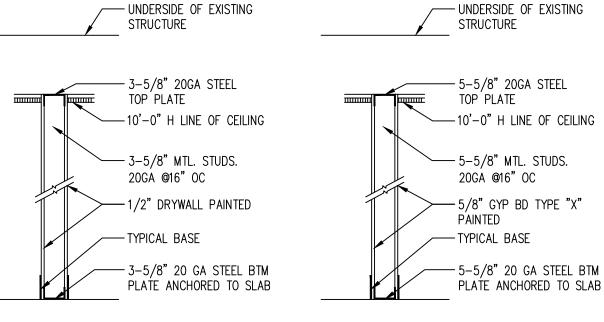

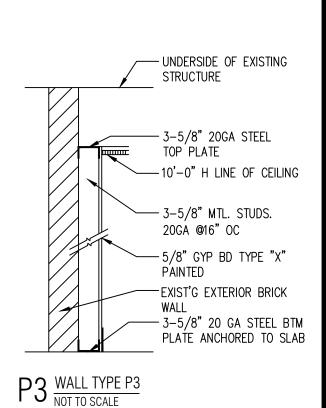

TW ARCHITECT INC 2425 S WENTWORTH AVE. CHICAGO IL 60616

PHONE: (312) 912-5798 EMAIL: twarchitect98@yahoo.com

LICENSE NO: 001-022013 EXPIRES: 11/30/2024


> 6061 Ш  $\bigcirc$  $\geq$




11/01/2022

SSUED FOR PERMIT

FLOOR PLAN & NOTES

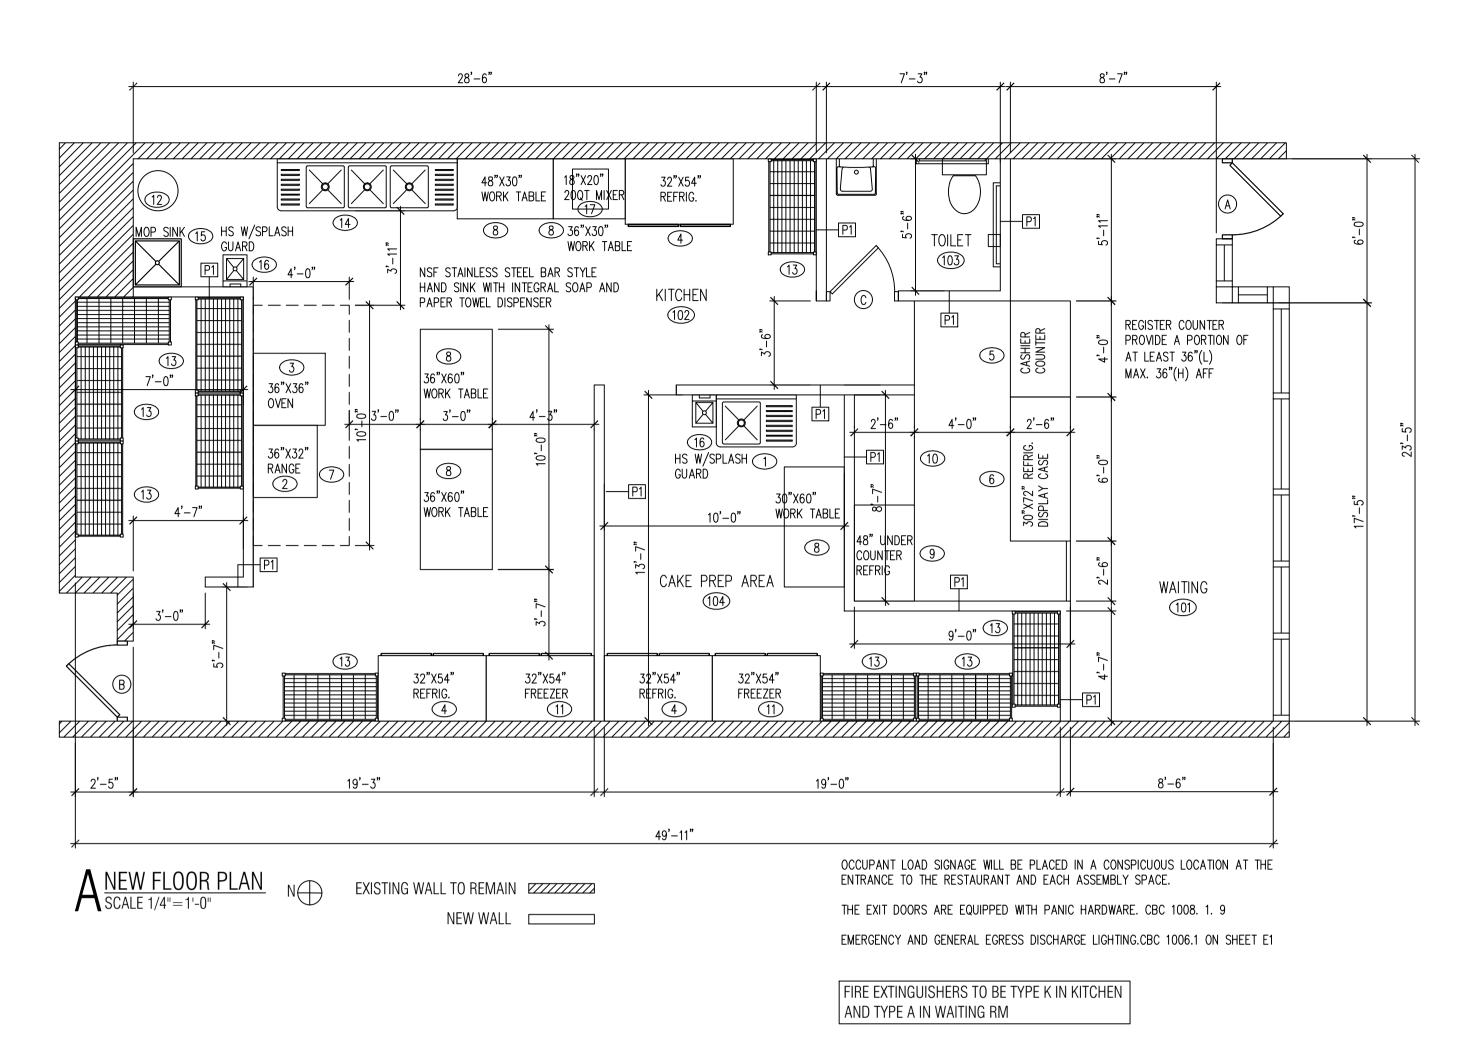

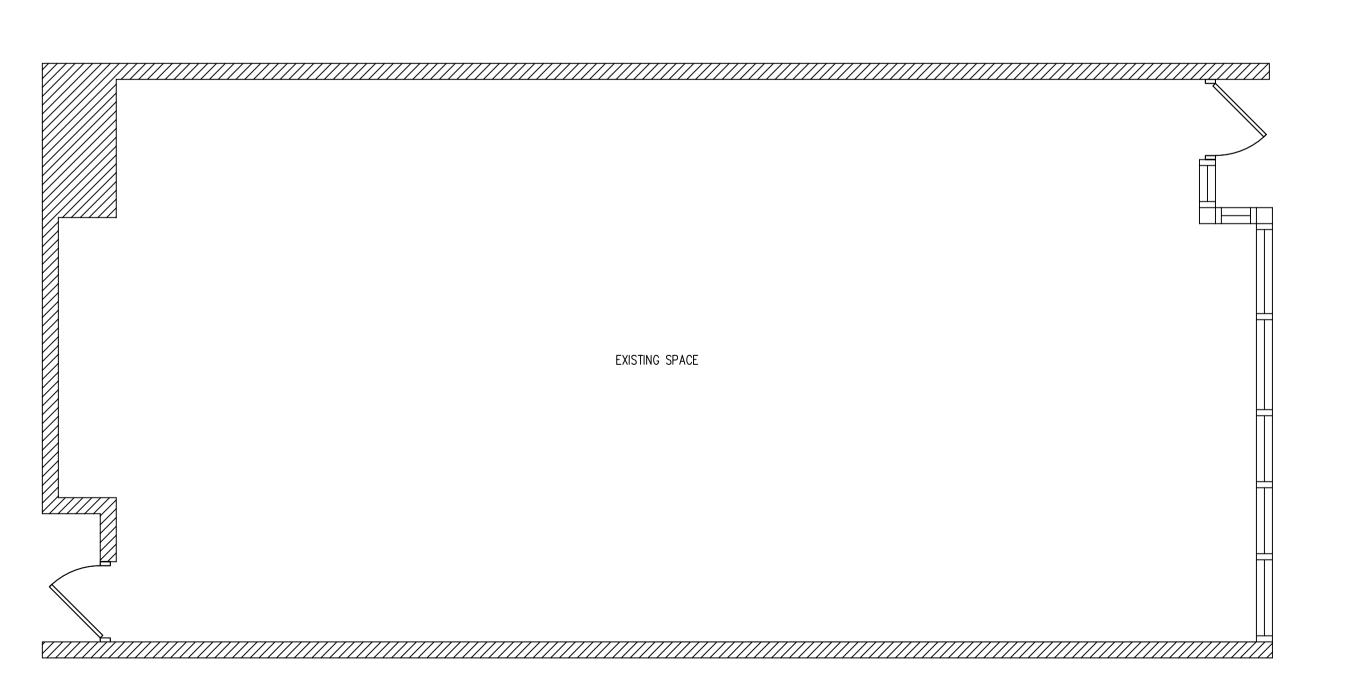





PMD 11 B
INTERIOR REMODELING OF THE EXISTING
SPACE TO A NEW RETAIL BAKERY SALES
SUITE 104..INCLUDING ARCHITECTURAL,
ELECTRICAL, HVAC AND PLUMBING WORK.
7-13-2022

1 1 2 1 3 2		GAS				
	DDED OUT		ELECTF	RIC	PLUMBING	REMARKS
	PREP SINK	-	-	-	1/2"CW,1/2" HW, 4" INDIRECT DRAIN	NSF
2	36"X32" RANGE	3/4"	-	-	-	NSF, 110000 BTU
	36"X36" OVEN		240V	40A	-	NSF
3	32"X54" REFRIG.	-	120V	2.5A	-	NSF,W/ CASTERS
j 1	CASH COUNTER	-	_	-	_	NSF
1	30"X72" REFRIG. DISPLAY CASE	-	120V	4A		NSF
1	10'X4' EXHAUST HOOD, TYPE I	<u> </u>	-	-	-	U.L. W/ANSUL FIRE SUPPRESSION SYSTEM
5	WORK TABLE	-	-	-	-	NSF,W/ 6" STAINLESS STEEL LEGS NSF APPROVED
1	48" UNDER COUNTER REFRIG	_	120V	ЗА	_	NSF
0 1	STAINLESS STEEL COUNTER	-			-	NSF
1 2	32"X54" FREEZER	_	120V	4A	-	NSF
2 1	HOT WATER HEATER	3/4"	120V	-	3/4" CW & 3/4" HW	NSF, 50GALLONS
3 10	SHELVING	-	-	-	-	NSF APPROVED STAINLESS STEEL SHELVING
4 1	3 COMPARTMENT SINK	_	_	_	1/2" CW,1/2" HW,4" INDIRECT DRAIN	NSF,W/ ECOLAB PATHWAY TO PREVENT BACKFLOW
5 1	MOP SINK/A FLOOR BASIN UNIT	_	-		1/2"CW,1/2" HW, 4" DRAIN	NSF, W/ MOP HOOKS, SEAL EDGES
6 2	HAND SINK	_	_	-	1/2" CW,1/2" HW, 2" DRAIN	NSF, WALL MOUNTED - SEALED
7 1	20 QT MIXER	-	120V	10A	-	NSF

	ROOM FINISH SCHEDULE								
NO	ROOM	WALLS	BASE	FLOOR	CEILING				
101	WAITING AREA	GYP. BD. PAINTED	QT COVE BASE	FLOOR TILE	OPEN CEILING				
102	KITCHEN	STAINLESS STEEL	QT COVE BASE	QUARRY TILE	2'X4' VINYL TILE CLG.				
103	TOILET	GYP. BD. PAINTED	QT COVE BASE	FLOOR TILE	2'X4' VINYL TILE CLG.				
104	CAKE PREP AREA	STAINLESS STEEL	QT COVE BASE	QUARRY TILE	2'X4' VINYL TILE CLG.				

DOOR SCHEDULE								
TAG	DESCRIPTION	FRAME CONSTRUCTION		DOOR FINISH	FRAME FINISH	LABEL	HARDWARE SET	COMMENTS
WXH								
Α	STORE FRONT GLASS DOOR	ALUMINUM	3'-0" x 7'-0"	TEMPERED GLASS	ALUMINUM	-	2	EXIST'G FRONT EXIT DOOR
В	METAL DOOR	HOLLOW METAL	3'-0" x 7'-0"	PAINT	PAINT	-	2	EXIST'G
С	WOOD DOOR	WOOD	3'-0" x 6'-8"	PAINT	PAINT	-	1	NEW
* ALL EXIT DOORS MUST OPEN WITHOUT THE USE OF A KEY OR SPECIAL KNOWLEDGE FROM THE SIDE WHICH EGRESS IS MADE								
* LEVERED HANDLE HARDWARE AS REQUIRED BY ILLINOIS ACCESSIBILITY CODE								
	* PROVIDE DOOR CLOSE	RS ALONG ALL ACCESSI	BLE ROUTES					

	HARDWARE SCHEDULE						
TAG	DESCRIPTION						
1	3 HINGES, W/LEVERED PRIVACY LOCKSET, KICKPLATE AND DOOR CLOSER						
2	PADDLE LATCH EXIT DEVICE AND DOOR CLOSER, PANIC HARDWARE						
3	PRIVACY LOCKET						

COOKLINE EQUIPMENT AND REACH-IN REFRIGERATION AND FREEZER UNITS TO BE INSTALLED ON CASTERS. NSF STAINLESS STEEL SHELF OVER 3-COMPTMENT SINK. HEAVY-DUTY MOP RACKS LOCATED OVER MOP SINK. HEAVY-DUTY BROOM RACKS IN JANITORIAL AREA. METAL GARBAGE CANS WITH LIDS FOR RESTROOMS. SANITARY BOX IN WOMEN'S RESTROOMS.

ALL NSF APPROVED HAND SINKS TO BE WITH BLADE HANDLED FAUCETS.
WAITRESS, BEVERAGE STATION & BAR COUNTER TOP -STAINLESS STEEL.
ALL CABINET SHELVES -STAINLESS STEEL.
ALL CABINET BASE - 6" STAINLESS STEEL LEGS (NO KICK BASE)
LAVATORY COUNTERTOP TO BE SOLID SURFACE (NO PLASTIC LAMINATE OR CABINETRY)
ANY PAINTED FINISHES TO BE SEMI-GLOSS OR GLOSS (NO FLAT, NO EGG SHELL, NO TEXTURE),
PROVIDE FRP ON WALL AND UNDERSIDE OF BAR.
STAINLESS STEEL WALL FINISH FOR BEHIND AND ADJACENT TO COOK LINE

## KITCHEN EQUIPMENT NOTES

CONTRACTOR SHALL INSTALL AND CONNECT ALL EQUIPMENT AS PER EQUIPMENT SUPPLIER'S SPECIFICATIONS. ALL LOCATIONS TO BE VERIFIED WITH OWNER PRIOR TO INSTALLATION.

PLUMBING CONTRACTOR SHALL PROVIDE ALL ROUGH-INS. INSULATE ALL COLD/HOT WATER PIPES AS REQUIRED. MAINTAIN MIN 36" IN FRONT OF ALL COOKING EQUIPMENT.

ELECTRICAL CONTRACTOR SHALL PROVIDE ALL ELECTRICAL OUTLETS FOR EQUIPMENT. VERIFY ALL ELECTRICAL REQUIREMENTS WITH EQUIPMENT SUPPLIER. VERIFY ALL GAS AND WATER REQUIREMENTS WITH EQUIPMENT SUPPLIER.

ALL PERMANENT EQUIPMENT MUST BE LOCATED SO THAT AREAS BEHIND, UNDERNEATH, AND ON THE SIDES OF THE EQUIPMENT CAN BE EASILY CLEANED.

TWO DRAIN BOARDS ARE REQUIRED AT ALL THREE-COMPARTMENT SINKS ALONG WITH AN APPROPRIATELY SIZED FAUCET, LOCKABLE DRAIN PLUGS, AND AN INDIRECT CONNECTION TO THE SEWER.

#### DRY STORAGE


DRY STORAGE: 25% OF 900SF (KITCHEN AREA.) = 225SF REQ'D ACTUAL DRY STORAGE 160SF PROVIDED.

10 SHELVINGS X 4X4X2 = 320 SF

ALL FOOD AND FOOD RELATED ITEMS MUST BE STORED OFF THE FLOOR ON DURABLE WASHABLE SHELVES. THE STORAGE AREA MUST BE APPROPRIATELY SIZED BASED ON THE NUMBER OF MEALS SERVED DAILY AND THE NUMBER OF DELIVERIES WEEKLY.

ALL FOOD EQUIPMENT TO BE ON CASTERS, 6" LEGS, OR SEALED TO THE FLOOR FOR EASY CLEANING.

NO RAW WOOD SURFACES PERMITTED ANYWHERE. UNDERSIDES OF COUNTERTOPS, INSIDE OF CABINETRY, AND WATER HEATER PLATFORMS MUST BE SEALED.

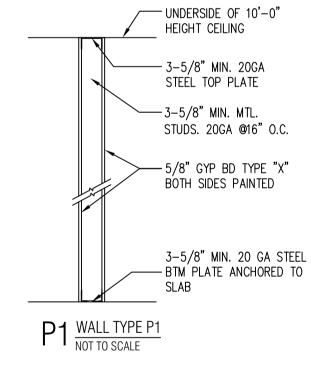

- Dial stem thermometers (ranging from 0° to 220°F) are required in all preparation areas.
- Chemical test kits (specific to the sanitizer) are required for the appropriate sanitizer.
- pH meter and log for acidifying rice.
- All cooling/freezing units must have accurate thermometers.
- Covered waste cans are required in all restrooms.
- Toilets, urinals, hand sinks, 3 compartment sinks, mop sink, prep sinks, and permanent counters/cabinets must be sealed to floors and walls with a silicone caulk seal.
- Anti-siphon devices are required on all toilet tanks, urinals, and faucets with hose connections.
- Soap and paper towels are required at all hand sinks.
- Provide hair restraints and disposable gloves for all food handlers.

If sinks are provided with spring-loaded faucets, the faucets must remain running for a minimum of 15 seconds

Doors leading to the outside and restroom doors are required to be self-closing and tight-fitting. Please confirm that the doors leading to the outside are equipped with a self-closer and weather strips to eliminate any air gaps.

STANDARD PLAN REVIEW
CONDITIONAL
PERMIT
Construction subject to full compliance with the Municipal Code of Chicago and field inspection
Building
Commissioner

SELF CERTIFICATION

TW ARCHITECT INC 2425 S WENTWORTH AVE CHICAGO IL 60616

Phone: (312) 912-5798 Email: twarchitect98@yahoo.com

LICENSE NO: 001-022013 EXPIRES: 11/30/2022

INTERIOR REMODELING


ISSUES DATE
ISSUED FOR PERMIT 04/08/2022




FLOOR PLANS & NOTES

SHEET NUMBER

A2

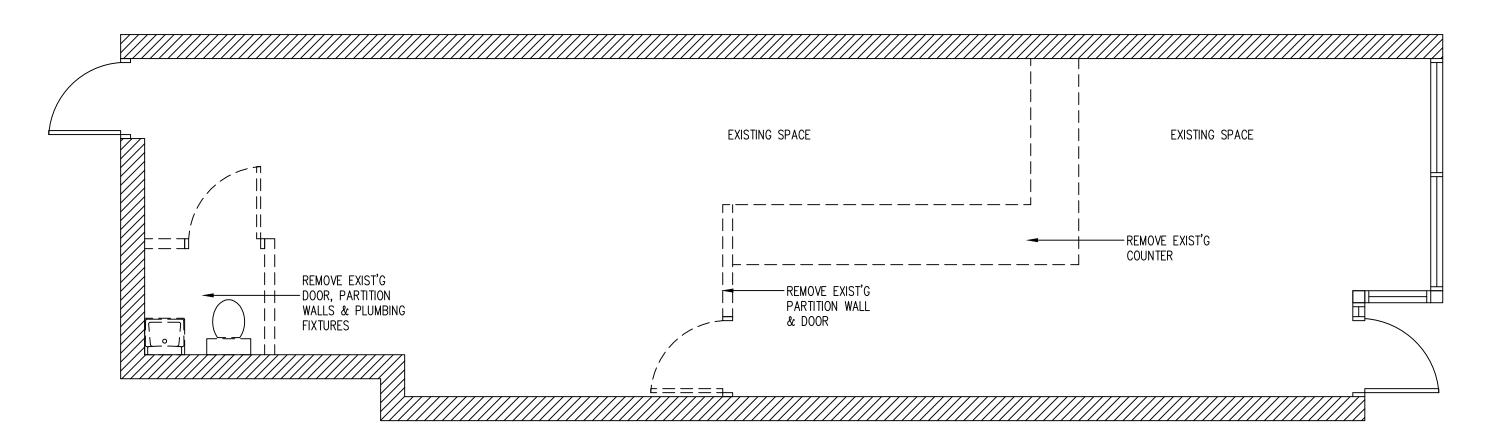

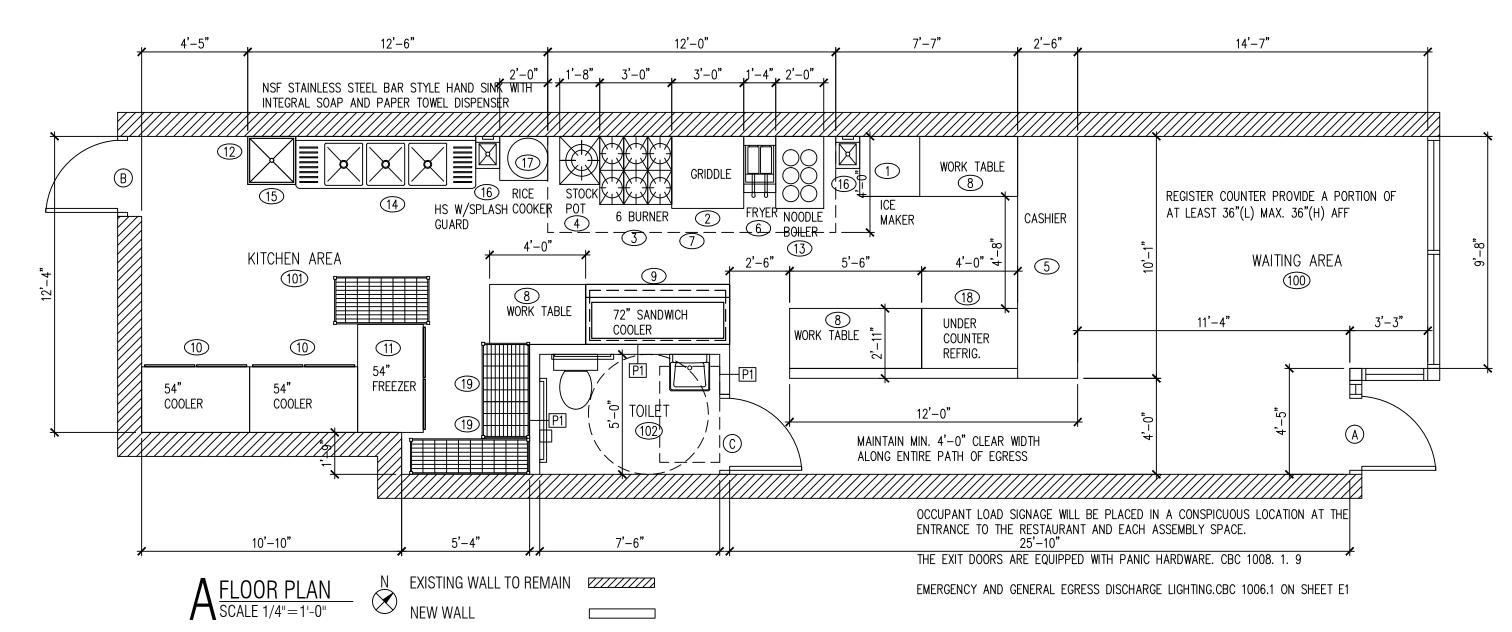

•	Dial stem thermometers (ranging from 0° to 220°F) are required in all preparation areas.

- Chemical test kits (specific to the sanitizer) are required for the appropriate sanitizer
- pH meter and log for acidifying rice.
- All cooling/freezing units must have accurate thermometers.
- Covered waste cans are required in all restrooms.
- Toilets, urinals, hand sinks, 3 compartment sinks, mop sink, prep sinks, and permanent
- Anti-siphon devices are required on all toilet tanks, urinals, and faucets with hose

counters/cabinets must be sealed to floors and walls with a silicone caulk seal.

- Soap and paper towels are required at all hand sinks.
- Provide hair restraints and disposable gloves for all food handlers.

If sinks are provided with spring-loaded faucets, the faucets must remain running for a minimum

Doors leading to the outside and restroom doors are required to be self-closing and tight-fitting. Please confirm that the doors leading to the outside are equipped with a self-closer and weather strips to eliminate any air gaps.

#### DRY STORAGE

DRY STORAGE: 25% OF 320SF (KITCHEN AREA.) = 80SF REQ'D ACTUAL DRY STORAGE 96SF PROVIDED. 3SHELVINGS X 4X4X2 = 96SF

ALL FOOD AND FOOD RELATED ITEMS MUST BE STORED OFF THE FLOOR ON DURABLE WASHABLE SHELVES. THE STORAGE AREA MUST BE APPROPRIATELY SIZED BASED ON THE NUMBER OF MEALS SERVED DAILY AND THE NUMBER OF DELIVERIES WEEKLY.

ALL FOOD EQUIPMENT TO BE ON CASTERS, 6" LEGS, OR SEALED TO THE FLOOR FOR EASY CLEANING.


NO RAW WOOD SURFACES PERMITTED ANYWHERE. UNDERSIDES OF COUNTERTOPS, INSIDE OF CABINETRY, AND WATER HEATER PLATFORMS MUST BE SEALED.


COOKLINE EQUIPMENT AND REACH-IN REFRIGERATION AND FREEZER UNITS TO BE INSTALLED ON CASTERS. NSF STAINLESS STEEL SHELF OVER 3-COMPTMENT SINK. ICE MAKER A MIN. 8" FROM ALL WALLS. HEAVY-DUTY MOP RACKS LOCATED OVER MOP SINK. HEAVY-DUTY BROOM RACKS IN JANITORIAL AREA. METAL GARBAGE CANS WITH LIDS FOR RESTROOMS.

ALL NSF APPROVED HAND SINKS TO BE WITH BLADE HANDLED FAUCETS. WAITRESS, BEVERAGE STATION & BAR COUNTER TOP -STAINLESS STEEL ALL CABINET SHELVES -STAINLESS STEEL ALL CABINET BASE - 6" STAINLESS STEEL LEGS (NO KICK BASE)

LAVATORY COUNTERTOP TO BE SOLID SURFACE (NO PLASTIC LAMINATE OR CABINETRY) ANY PAINTED FINISHES TO BE SEMI-GLOSS OR GLOSS (NO FLAT, NO EGG SHELL, NO TEXTURE), PROVIDE FRP ON WALL AND UNDERSIDE OF BAR.

STAINLESS STEEL WALL FINISH FOR BEHIND AND ADJACENT TO COOK LINE

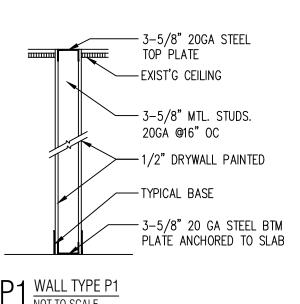

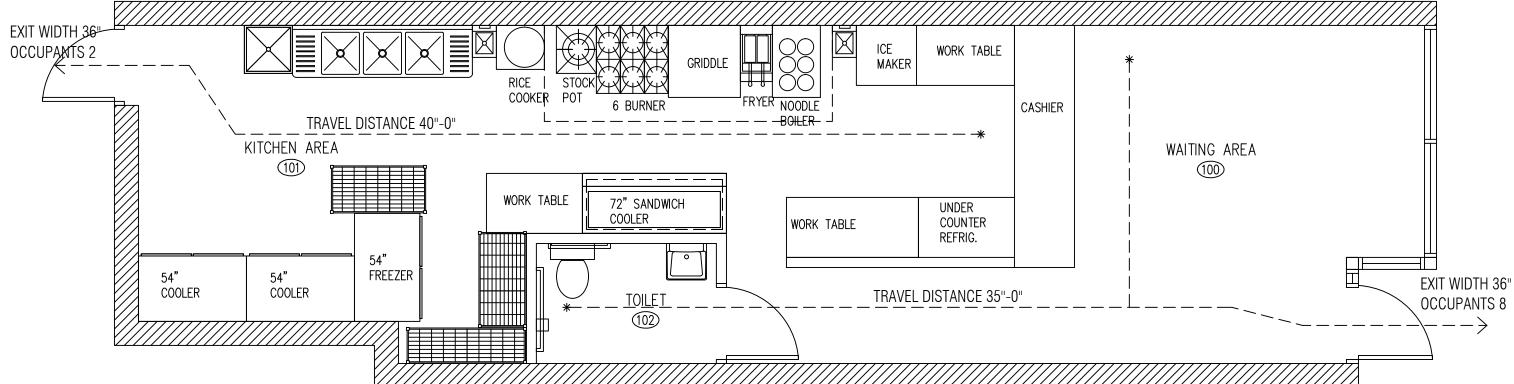

# ↑ OCCUPANCY & EXITING DIAGRAM

EQUIPMENT SCHEDULE							
NO	QTY	DESCRIPTION	GAS	ELEC	CTRIC	PLUMBING	REMARKS
1	1	ICE MAKER	-	240V	6A	3/8" CW, 4" INDIRECT DRAIN	NSF,AIR COOLED CONDENSING UNIT
2	1	GRIDDLE		240V	T.	-	NSF ELECTRIC
3	1	6 BURNER	3/4"	_	ī	-	NSF, 90000 BTU
4	1	STOCK POT	3/4"	-	ī	-	NSF, 90000 BTU
5	1	COUNTER W/CABINETS	-	-	ī	H	NSF
6	1	DEEP FRYER W/CASTERS	3/4"	-	ē	_	NSF, 110000 BTU
7	1	12'-0"X4'-0" EXHAUST HOOD,TYPE I	-	-	1	-	U.L. W/ANSUL FIRE SUPPRESSION SYSTEM
8	3	WORK TABLE	-	_	·	-	NSF,W/ 6" STAINLESS STEEL LEGS NSF APPROVED
9	1	PREP COOLER	-	120V	4A	_	NSF,W/ CASTERS
10	2	54" REFRIG.	-	120V	5A	_	NSF
11	1	54" FREEZER	_	120V	5A	_	NSF
12	1	TANKLESS HOT WATER HEATER	3/4"	120V	ī	3/4" CW & 3/4" HW	NSF, 100000 BTU
13	1	NOODLE BOILER	3/4"	-	e	_	NSF, 90000 BTU
14	1	3 COMPARTMENT SINK	-	-	-	1/2" CW,1/2" HW,4" INDIRECT DRAIN	NSF,W/ ECOLAB PATHWAY TO PREVENT BACKFLOW
15	1	MOP SINK	-	-		1/2"CW,1/2" HW, 4" DRAIN	NSF, W/ MOP HOOKS, SEAL EDGES
16	2	HAND SINK	_	_	1	1/2" CW,1/2" HW, 2" DRAIN	NSF, WALL MOUNTED - SEALED
17	1	ELECTRIC RICE COOKER	-	240V	ı	-	NSF
18	1	UNDER COUNTER REFRIG.	_	120V	4A	_	NSF
19	3	STAINLESS STEEL SHELVING	-			-	NSF
\LL	EQUIP	PMENTS WILL BE NSF APPROVED CLEAN,OPER	RABLE AND S	UBJECT TO	THE FINAL APPROVAL BY	THE HEALTH	

DEPARTMENT

	ROOM FINISH SCHEDULE							
NO	NO ROOM WALLS BASE FLOOR CEILING							
100	WAITING AREA	GYP. BD. PAINTED	QT COVE BASE	FLOOR TILE	OPEN CEILING			
101	KITCHEN	STAINLESS STEEL	QT COVE BASE	QUARRY TILE	2'X4' VINYL TILE CLG.			
102	TOILET	CERAMIC TILE	QT COVE BASE	FLOOR TILE	2'X4' TILE CLG.			

	DOOR SCHEDULE							
TAG	TAG DESCRIPTION FRAME CONSTRUCTION NOMINAL SIZE DOOR FINISH FRAME FINISH LABEL HARDWARE SET COMMENTS							
			WXH					
Α	STORE FRONT GLASS DOOR	ALUMINUM	3'-0" x 7'-0"	TEMPERED GLASS	ALUMINUM -	2	EXIST'G FRONT EXIT DOOR	
В	HOLLOW METAL DOOR	HOLLOW METAL	3'-0" x 7'-0"	PAINT	ALUMINUM -	2	EXIST'G BACK DOOR	
С	C WOOD DOOR HOLLOW METAL 3'-0" x 6'-8" PAINT - 1 NEW							
	* ALL EXIT DOORS MUST OPEN WITHOUT THE USE OF A KEY OR SPECIAL KNOWLEDGE FROM THE SIDE WHICH EGRESS IS MADE							
	* LEVERED HANDLE HARD	OWARE AS REQUIRED BY	/ ILLINOIS ACCES	SSIBILITY CODE				

HARDWARE SCHEDULE						
TAG	DESCRIPTION					
1	3 HINGES, W/LEVERED PRIVACY LOCKSET , KICKPLATE AND DOOR CLOSER					
2	PADDLE LATCH EXIT DEVICE AND DOOR CLOSER, PANIC HARDWARE					
3	PRIVACY LOCKET					

\* PROVIDE DOOR CLOSERS ALONG ALL ACCESSIBLE ROUTES

#### KITCHEN EQUIPMENT NOTES

CONTRACTOR SHALL INSTALL AND CONNECT ALL EQUIPMENT AS PER EQUIPMENT SUPPLIER'S SPECIFICATIONS. ALL LOCATIONS TO BE VERIFIED WITH OWNER PRIOR TO INSTALLATION.

PLUMBING CONTRACTOR SHALL PROVIDE ALL ROUGH-INS. INSULATE ALL COLD/HOT WATER PIPES AS REQUIRED. MAINTAIN MIN 36" IN FRONT OF ALL COOKING EQUIPMENT.

ELECTRICAL CONTRACTOR SHALL PROVIDE ALL ELECTRICAL OUTLETS FOR EQUIPMENT. VERIFY ALL ELECTRICAL REQUIREMENTS WITH EQUIPMENT SUPPLIER. VERIFY ALL GAS AND WATER REQUIREMENTS WITH EQUIPMENT SUPPLIER.

ALL PERMANENT EQUIPMENT MUST BE LOCATED SO THAT AREAS BEHIND, UNDERNEATH, AND ON THE SIDES OF THE EQUIPMENT CAN BE EASILY CLEANED.

TWO DRAIN BOARDS ARE REQUIRED AT ALL THREE-COMPARTMENT SINKS ALONG WITH AN APPROPRIATELY SIZED FAUCET, LOCKABLE DRAIN PLUGS, AND AN INDIRECT CONNECTION TO THE SEWER.

TW ARCHITECT INC 2425 S WENTWORTH AVE. CHICAGO IL 60616

PHONE: (312) 912-5798 EMAIL: twarchitect98@yahoo.com

LICENSE NO: 001-022013 EXPIRES: 11/30/2024


 $\geq$ П 4


 $\Box$  $\angle$ 

 $\triangleleft$ 10/18 /2022 ISSUED FOR PERMIT



FLOOR PLAN & & DEMO PLAN

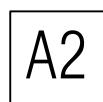

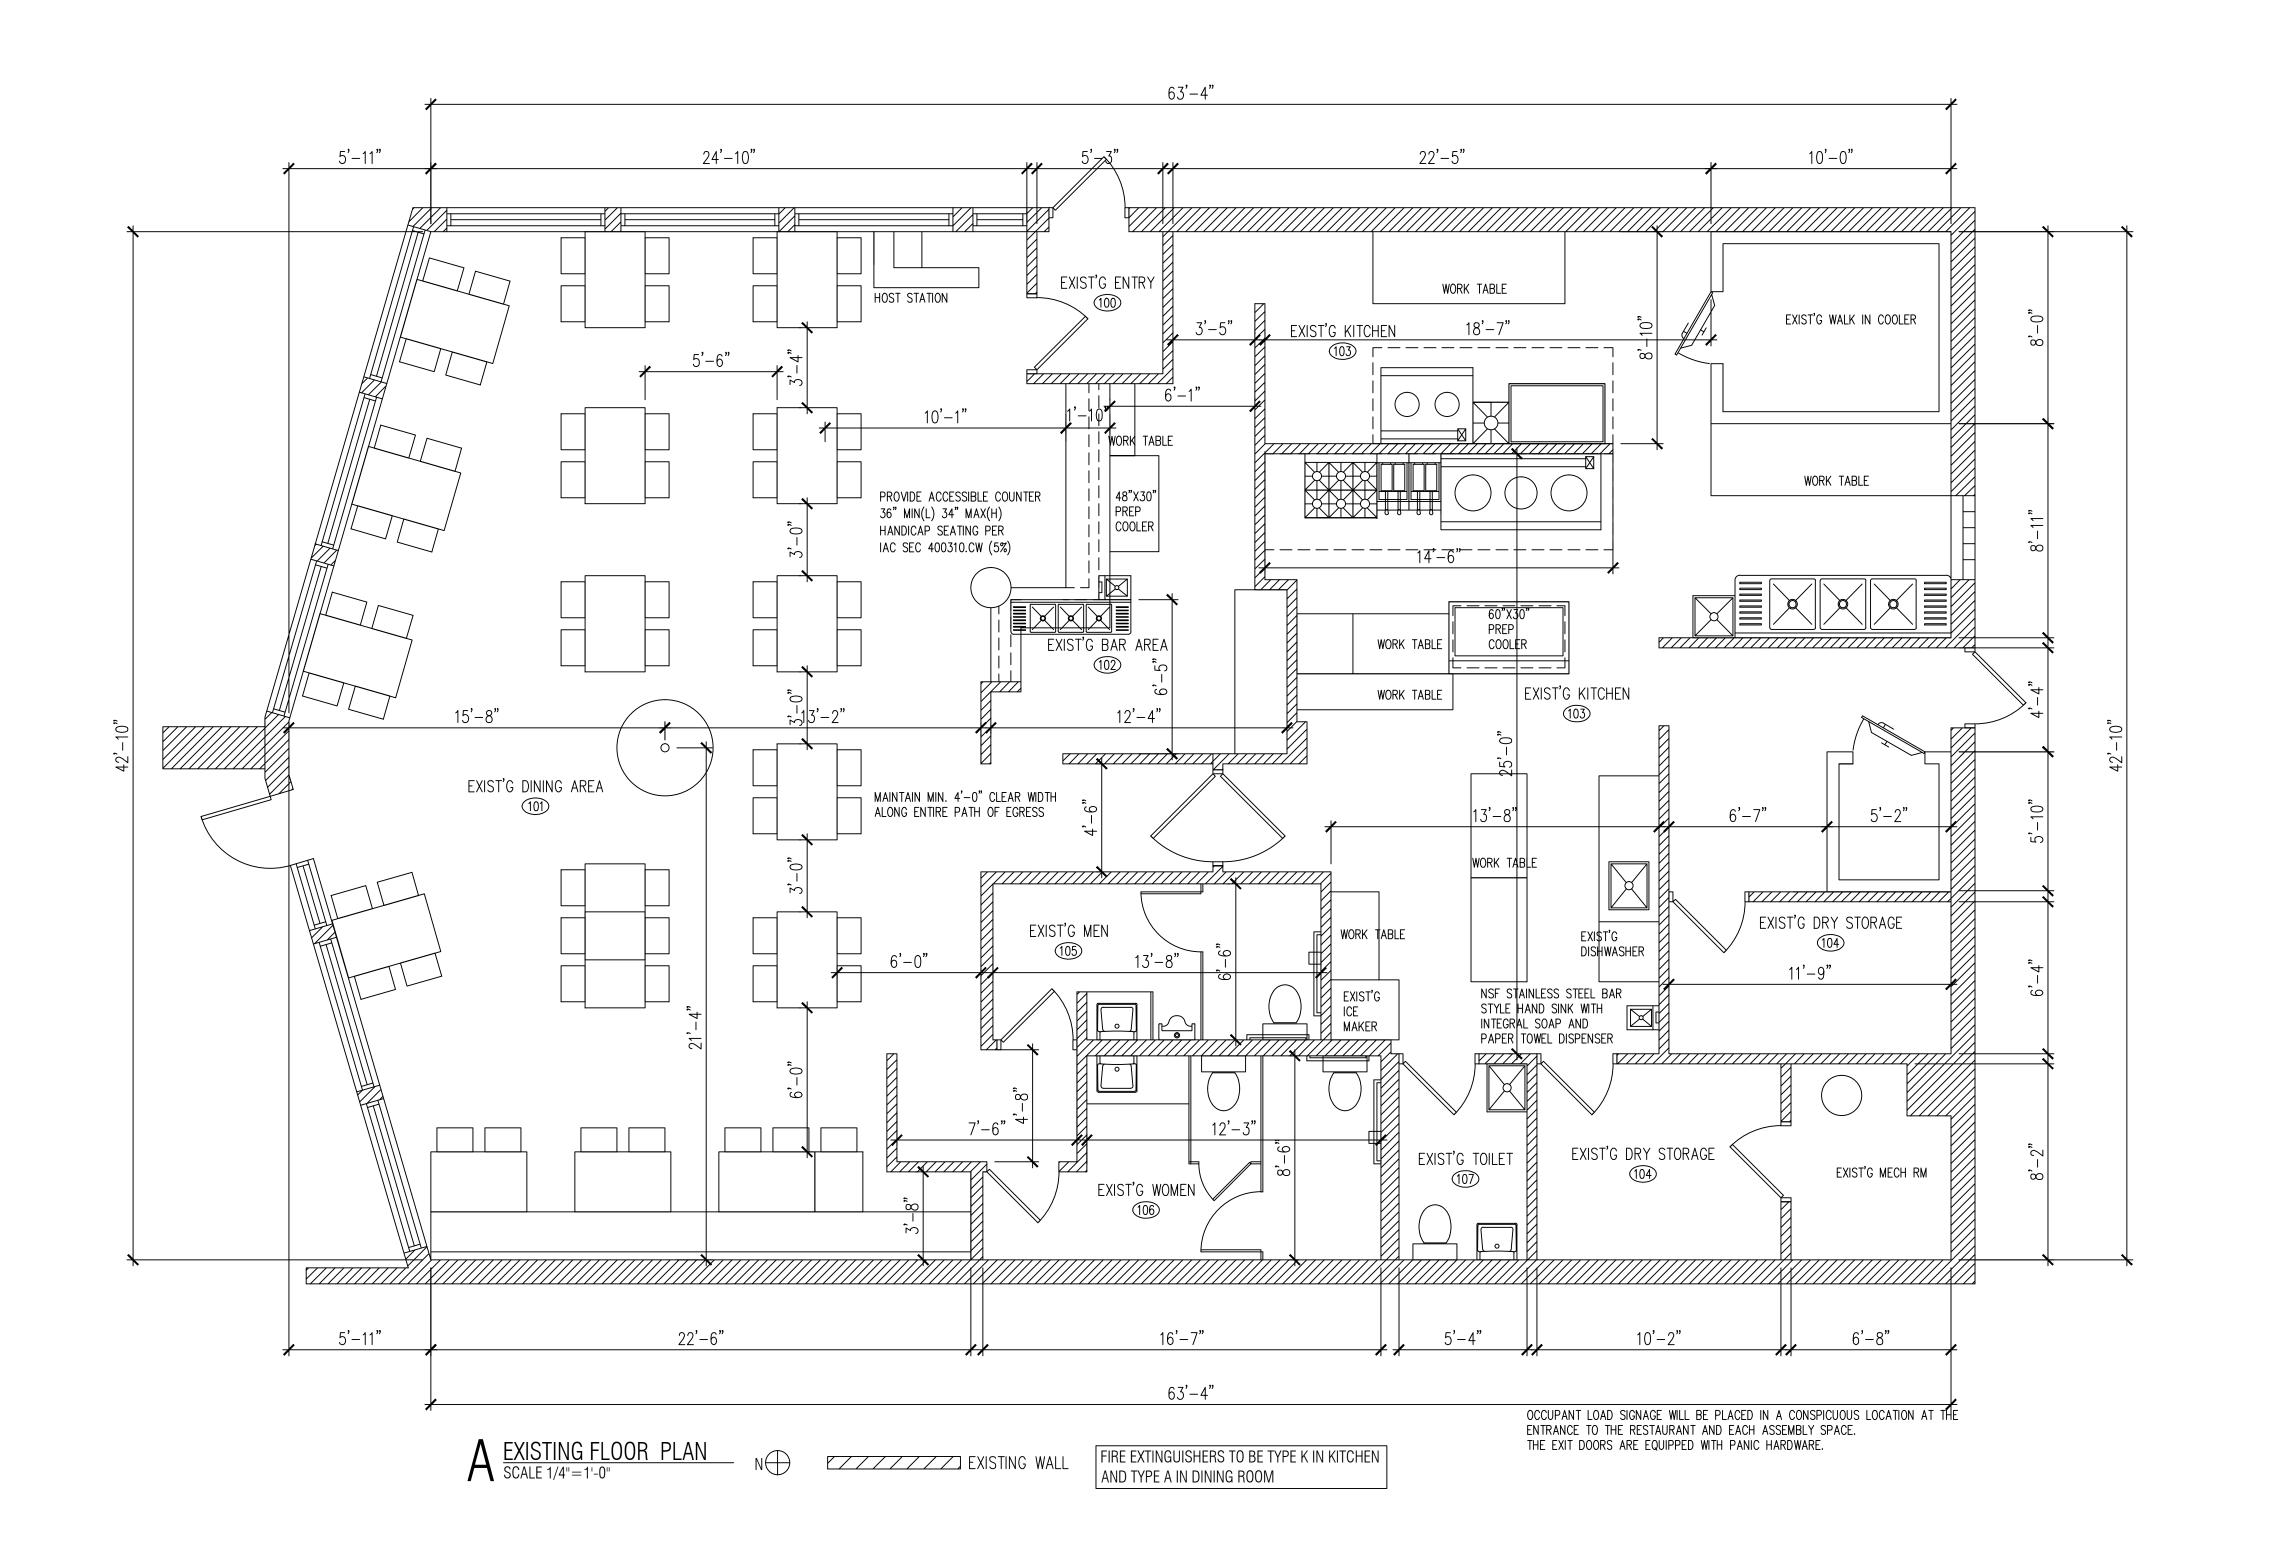

WEI TAN ARCHITECT 2425 S WENTWORTH AVE CHICAGO, IL 60616

PHONE: (312) 912-5798 EMAIL: twarchitect98@yahoo.com

LICENSE NO: 001-022013 EXPIRES: 11/30/2022

RESTAURANT
TERIOR REMODELING
2941 W 95TH STREET

ISSUES	DATE
ISSUED FOR PERMIT	06/15/2022



EXIST'G FLOOR PLAN

SHEET NUMBER

A1


MeCa

I HEREBY CERTIFY THAT THESE

LIC EXPIRES NOV 30, 2022

DRAWINGS ARE PREEPARED BY ME OR

UNDER MY SUPERVISION AND TO THE BEST OF MY KNOWLEDGE CONFORM WITH CHICAGO BUILDING CODE

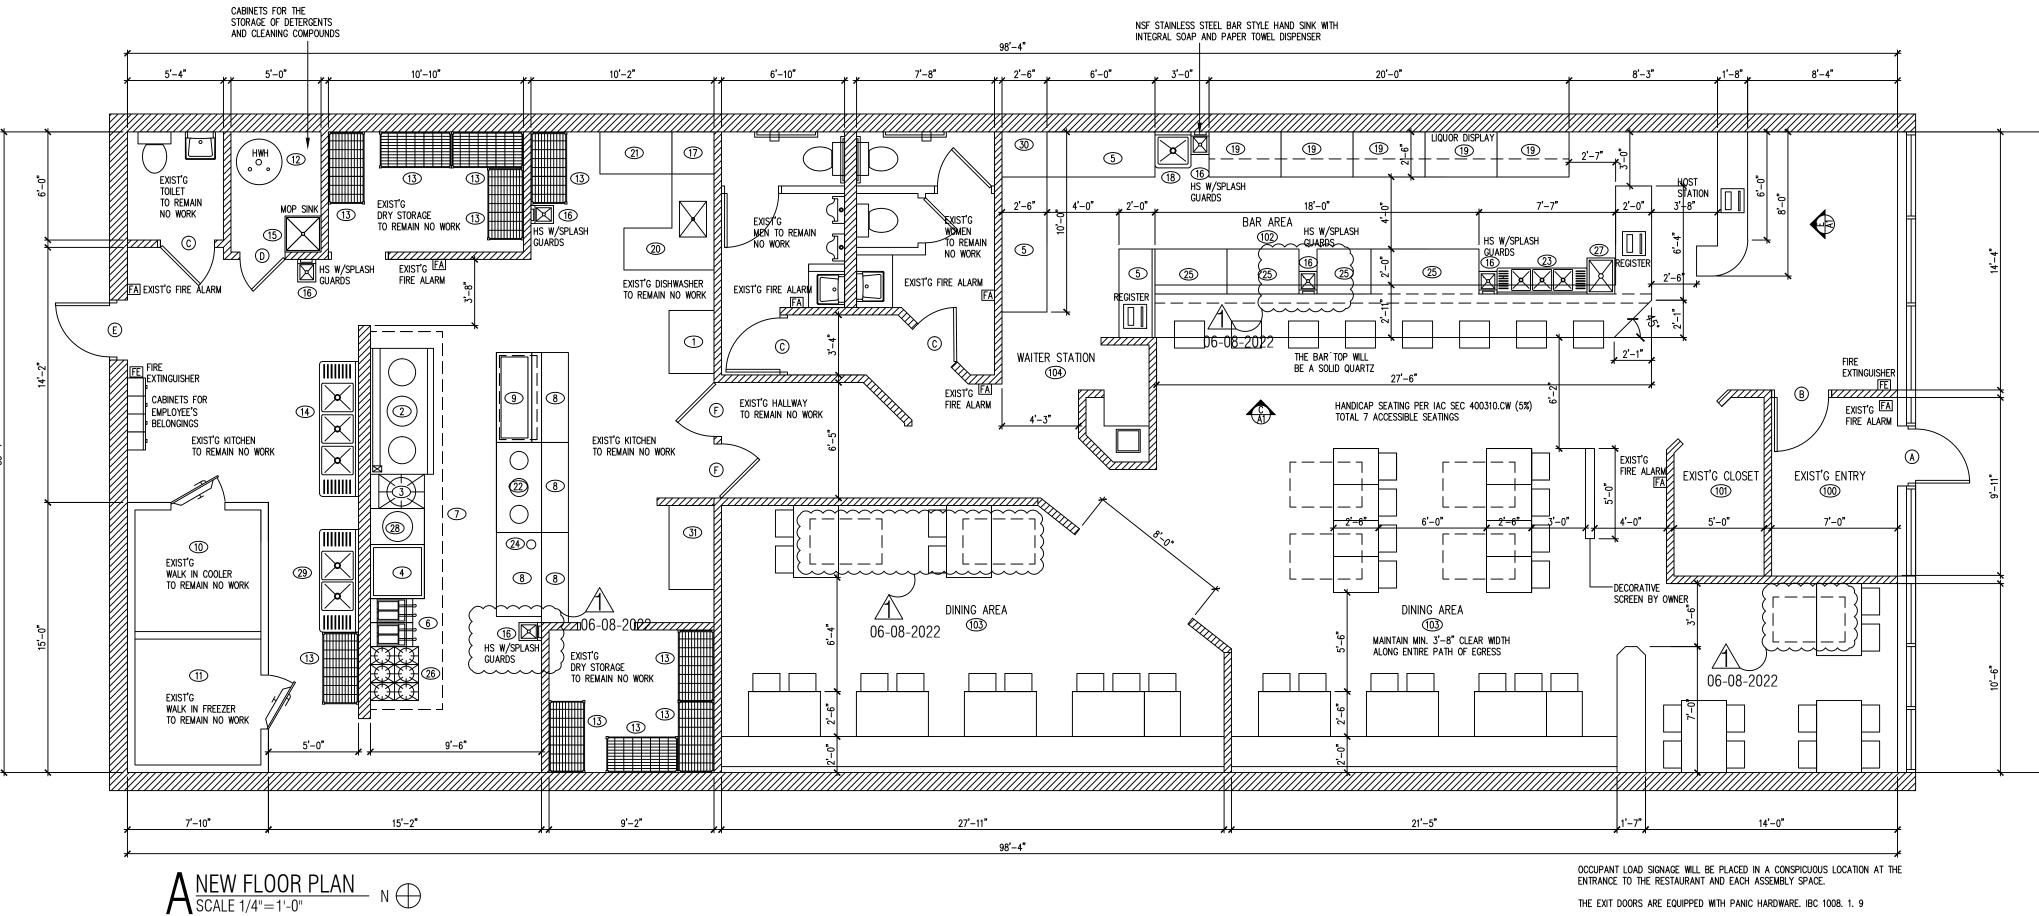

	ENTRANCE TO THE RESTAURANT AND EACH ASSEMBLY SPACE.
	THE EXIT DOORS ARE EQUIPPED WITH PANIC HARDWARE. IBC 1008. 1. 9
	EMERGENCY AND GENERAL EGRESS DISCHARGE LIGHTING. IBC 1006.1 ON SH

EQUIPMENT SCHEDULE								
IO QTY	DESCRIPTION	GAS	ELEC	TRIC	PLUMBING	REMARKS		
1	EXIST'G ICE MAKER		220V	9A	1/2"CW, 4" INDIRECT DRAIN	NSF,AIR COOLED CONDENSING UNIT		
1	EXIST'G 3 BURNER CHINESE WOK	1.5"	_	<u>=</u>	1/2"CW, 4" INDIRECT DRAIN	NSF, 330000 BTU		
1	EXIST'G SOUP POT	3/4"	_	-	-	NSF, 40000 BTU		
1	NEW 36" GRIDDLE	3/4"	=	H	-	NSF, 40000 BTU		
3	NEW STEEL COUNTER W/CABINETS	-	-	-	-	NSF		
2	EXIST'G DEEP FRYER W/CASTERS	3/4"	×	-	=	NSF, 110000 BTU		
1	EXIST'G 21'-0"X4'-0" EXHAUST HOOD, TYPE I	-	-	-	-	U.L. W/ANSUL FIRE SUPPRESSION SYSTEM		
5	WORK TABLE	-	-	-	-	NSF,W/ 6" STAINLESS STEEL LEGS NSF APPROVED		
1	EXIST'G REFRIGERATED PREP TABLE	1=	120V	4A	-	NSF,W/ CASTERS		
0 1	EXIST'G 7'-10"X7'-6" WLAK-IN COOLER	-	220V	9A	-	NSF		
1 1	EXIST'G 7'-10"X7'-6" WLAK-IN FREEZER		220V	9A	-	NSF		
2 1	HOT WATER HEATER	1"	120V	-	1.5" CW & 1.5" HW	NSF, 100GALLON 199000BTU		
3 10	SHELVING	i u	_	_	_	NSF APPROVED STAINLESS STEEL SHELVING		
4 1	EXIST'G 3 COMPARTMENT SINK		-	_	1/2" CW,1/2" HW,4" INDIRECT DRAIN	NSF,W/ ECOLAB PATHWAY TO PREVENT BACKFLOW		
5 1	EXIST'G MOP SINK/A FLOOR BASIN UNIT	2	_		1/2"CW,1/2" HW, 4" DRAIN	NSF, W/ MOP HOOKS, SEAL EDGES		
6 6	HAND SINK	-	-	-	1/2" CW,1/2" HW, 2" DRAIN	NSF, WALL MOUNTED - SEALED		
7 1	EXIST'G DISHWASHER	J	220V	1.5KW	1/2" HW, 4" DRAIN	NSF		
8 1	NEW PREP SINK	1	-1	-	1/2"CW,1/2" HW, 4" INDIRECT DRAIN	NSF, W/INTEGRAL DRAINBOARD		
9 5	NEW BAR COOLER	-	120V	4A	-	NSF,W/ CASTERS		
0 1	EXIST' 5' DISHTABLE (SOILED)	n <b>u</b>	-	-	1/2" HW, 4" INDIRECT DRAIN	NSF,W/ 6" STAINLESS STEEL LEGS NSF APPROVED		
1 1	EXIST'G 5' DISHTABLE (CLEAN)	ı <del>-</del>	-	-	·	NSF,W/ 6" STAINLESS STEEL LEGS NSF APPROVED		
2 1	EXIST'G FOOD WARMER	3/4"	-	=	1/2"CW,4" INDIRECT DRAIN	NSF, W/CASTER		
3 1	NEW 3 COMPARTMENT BAR SINK		_	<u>~</u>	1/2"CW,1/2" HW, 4" INDIRECT DRAIN	NSF,W/ ECOLAB PATHWAY TO PREVENT BACKFLOW		
4 1	NEW DIPPER WELL FOR RICE SCOOPS	1=	120V		-	NSF		
5 4	STAINLESS STEEL SERVICE TABLE	72	-	_	¥	NSF		
6 1	EXIST'G 6 BURNER RANGE	3/4"	-	-	-	NSF, 80000 BTU		
7 1	NEW 18"X24" ICE BIN	11-	-	-	3" INDIRECT DRAIN	NSF, W/CASTER		
8 1	NEW GAS RICE COOKER	1/2"	-	-	-	NSF, 40000 BTU		
9 1	EXIST'G 2 COMP SINK	-	-	-	1/2"CW,1/2" HW, 4" INDIRECT DRAIN	NSF		
0 1	NEW SODA DISPENSER	-	120V	¥	1/2"CW,4" INDIRECT DRAIN	NSF		
1 1	NEW 54" REFRIGERATOR	-	120V	-	-	NSF		
L EQUI	PMENTS WILL BE NSF APPROVED CLEAN,OPERA	ABLE AND S	UBJECT TO	THE FINAL APPROVAL BY	Y THE HEALTH			

**FOUIPMENT SCHEDULE** 

Doors leading to the outside and restroom doors are required to be self-closing and tight-fitting. Please confirm that the doors leading to the outside are equipped with a self-closer and weather strips to eliminate any air gaps.

DEPARTMENT

	HARDWARE SCHEDULE									
TAG	DESCRIPTION									
1	3 HINGES, W/LEVERED PRIVACY LOCKSET , KICKPLATE AND DOOR CLOSER									
2	PADDLE LATCH EXIT DEVICE AND DOOR CLOSER, PANIC HARDWARE									
3	DOUBLE ACTION									

## DOOR SCHEDULE

			Doon	OOTILDOLL				
TAG	DESCRIPTION	FRAME CONSTRUCTION	NOMINAL SIZE	DOOR FINISH	FRAME FINISH	LABEL	HARDWARE SET	COMMENTS
Α	STORE FRONT GLASS DOOR	ALUMINUM	W X H 3'-0" x 7'-0"	TEMPERED GLASS	ALUMINUM	_	2	EXIST'G FRONT EXIT DOOR
В	WOOD DOOR	HOLLOW METAL	3'-0" x 7'-0"	PAINT	PAINT	-	2	EXIST'G EXIT DOOR
С	WOOD DOOR	HOLLOW METAL	3'-0" x 7'-0"	PAINT	PAINT		1	EXIST'G
D	WOOD DOOR	WOOD DOOR	3'-0" x 7'-0"	PAINT	PAINT	-		EXIST'G
E	HOLLOW METAL DOOR	HOLLOW METAL	3'-0" x 7'-0"	PAINT	PAINT	-	2	EXIST'G BACK EXIT DOOR
F	WOOD DOOR	HOLLOW METAL	3'-0" x 7'-0"	PAINT	PAINT	-	3	EXIST'G
	* ALL EVIT DOODS MUST	ODEN WITHOUT THE LIST	E OE A KEV OD G	SDECIAL KNOWLED	CE EDOM TH	IE CIDE	WILLOH ECDESS	IC MADE

\* ALL EXIT DOORS MUST OPEN WITHOUT THE USE OF A KEY OR SPECIAL KNOWLEDGE FROM THE SIDE WHICH EGRESS IS MADE \* LEVERED HANDLE HARDWARE AS REQUIRED BY ILLINOIS ACCESSIBILITY CODE

\* PROVIDE DOOR CLOSERS ALONG ALL ACCESSIBLE ROUTES

		ROC	M FINISH SCHEDU	JLE	
NO	ROOM	WALLS	BASE	FLOOR	CEILING
100	EXIST'G ENTRY	GYP. BD. PAINTED	QT COVE BASE	FLOOR TILE	EXIST'G LAY-IN CLG.
101	EXIST'G CLOSET	GYP. BD. PAINTED	QT COVE BASE	FLOOR TILE	EXIST'G LAY-IN CLG.
102	BAR AREA	STAINLESS STEEL	QT COVE BASE	QUARRY TILE	VINYL TILE CLG.
103	DINING AREA	GYP. BD. PAINTED	QT COVE BASE	FLOOR TILE	EXIST'G LAY-IN CLG.
104	WAITER STATION	STAINLESS STEEL	QT COVE BASE	QUARRY TILE	EXIST'G LAY-IN CLG.
105	KITCHEN	STAINLESS STEEL	QT COVE BASE	QUARRY TILE	VINYL TILE CLG.
106	EXIST'G WOMEN'S	CERAMIC TILE	CERAMIC TILE	FLOOR TILE	EXIST'G LAY-IN CLG.
107	EXIST'G MEN'S	CERAMIC TILE	CERAMIC TILE	FLOOR TILE	EXIST'G LAY-IN CLG.
108	HALLWAY	GYP. BD. PAINTED	QT COVE BASE	FLOOR TILE	EXIST'G LAY-IN CLG.
109	EXIST'G DRY STORAGE	GYP. BD. PAINTED	QT COVE BASE	QUARRY TILE	EXIST'G LAY-IN CLG.
110	EXIST'G TOILET	CERAMIC TILE	CERAMIC TILE	FLOOR TILE	EXIST'G LAY-IN CLG.

1. Doors No. A, and E

1010.1.10 Panic and fire exit hardware. Swinging doors serving rooms or spaces with an occupant load of 50 or more in a Group A occupancy shall not be provided with a latch or lock other than panic hardware or fire exit hardware.

- Dial stem thermometers (ranging from 0° to 220°F) are required in all preparation areas.
- Chemical test kits (specific to the sanitizer) are required for the appropriate sanitizer.
- pH meter and log for acidifying rice.
- All cooling/freezing units must have accurate thermometers.
- Covered waste cans are required in all restrooms.
- Toilets, urinals, hand sinks, 3 compartment sinks, mop sink, prep sinks, and permanent counters/cabinets must be sealed to floors and walls with a silicone caulk seal.
- Anti-siphon devices are required on all toilet tanks, urinals, and faucets with hose
- Soap and paper towels are required at all hand sinks.
- Provide hair restraints and disposable gloves for all food handlers.
- If sinks are provided with spring-loaded faucets, the faucets must remain running for a minimum of 15 seconds

COOKLINE EQUIPMENT AND REACH-IN REFRIGERATION AND FREEZER UNITS TO BE INSTALLED ON CASTERS. PROVIDE THE FOLLOWING: NSF STAINLESS STEEL OPEN WIRE SHELVING UNITS AND NSF HEAVY DUTY DUNNAGE RACKS IN LIQUOR STORAGE ROOM. NSF STAINLESS STEEL SHELF OVER 3-COMPTMENT SINK. ICE MAKER A MIN. 8" FROM ALL WALLS. HEAVY-DUTY MOP RACKS LOCATED OVER MOP SINK. HEAVY-DUTY BROOM RACKS IN JANITORIAL AREA. METAL GARBAGE CANS WITH LIDS FOR RESTROOMS. SANITARY BOX IN WOMEN'S RESTROOMS. METAL GARBAGE CANS WITH LIDS FOR DIAPER CHANGING STATION.

ALL NSF APPROVED HAND SINKS TO BE WITH BLADE HANDLED FAUCETS. WAITRESS, BEVERAGE STATION & BAR COUNTER TOP -STAINLESS STEEL ALL CABINET SHELVES -STAINLESS STEEL ALL CABINET BASE - 6" STAINLESS STEEL LEGS (NO KICK BASE) LAVATORY COUNTERTOP TO BE SOLID SURFACE (NO PLASTIC LAMINATE OR CABINETRY) ANY PAINTED FINISHES TO BE SEMI-GLOSS OR GLOSS (NO FLAT, NO EGG SHELL, NO TEXTURE). PROVIDE FRP ON WALL AND UNDERSIDE OF BAR. STAINLESS STEEL WALL FINISH FOR BEHIND AND ADJACENT TO COOK LINE

FIRE EXTINGUISHERS TO BE TYPE K IN KITCHEN AND TYPE A IN DINING ROOM

#### KITCHEN EQUIPMENT NOTES

CONTRACTOR SHALL INSTALL AND CONNECT ALL EQUIPMENT AS PER EQUIPMENT SUPPLIER'S SPECIFICATIONS. ALL LOCATIONS TO BE VERIFIED WITH OWNER PRIOR TO INSTALLATION.

PLUMBING CONTRACTOR SHALL PROVIDE ALL ROUGH-INS. INSULATE ALL COLD/HOT WATER PIPES AS REQUIRED. MAINTAIN MIN 36" IN FRONT OF ALL COOKING EQUIPMENT.

ELECTRICAL CONTRACTOR SHALL PROVIDE ALL ELECTRICAL OUTLETS FOR EQUIPMENT. VERIFY ALL ELECTRICAL REQUIREMENTS WITH EQUIPMENT SUPPLIER. VERIFY ALL GAS AND WATER REQUIREMENTS WITH EQUIPMENT SUPPLIER.

ALL PERMANENT EQUIPMENT MUST BE LOCATED SO THAT AREAS BEHIND, UNDERNEATH, AND ON THE SIDES OF THE EQUIPMENT CAN BE EASILY CLEANED.

TWO DRAIN BOARDS ARE REQUIRED AT ALL THREE-COMPARTMENT SINKS ALONG WITH AN APPROPRIATELY SIZED FAUCET, LOCKABLE DRAIN PLUGS, AND AN INDIRECT CONNECTION TO THE SEWER.

#### DRY STORAGE

DRY STORAGE: 25% OF 1000 SF (KITCHEN AREA.) = 250SF REQ'D ACTUAL DRY STORAGE 10X4X4X2 = 320SF PROVIDED. LIQUOR STORAGE: 35% OF BAR AREA = 35%X200=70SF REQ'D ACTURAL STORAGE: 5X4X2.5 = 50 + 20X1.5 = 80SF PROVIDED.

ALL FOOD AND FOOD RELATED ITEMS MUST BE STORED OFF THE FLOOR ON DURABLE WASHABLE SHELVES. THE STORAGE AREA MUST BE APPROPRIATELY SIZED BASED ON THE NUMBER OF MEALS SERVED DAILY AND THE NUMBER OF DELIVERIES WEEKLY.


ALL FOOD EQUIPMENT TO BE ON CASTERS, 6" LEGS, OR SEALED TO THE FLOOR FOR EASY CLEANING.

NO RAW WOOD SURFACES PERMITTED ANYWHERE. UNDERSIDES OF COUNTERTOPS, INSIDE OF CABINETRY, AND WATER HEATER PLATFORMS

#### **GENERAL USE DIRECTIONS**

recommendations below.

- 1. Remove closure from container and discard. 2. Attach product pick-up tube from dispenser to
- 3. Tighten closure attached to the product pick-up
- tube on to the continer. 4. Product is designed for use with the Pathways dispenser. Use concentration will vary depending on soil conditions. Dispenser should be programmed to deliver product according to the dosage
- 5. For best results, grease trap should be pumped out before starting treatment.

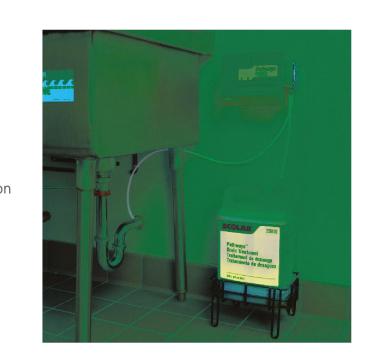

9256-1456

	GREASE TRAP	INITIAL PRODUCT	ANTICIPATED GRE	EASE/SOIL LOAD DA	ILY INJE	CTION RATE
	CAPACITY	DOSAGE	Light	Med	ium	Heavy
	0-99 gals	1/4 gal	1-2 oz	2-3	OZ	3-4 oz
ECOLAB 29810	100-499 gals	1/2 gal	3-4 oz	4-5	OZ	5-6 oz
Pathways™	500-999 gals	1 gal	4-6 oz	6-8	OZ	8-10 oz
Drain Treatment  itement de drainage  oto de desagües	1000- 5000 gals	2 gals	8-10 oz	10-12	2 oz	12-14 oz
Pathways Park Promps Park Promps						
2.2	PRODUCT		PICK CODE	SUPC CODE	P	ACK SIZE
ECOLAB	Pathways™ D	rain Treatment	6129810	3378296		1-2.5 gal
	Dispenser		9256-2009			

Install Kit

1 Ecolab Place St. Paul, MN 55102 www.ecolab.com 1800 35 CLEAN ©2017 Ecolab USA Inc. All rights reserved. 29608/0403/0717

06-08-2022

**EC** LAB

WEI TAN 2425 S WENTWORTH AVE CHICAGO IL 60616

Phone: (312) 912-5798 Email: twarchitect98@yahoo.com

LICENSE NO: 001-022013 EXPIRES: 11/30/2022


MEP ENGINEER 236 W ALEXANDER STREET CHICAGO IL 60616


PHONE: (312)720-8800 BILLY WANG68@HOTMAIL.COM LICENSE NO: 062.068227 EXPIRES: 11 / 30 /2023


ISSUES	DATE
ISSUED FOR PERMIT	04/08/2022
REISSUED FOR PERMIT	06/08/2022



FLOOR PLAN,

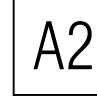


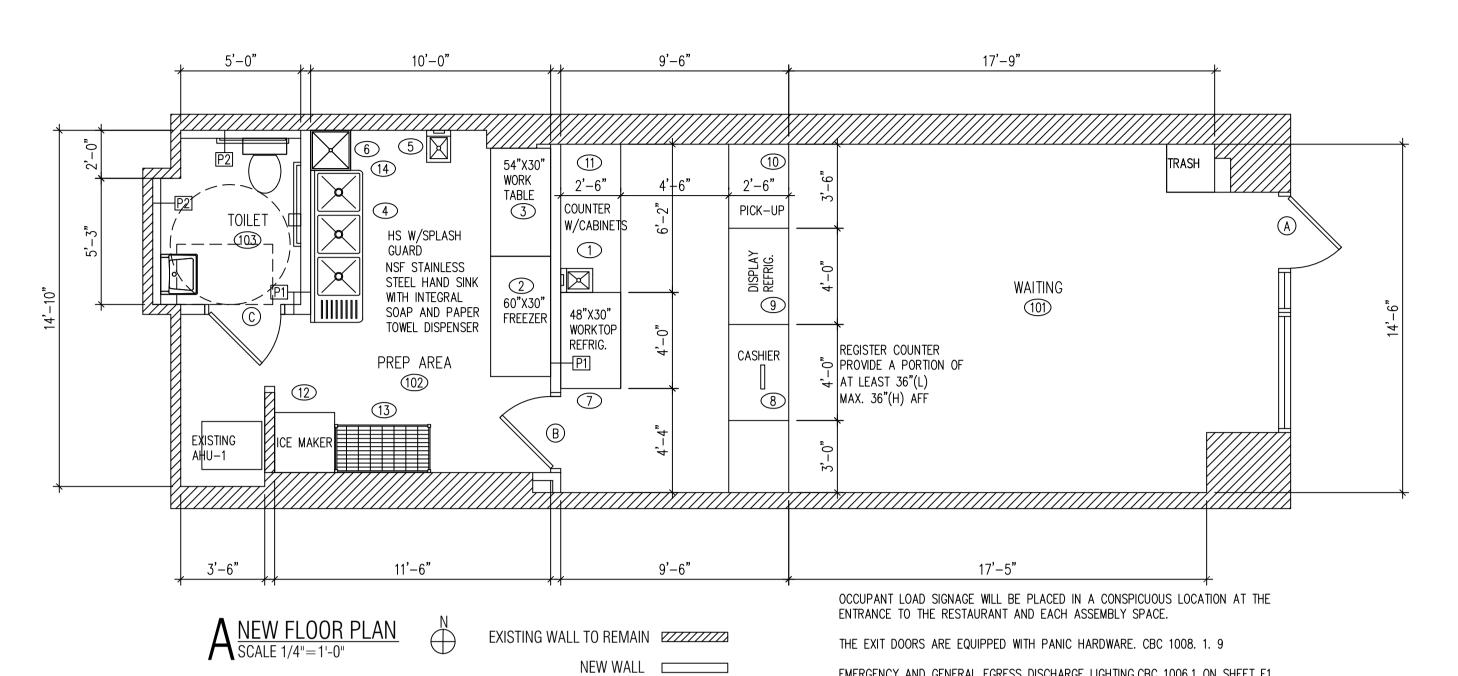

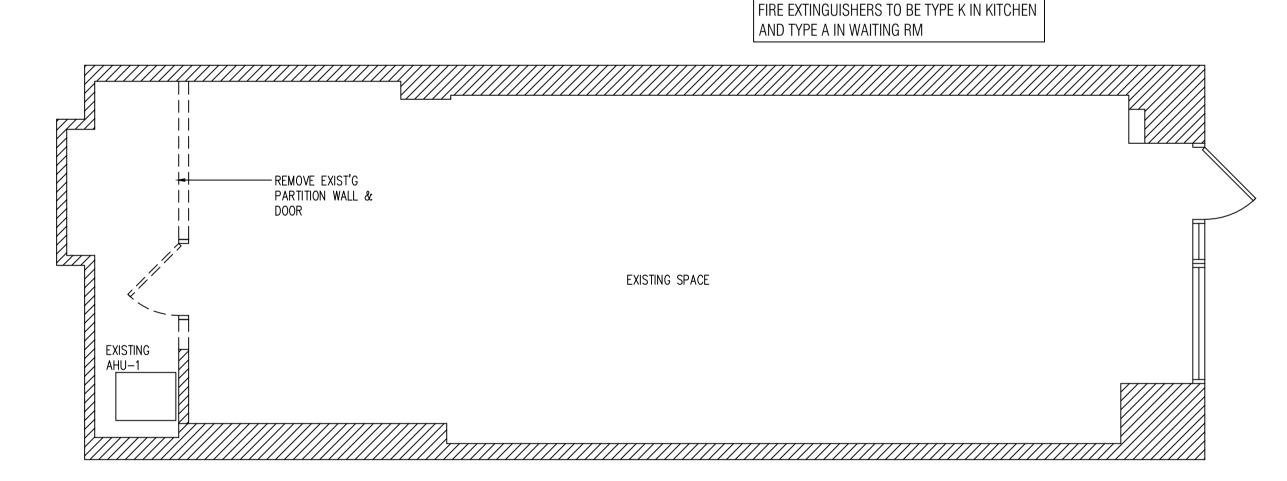

EMERGENCY AND GENERAL EGRESS DISCHARGE LIGHTING.CBC 1006.1 ON SHEET E1



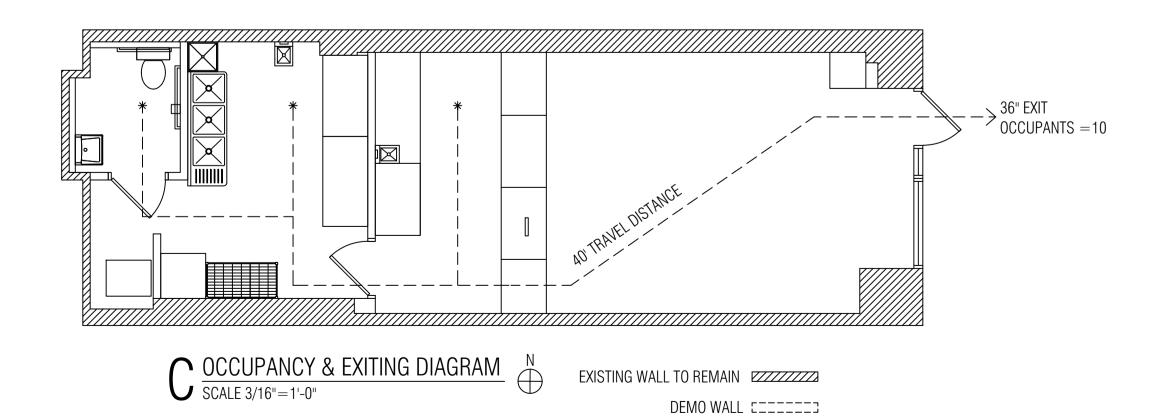

					EQUIPMENT SO	CHEDULE	
NO	QTY	DESCRIPTION	GAS	ELEC	TRIC	PLUMBING	REMARKS
1	1	PREP SINK	_	-	-	1/2"CW,1/2" HW, 4" INDIRECT DRAIN	NSF
2	1	60X30 FREEZER	<u>-</u>	120V	4A	-	NSF
3	ĭ	WORK TABLE	_	_	-	_	NSF,W/ 6" STAINLESS STEEL LEGS NSF APPROVED
4	1	3 COMPARTMENT SINK	_	_	-	1/2" CW,1/2" HW,4" INDIRECT DRAIN	NSF,W/ ECOLAB PATHWAY TO PREVENT BACKFLOW
5	1	HAND SINK	_	_	-	1/2" CW,1/2" HW, 2" DRAIN	NSF, WALL MOUNTED - SEALED
6	1	MOP SINK	-	_		1/2"CW,1/2" HW, 4" DRAIN	NSF, W/ MOP HOOKS, SEAL EDGES
7	1	48" UNDER COUNTER REFRIG	_	120V	3A	-	NSF
8	1	CASHIER COUNTER	-	_	_	_	NSF
9	1	30"X48" REFRIG. DISPLAY CASE	-	120V	4A	-	NSF
10	1	PICK UP COUNTER	=	_	_	_	NSF
11	1	COUNTER W/CABINETS	-	ı <del>-</del>	.=	-	NSF
12	1	ICE MAKER	-	240V	10A	1/2"CW,4" INDIRECT DRAIN	NSF
13	1	SHELVING	-	i <del>-</del>	.=	-	NSF APPROVED STAINLESS STEEL SHELVING
14	1	ELECTRIC TANKLESS HOT WATER HEATER		240V	-	3/4" CW & 3/4" HW	NSF

	ROOM FINISH SCHEDULE										
NO	NO ROOM WALLS BASE FLOOR CEILING										
101	WAITING AREA	GYP. BD. PAINTED	QT COVE BASE	FLOOR TILE	OPEN CEILING						
102	PREP AREA	FRP	QT COVE BASE	QUARRY TILE	2'X4' VINYL TILE CLG.						
103	TOILET	CERAMIC TILE	QT COVE BASE	FLOOR TILE	EXIST'G CEILING						

	DOOR SCHEDULE										
TAG	DESCRIPTION	FRAME CONSTRUCTION	NOMINA	L SIZ	ĽΕ	DOOR FINISH	FRAME FINISH	LABEL	HARDWARE SET	COMMENTS	
			WXH								
Α	STORE FRONT GLASS DOOR	ALUMINUM	3'-0"	X	7'-0"	TEMPERED GLASS	ALUMINUM	-	2	EXIST'G FRONT EXIT DOOR	
В	WOOD DOOR	WOOD	3'-0"	X	6'-8"	PAINT	PAINT	-	1	NEW	
С	WOOD DOOR	WOOD	3'-0"	X	6'-8"	PAINT	PAINT	-	1	NEW	
	* ALL EXIT DOORS MUST	OPEN WITHOUT THE USE	OF A	KEY	OR S	PECIAL KNOWLED	GE FROM TH	HE SIDE	WHICH EGRESS	IS MADE	
	* LEVERED HANDLE HARD	WARE AS REQUIRED BY	ILLING	IS A	ACCES	SSIBILITY CODE					
	* PROVIDE DOOR CLOSE	RS ALONG ALL ACCESSI	BLE RC	UTE	ES						

	HARDWARE SCHEDULE											
TAG	DESCRIPTION											
1	3 HINGES, W/LEVERED PRIVACY LOCKSET, KICKPLATE AND DOOR CLOSER											
2	PADDLE LATCH EXIT DEVICE AND DOOR CLOSER, PANIC HARDWARE											
3	PRIVACY LOCKET											

REACH-IN REFRIGERATION AND FREEZER UNITS TO BE INSTALLED ON CASTERS. NSF STAINLESS STEEL SHELF OVER 3-COMPTMENT SINK. HEAVY-DUTY MOP RACKS LOCATED OVER MOP SINK. HEAVY-DUTY BROOM RACKS IN JANITORIAL AREA. METAL GARBAGE CANS WITH LIDS FOR RESTROOMS.

ALL NSF APPROVED HAND SINKS TO BE WITH BLADE HANDLED FAUCETS. WAITRESS, BEVERAGE STATION & BAR COUNTER TOP -STAINLESS STEEL ALL CABINET SHELVES -STAINLESS STEEL. ALL CABINET BASE - 6" STAINLESS STEEL LEGS (NO KICK BASE) LAVATORY COUNTERTOP TO BE SOLID SURFACE (NO PLASTIC LAMINATE OR CABINETRY) ANY PAINTED FINISHES TO BE SEMI-GLOSS OR GLOSS (NO FLAT, NO EGG SHELL, NO TEXTURE). PROVIDE FRP ON WALL AND UNDERSIDE OF SERVICE AREA.

## KITCHEN EQUIPMENT NOTES

CONTRACTOR SHALL INSTALL AND CONNECT ALL EQUIPMENT AS PER EQUIPMENT SUPPLIER'S SPECIFICATIONS. ALL LOCATIONS TO BE VERIFIED WITH OWNER PRIOR TO INSTALLATION.

DEPARTMENT

PLUMBING CONTRACTOR SHALL PROVIDE ALL ROUGH-INS. INSULATE ALL COLD/HOT WATER PIPES AS REQUIRED. MAINTAIN MIN 36" IN FRONT OF ALL COOKING EQUIPMENT.

ELECTRICAL CONTRACTOR SHALL PROVIDE ALL ELECTRICAL OUTLETS FOR EQUIPMENT. VERIFY ALL ELECTRICAL REQUIREMENTS WITH EQUIPMENT SUPPLIER. VERIFY ALL GAS AND WATER REQUIREMENTS WITH EQUIPMENT SUPPLIER.

ALL PERMANENT EQUIPMENT MUST BE LOCATED SO THAT AREAS BEHIND, UNDERNEATH, AND ON THE SIDES OF THE EQUIPMENT CAN BE EASILY CLEANED.

TWO DRAIN BOARDS ARE REQUIRED AT ALL THREE-COMPARTMENT SINKS ALONG WITH AN APPROPRIATELY SIZED FAUCET, LOCKABLE DRAIN PLUGS, AND AN INDIRECT CONNECTION TO THE SEWER.

#### DRY STORAGE

DRY STORAGE: 25% OF 120SF (KITCHEN AREA.) = 30SF REQ'D ACTUAL DRY STORAGE 32SF PROVIDED.

1 SHELVINGS X 4X4X2 = 32 SF

ALL FOOD AND FOOD RELATED ITEMS MUST BE STORED OFF THE FLOOR ON DURABLE WASHABLE SHELVES. THE STORAGE AREA MUST BE APPROPRIATELY SIZED BASED ON THE NUMBER OF MEALS SERVED DAILY AND THE NUMBER OF DELIVERIES WEEKLY.

ALL FOOD EQUIPMENT TO BE ON CASTERS, 6" LEGS, OR SEALED TO THE FLOOR FOR EASY CLEANING.


NO RAW WOOD SURFACES PERMITTED ANYWHERE. UNDERSIDES OF COUNTERTOPS, INSIDE OF CABINETRY, AND WATER HEATER PLATFORMS MUST BE SEALED.

#### **COMMISSION ON CHICAGO LANDMARKS**

Permit Reviewer: EB **APPROVED WITH** CONDITIONS Note: Any changes made to these plans after the approved date (see cover sheet) must be resubmitted to the Commission for review

**DATE & CONDITIONS:** 

11/9/22 No exterior work or storefront replacement.

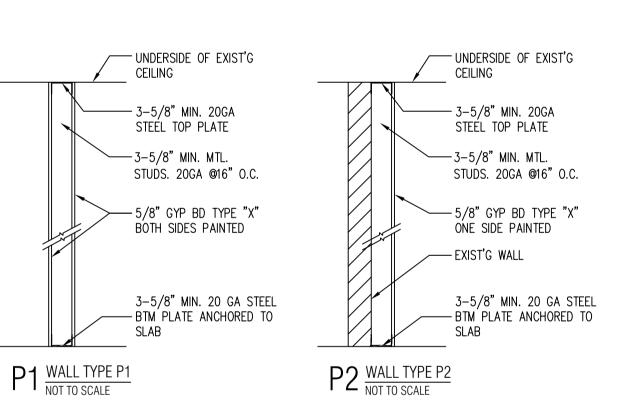

• Dial stem thermometers (ranging from 0° to 220°F) are required in all preparation areas.

• Chemical test kits (specific to the sanitizer) are required for the appropriate sanitizer.

pH meter and log for acidifying rice.

strips to eliminate any air gaps.

All cooling/freezing units must have accurate thermometers.

· Covered waste cans are required in all restrooms.

Toilets, urinals, hand sinks, 3 compartment sinks, mop sink, prep sinks, and permanent

counters/cabinets must be sealed to floors and walls with a silicone caulk seal. · Anti-siphon devices are required on all toilet tanks, urinals, and faucets with hose

Soap and paper towels are required at all hand sinks.

Provide hair restraints and disposable gloves for all food handlers.

If sinks are provided with spring-loaded faucets, the faucets must remain running for a minimum

Doors leading to the outside and restroom doors are required to be self-closing and tight-fitting. Please confirm that the doors leading to the outside are equipped with a self-closer and weather DEPARTMENT OF BUILDINGS STANDARD PLAN REVIEW CONDITIONAL PERMIT Construction subject to full impliance with the Municipal Code of Chicago and field inspection **SELF** CERTIFICATION

> 2425 S WENTWORTH AVE CHICAGO IL 60616

Phone: (312) 912-5798

Email: twarchitect98@yahoo.com

LICENSE NO: 001-022013 EXPIRES: 11/30/2024


 $\bigcap$ 


 $\geq$ 


SSUED FOR PERMIT



FLOOR PLANS & NOTES

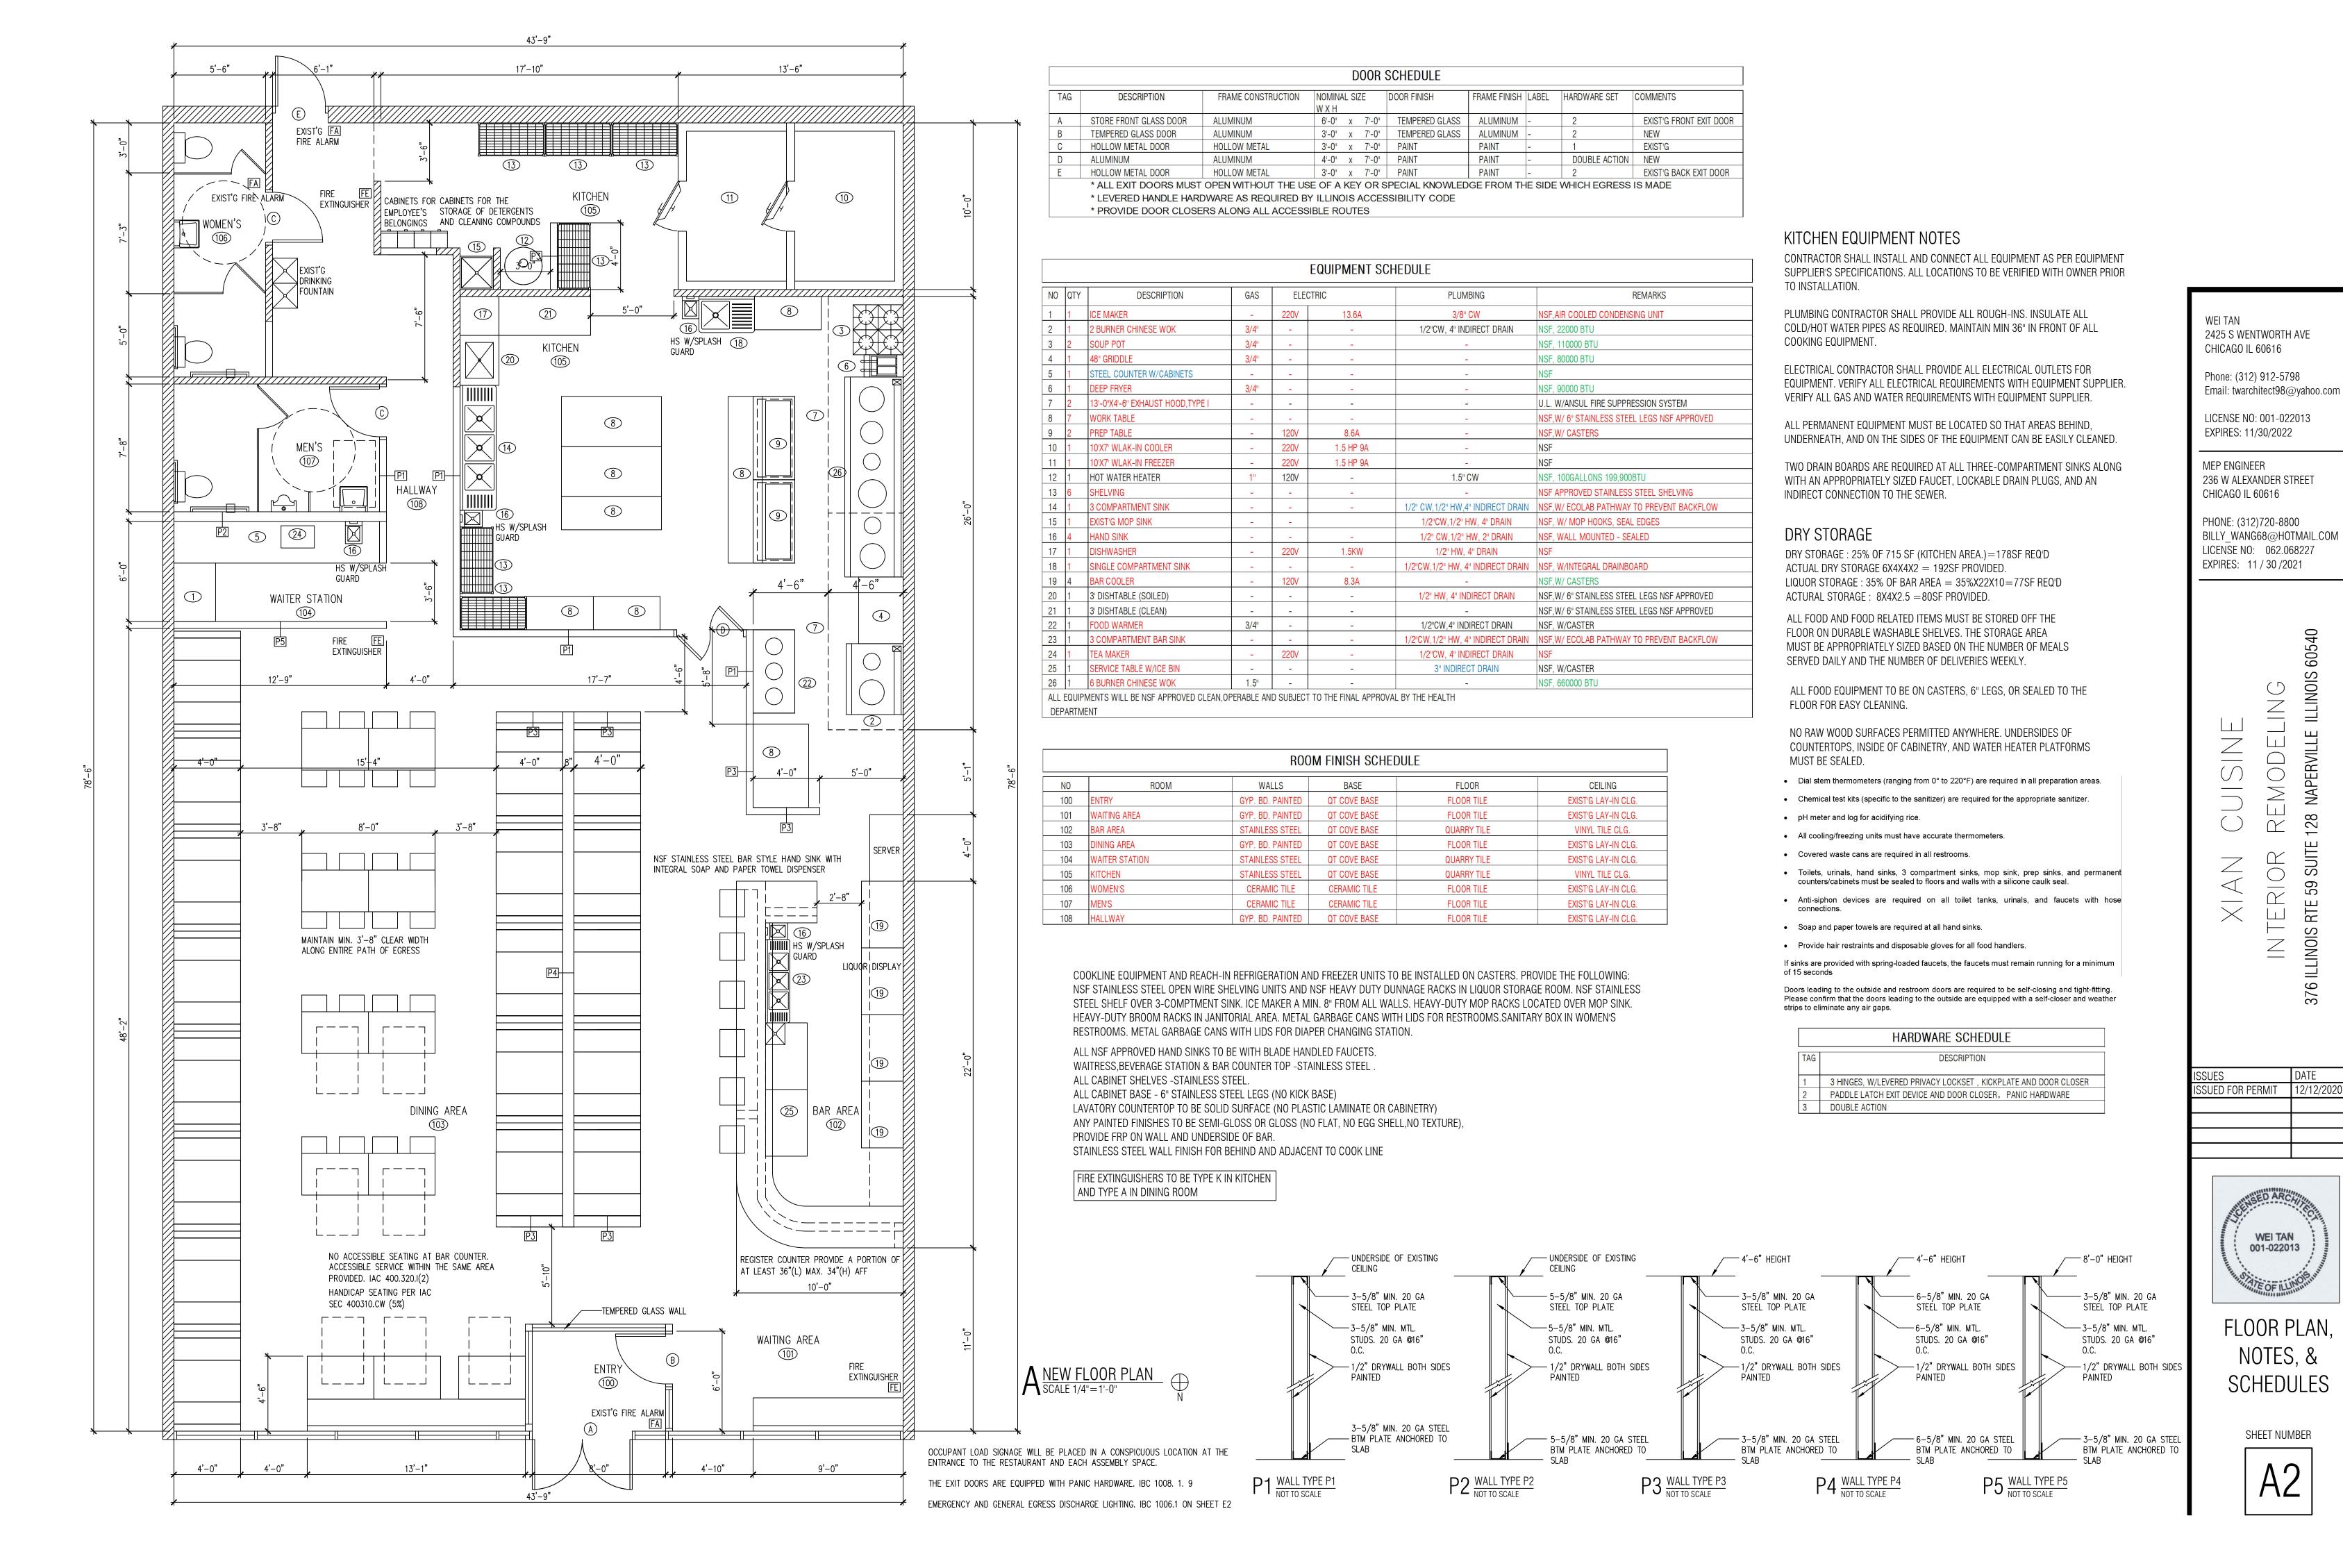

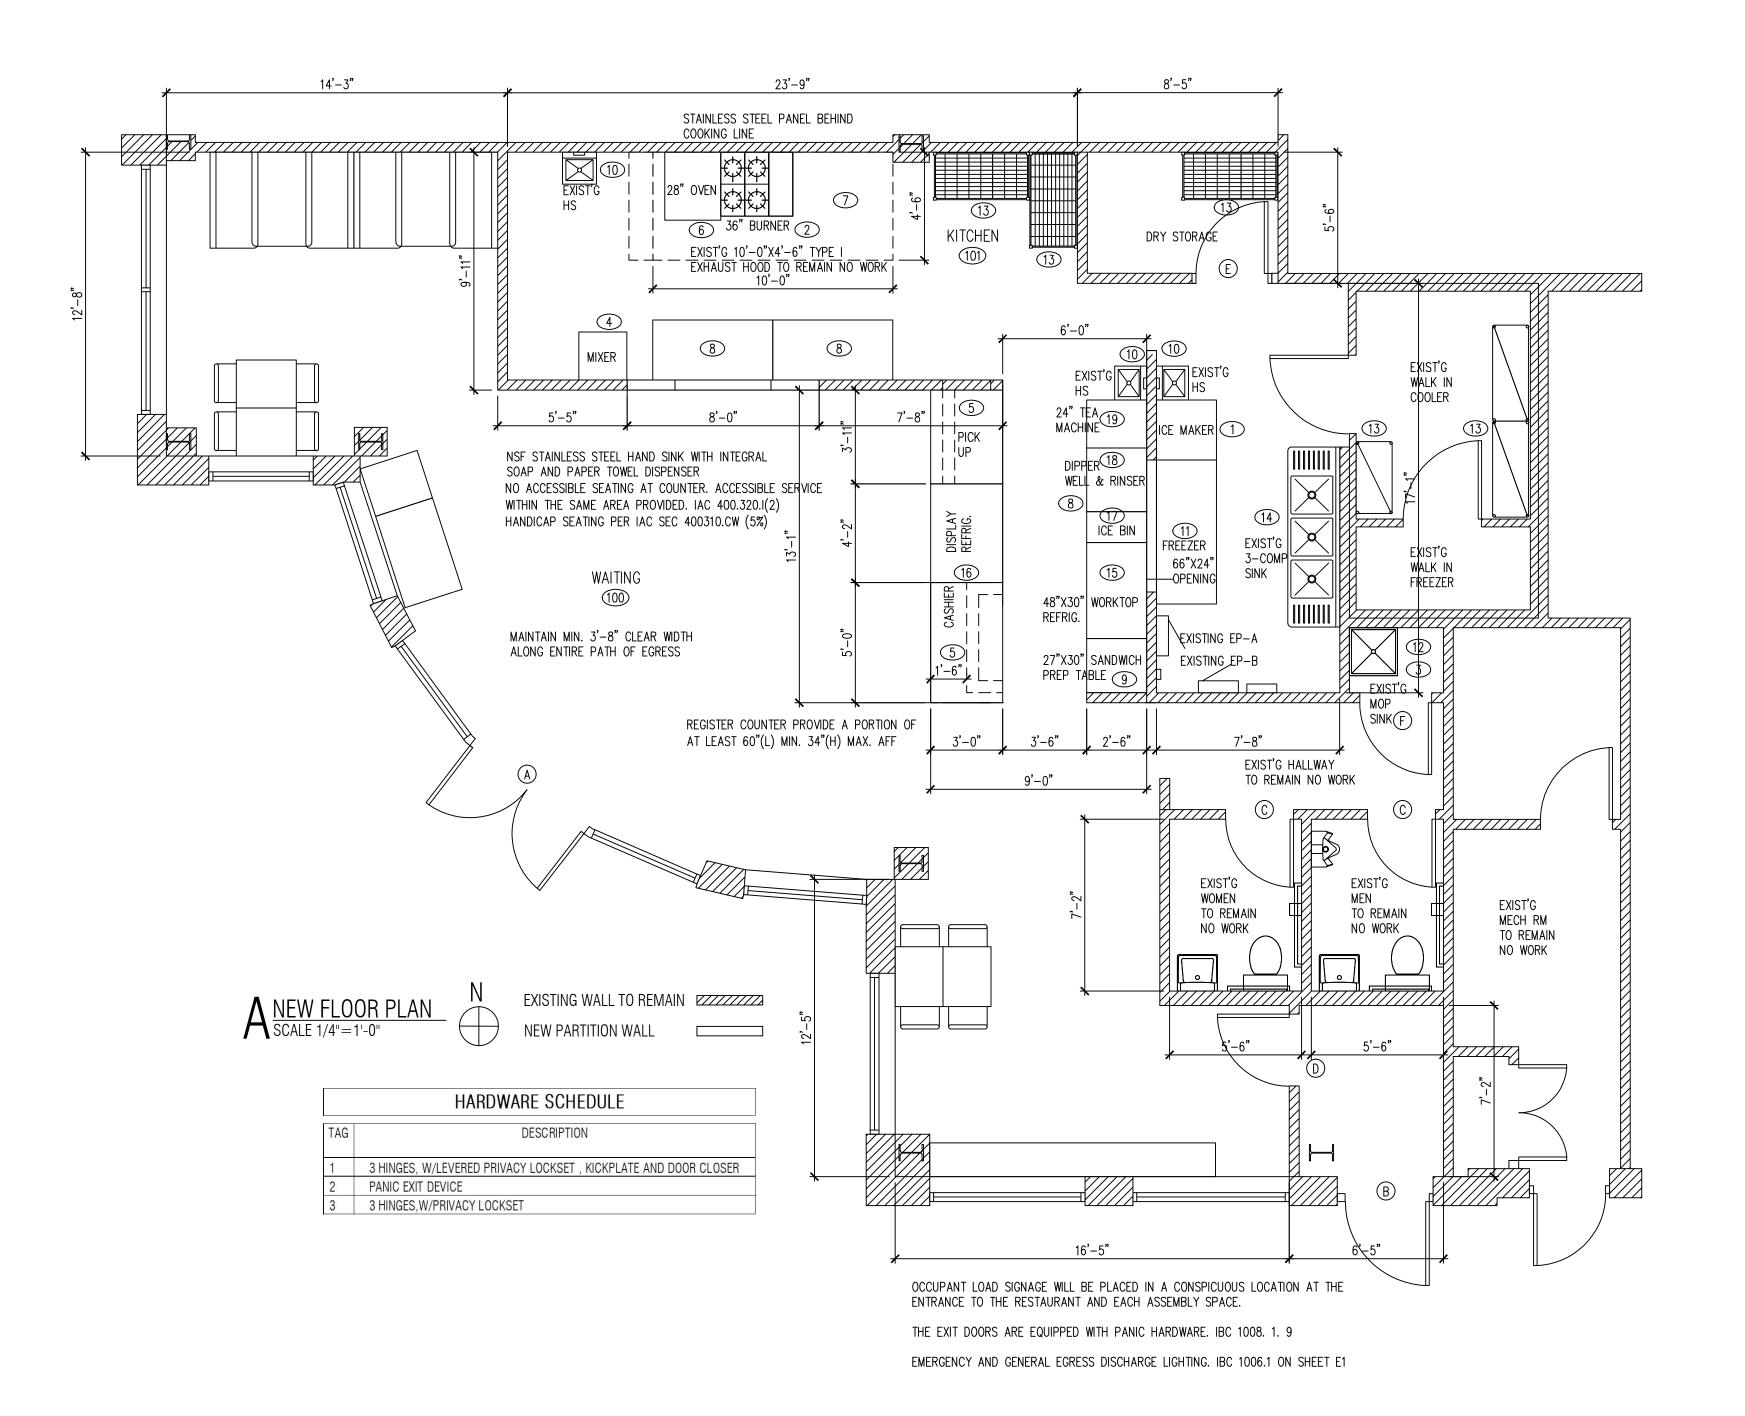

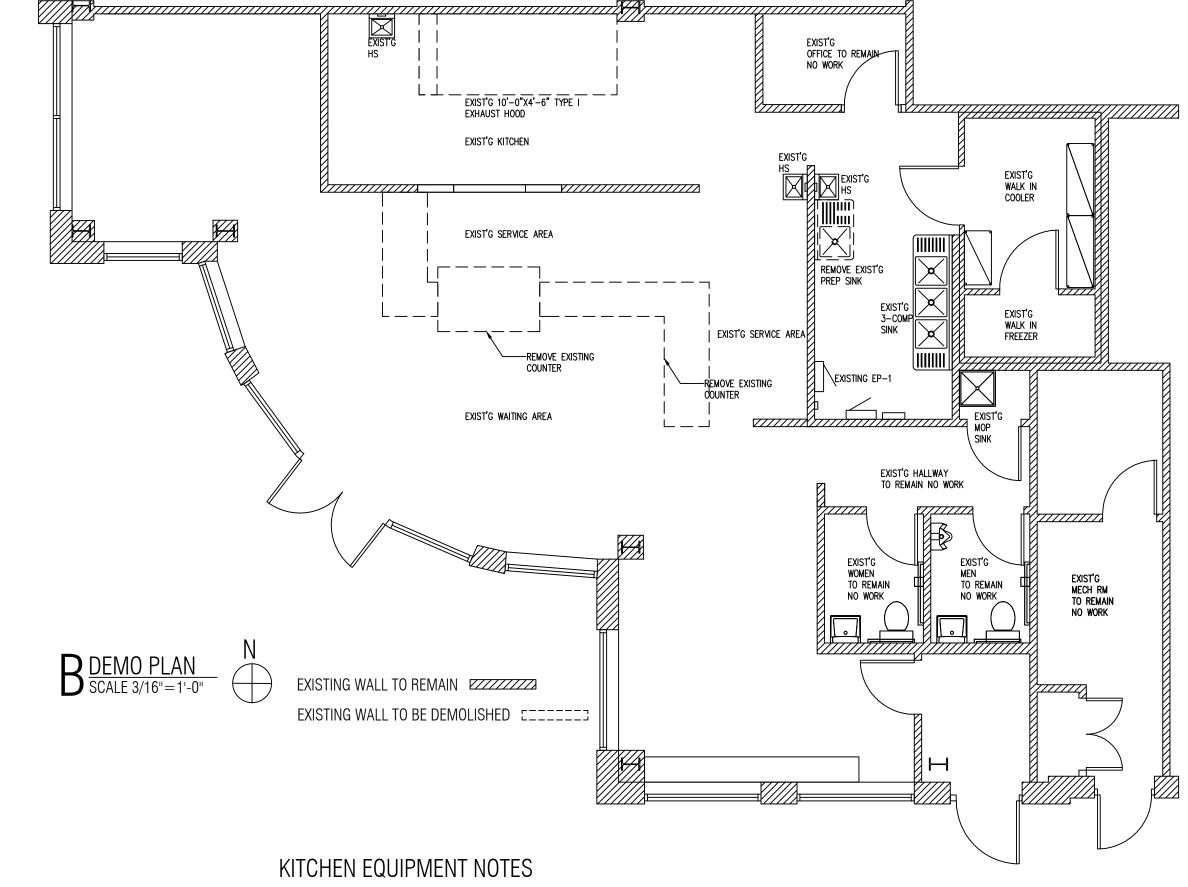

CONTRACTOR SHALL INSTALL AND CONNECT ALL EQUIPMENT AS PER EQUIPMENT SUPPLIER'S SPECIFICATIONS. ALL LOCATIONS TO BE VERIFIED WITH OWNER PRIOR TO INSTALLATION.

PLUMBING CONTRACTOR SHALL PROVIDE ALL ROUGH-INS. INSULATE ALL COLD/HOT WATER PIPES AS REQUIRED. MAINTAIN MIN 36" IN FRONT OF ALL COOKING EQUIPMENT.

ELECTRICAL CONTRACTOR SHALL PROVIDE ALL ELECTRICAL OUTLETS FOR EQUIPMENT. VERIFY ALL ELECTRICAL REQUIREMENTS WITH EQUIPMENT SUPPLIER. VERIFY ALL GAS AND WATER REQUIREMENTS WITH EQUIPMENT SUPPLIER.

ALL PERMANENT EQUIPMENT MUST BE LOCATED SO THAT AREAS BEHIND, UNDERNEATH, AND ON THE SIDES OF THE EQUIPMENT CAN BE EASILY CLEANED.

TWO DRAIN BOARDS ARE REQUIRED AT ALL THREE-COMPARTMENT SINKS ALONG WITH AN APPROPRIATELY SIZED FAUCET, LOCKABLE DRAIN PLUGS, AND AN INDIRECT CONNECTION TO THE SEWER.

- Dial stem thermometers (ranging from 0° to 220°F) are required in all preparation areas.
- Chemical test kits (specific to the sanitizer) are required for the appropriate sanitizer.
- pH meter and log for acidifying rice.
- All cooling/freezing units must have accurate thermometers.
- Covered waste cans are required in all restrooms.
- Toilets, urinals, hand sinks, 3 compartment sinks, mop sink, prep sinks, and permanent counters/cabinets must be sealed to floors and walls with a silicone caulk seal.
- Anti-siphon devices are required on all toilet tanks, urinals, and faucets with hose connections.
- Soap and paper towels are required at all hand sinks.
- Provide hair restraints and disposable gloves for all food handlers.
- If sinks are provided with spring-loaded faucets, the faucets must remain running for a minimum of 15 seconds
- Doors leading to the outside and restroom doors are required to be self-closing and tight-fitting. Please confirm that the doors leading to the outside are equipped with a self-closer and weather strips to eliminate any air gaps.

				Е	QUIPMENT SCH	EDULE	
NO	QTY	DESCRIPTION	GAS	ELECT	RIC	PLUMBING	REMARKS
1	1	ICE MAKER	-	120V	-	1/2" CW,4" INDIRECT DRAIN	NSF
2	1	4 BURNER	3/4"	_	=	-	NSF, 170000 BTU
3	1	EXIST'G MOP SINK	-	-		1/2"CW,1/2" HW, 4"DRAIN	NSF, W/ MOP HOOKS, SEAL EDGES
4	1	20 QUART MIXER	_	120V	14A	_	NSF
5	2	COUNTER	-1	-	-	-	NSF
6	2	OVEN	_	120V	_	-	NSF, 33000 BTU
7	1	EXIST'G 10'-0"X4'-6" EXHAUST HOOD,TYPE I	-1	-	=	-	U.L. W/ANSUL FIRE SUPPRESSION SYSTEM
8	3	WORK TABLE	H	-	н н	Ξ	NSF
9	1	27" REFRIGERATOR	-	120V	-	-	NSF
10	3	EXIST'G HAND SINK	_	_	_	1/2" CW,1/2" HW, 2" DRAIN	NSF, WALL MOUNTED - SEALED
11	1	72" FREEZER	-	120V	-	-	NSF
12	1	EXIST'G TANKLESS HWH	3/4"	120V	-	3/4" CW,3/4" HW	NSF, 199,000BTU
13	4	SHELVING	-	-	-	_	NSF APPROVED STAINLESS STEEL SHELVING
14	1	EXIST'G 3 COMPARTMENT SINK		-	-	1/2" CW,1/2" HW,4" INDIRECT DRAIN	NSF,W/ ECOLAB PATHWAY TO PREVENT BACKFLOW
15	1	48" WORKTOP REFRIG.	-1	120V	-	-	NSF
16	1	50" DISPLAY REFRIG.	H	120V	-	Ξ	NSF
17	1	ICE BIN	-	-	-	4" INDIRECT DRAIN	NSF
18	1	DIPPER WELL & RINSER	=	-	-	1/2" CW,1/2" HW,2" DRAIN	NSF
19	1	24" TEA MACHINE	-	120V	-	_	NSF
ALL	EQUIPI	MENTS WILL BE NSF APPROVED CLEAN,OPERAB	BLE AND SUB	JECT TO THE	FINAL APPROVAL BY TH	HE HEALTH	

DEPARTMENT

	ROOM FINISH SCHEDULE											
NO	NO ROOM WALLS BASE FLOOR CEILING											
100	WAITING AREA	EXIST'G	EXIST'G	EXIST'G FLOOR TILE	EXIST'G CEILING							
	CASHIER AREA	EXIST'G	EXIST'G	EXIST'G QUARRY TILE	EXIST'G CEILING							
101	KITCHEN	EXIST'G	EXIST'G	EXIST'G QUARRY TILE	EXIST'G VINYL TILES							
102	EXIST'G HALLWAY	EXIST'G	EXIST'G	EXIST'G FLOOR TILE	EXIST'G CEILING							
103	EXIST'G WOMEN	EXIST'G	EXIST'G	EXIST'G FLOOR TILE	EXIST'G CEILING							
104	EXIST'G MEN	EXIST'G	EXIST'G	EXIST'G FLOOR TILE	EXIST'G CEILING							

	DOOR SCHEDULE											
TAG DESCRIPTION FRAME CONSTRUCTION NOMINAL SIZE DOOR FINISH FRAME FINISH LABEL HARDWARE SET COMMENTS W X H												
Α	STORE FRONT GLASS DOOR	ALUMINUM	6'-0"	X	7'-0"	TEMPERED GLASS	ALUMINUM	_	2	EXIST'G FRONT EXIT DOOR		
В	TEMPERED GLASS DOOR	ALUMINUM	3'-0"	X	7'-0"	TEMPERED GLASS	ALUMINUM	_	2	EXIST'G EXIT DOOR		
С	HOLLOW METAL DOOR	HOLLOW METAL	3'-0"	X	6'-8"	PAINT	PAINT	-	1	EXIST'G		
D	HOLLOW METAL DOOR	HOLLOW METAL	3'-0"	X	6'-8"	PAINT	PAINT	-	2	EXIST'G		
E	HOLLOW METAL DOOR	HOLLOW METAL	3'-0"	X	7'-0"	PAINT	PAINT	-	3	EXIST'G		
F	WOOD DOOR	HOLLOW METAL	3'-0"	X	6'-8"	PAINT	PAINT	-	3	EXIST'G		
	* ALL EXIT DOORS MUST	OPEN WITHOUT THE US	SE OF A	KEY	OR S	SPECIAL KNOWLED	GE FROM TH	E SIDE	WHICH EGRES	S IS MADE		
	* LEVERED HANDLE HARD	OWARE AS REQUIRED B	Y ILLING	DIS A	ACCES	SSIBILITY CODE						

\* PROVIDE DOOR CLOSERS ALONG ALL ACCESSIBLE ROUTES

DRY STORAGE

DRY STORAGE: 25% OF 500 SF (KITCHEN AREA.) = 125SF REQ'D ACTUAL DRY STORAGE 4X4X4X2=128SF PROVIDED

ALL FOOD AND FOOD RELATED ITEMS MUST BE STORED OFF THE FLOOR ON DURABLE WASHABLE SHELVES. THE STORAGE AREA MUST BE APPROPRIATELY SIZED BASED ON THE NUMBER OF MEALS SERVED DAILY AND THE NUMBER OF DELIVERIES WEEKLY.

ALL FOOD EQUIPMENT TO BE ON CASTERS, 6" LEGS, OR SEALED TO THE FLOOR FOR EASY CLEANING.

NO RAW WOOD SURFACES PERMITTED ANYWHERE.
UNDERSIDES OF COUNTERTOPS, INSIDE OF
CABINETRY, AND WATER HEATER PLATFORMS MUST
BE SEALED.

WEI TAN LICENSED ARCHITECT 2425 S WENTWORTH AVE. CHICAGO, IL 60616

PHONE: (312) 912-5798 EMAIL: twarchitect98@yahoo.com

LICENSE NO: 001-022013 EXPIRES: 11/30/2022

OWNER Te'amo Boba Bar 601 N Martingale RD Suite 320 SCHAUMBURG IL 60173


TE'AMO BOBA BAF
NTERIOR REMODELING
601 N MARTINGALE RD SUITE 320
SCHAUMBURG IL 60173

ISSUES	DATE
ISSUED FOR PERMIT	05/08 /2021



FLOOR PLAN, NOTES, & SCHEDULES

Δ1

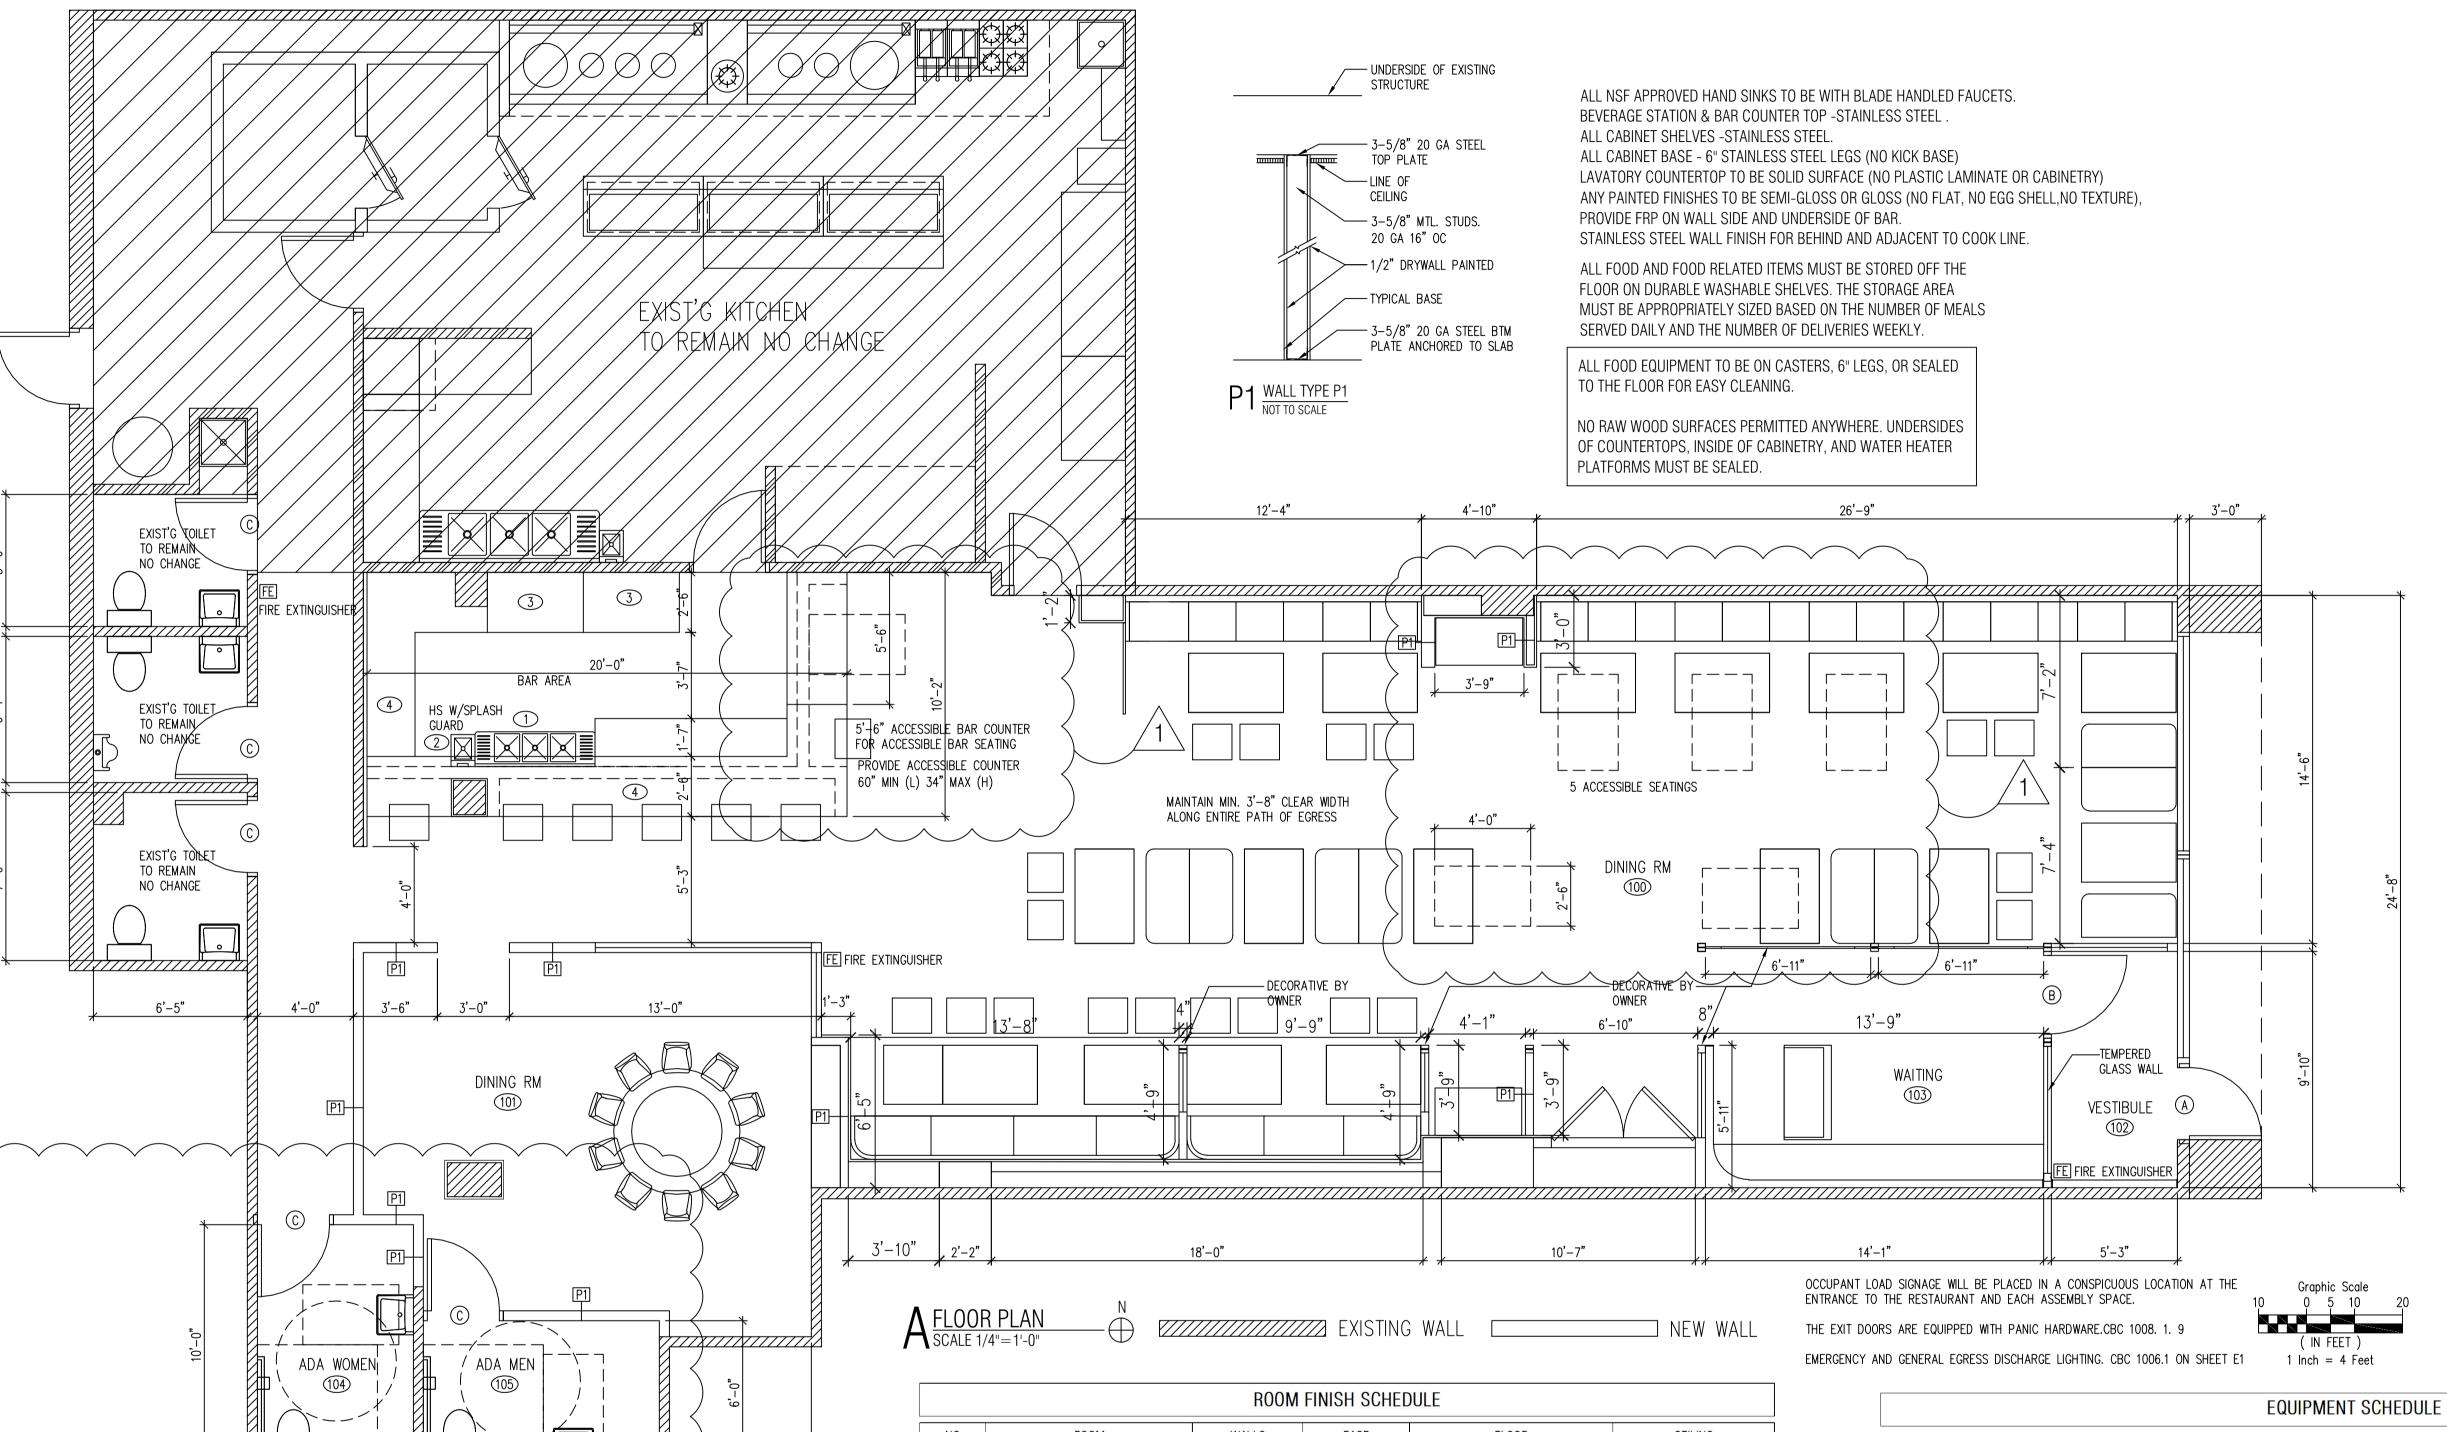

6'-6" AC - PROVIDE 5% OR AT LEAST 1 ACCESSIBLE SEATING TO INCLUDE RAISED AND/ OR LOWERED SEATING IF

NOTE: IF A BAR IS PROVIDED, A 5 FT. SECTION OF BAR MUST BE AT ACCESSIBLE HEIGHT OR PROVIDE 5% OR AT LEAST 1 ACCESSIBLE SEATING WITH WAITING SERVICES TO BE PROVIDED.

BEING PROVIDED; ALL RAISED AND LOWERED SEATING MUST CONSIST OF AN ACCESS ROUTE TO THE

ACCESSIBLE SEATING AS WELL AND MUST FULLY COMPLY TO ICC/ ANSI CHAPTER 18-11-1109.10

1. There must be a 36" aisle between any fixed seats Be sure to organize your booth seating or movable tables accordingly. 2. Spaces for wheelchairs at tables must be available by either leaving them open or adding movable chairs at ADA

3. 5% of the tables (or at least one if you have less than 20 tables) in your establishment must be ADA Compliant tables. 4. A floor area of 30" by 48" should be cleared to accommodate wheelchair seating at a table or counter. 5. Tabletops and counters should be between 28" to 34" in height to be accessible in a wheelchair.

6. Customers should have ample knee room under a table or counter that measures a minimum of 30" wide, 27" high, and 19" deep.

7. If the bar exceeds 34 inches in height, a 60-inch long protion of the counter must be lowered, where it is readily achievable, to between 28 and 34 inches from the floor to the top of the bar with knee space at least 27 inches high, 30 inches wide, and 19 inches deep, for customers who use wheelchairs.

	ROOM FINISH SCHEDULE								
NO	ROOM	WALLS	BASE	FLOOR	CEILING				
100	DINING ROOM	GYP. BD. PAINTED	QT COVE BASE	FLOOR TILE	EXIST'G 2'X2' LAY IN CEILING				
101	DINING ROOM	GYP. BD. PAINTED	QT COVE BASE	FLOOR TILE	EXIST'G 2'X2' LAY IN CEILING				
102	VESTIBULE	GYP. BD. PAINTED	QT COVE BASE	FLOOR TILE	EXIST'G 2'X2' LAY IN CEILING				
103	WAITING	GYP. BD. PAINTED	QT COVE BASE	FLOOR TILE	EXIST'G 2'X2' LAY IN CEILING				
104	ADA WOMEN	CERAMIC TILE	QT COVE BASE	FLOOR TILE	EXIST'G 2'X2' LAY IN CEILING				
105	ADA MEN	CEDAMIC TILE	OT COVE BACE	ELOOD TILE	EVICTIC DIVOLTAV IN CELLING				

EXIST'G 2'X2' LAY IN CEILING 105 ADA MEN CERAMIC TILE QT COVE BASE FLOOR TILE

	DOOR SCHEDULE								
TAG DESCRIPTION FRAME CONSTRUCTION NOMINAL SIZE DOOR FINISH FRAME FINISH LABEL HAI					HARDWARE SET	COMMENTS			
			WXH						
Α	STORE FRONT GLASS DOOR	ALUMINUM	3'-0" x 7'-0"	TEMPERED GLASS	ALUMINUM	-	2	NEW	
В	TEMPERED GLASS DOOR	ALUMINUM	3'-0" x 7'-0"	TEMPERED GLASS	ALUMINUM	-	2	NEW	
С	WOOD DOOR	HOLLOW METAL	3'-0" x 6'-8"	PAINT	PAINT	-	1	EXIST'G	
	* ALL EXIT DOORS MUST OPEN WITHOUT THE USE OF A KEY OR SPECIAL KNOWLEDGE FROM THE SIDE WHICH EGRESS IS MADE								
	* LEVERED HANDLE HARDWARE AS REQUIRED BY ILLINOIS ACCESSIBILITY CODE								
	* PROVIDE DOOR CLOSE	RS ALONG ALL ACCESSI	BLE ROUTES						

	HARDWARE SCHEDULE							
TAG	TAG DESCRIPTION							
1	1 1/2 PAIR BUTT HINGES, W/LEVERED PRIVACY LOCKSET , KICKPLATE AND SELF CLOSING DEVICE, ACCESSIBLE HARDWARE							
2	PANIC EXIT HARDWARE, SELF CLOSING DEVICE							
3	1 1/2 PAIR BUTT HINGES							
4	1 1/2 PAIR BUTT HINGES, W/PRIVACY LOCKSET							

**PLUMBING** 

1/2" CW.1/2" HW. 2" DRAIN

**REMARKS** 

1/2" CW.1/2" HW.2" INDIRECT DRAIN NSF.W/ ECOLAB PATHWAY TO PREVENT BACKFLOW

NSF,W/ CASTERS

NSF, WALL MOUNTED - SEALED

GAS

ALL EQUIPMENTS WILL BE NSF APPROVED CLEAN, OPERABLE AND SUBJECT TO THE FINAL APPROVAL BY THE HEALTH

DESCRIPTION

BAR 3-COMP SINK

3 2 BAR BEVERAGE COOLER

4 1 BAR COUNTER

**ELECTRIC** 

TW ARCHITECT INC LICENSED ARCHITECT 2425 S WENTWORTH AVE. UNIT 1D CHICAGO, IL 60616

PHONE: (312) 912-5798 EMAIL: twarchitect98@yahoo.com

LICENSE NO: 001-022013 EXPIRES: 11/30/2020

OWNER

LAO SZE CHUAN 614 S WABASH AVE CHICAGO IL 60605

 $\overline{\phantom{a}}$ 

ISSUES	DATE
ISSUED FOR PERMIT	05/18/2020
REISSUED FOR PERMIT	07/28/2020



FLOOR PLAN

EXISTING WALL

FIRE EXTINGUISHERS TO BE TYPE K IN KITCHEN AND TYPE A IN DINING ROOM

OCCUPANT LOAD SIGNAGE WILL BE PLACED IN A CONSPICUOUS LOCATION AT THE ENTRANCE TO THE RESTAURANT AND EACH ASSEMBLY SPACE. THE EXIT DOORS ARE EQUIPPED WITH PANIC HARDWARE. CBC 1008. 1. 9 EMERGENCY AND GENERAL EGRESS DISCHARGE LIGHTING. CBC 1006.1 ON SHEET E1

					EQUIPMENT SCI	HEDULE	
NO QTY DESCRIPTION GAS		ELEC	TRIC	PLUMBING	REMARKS		
1	1	ICE MAKER	_	220V	10A	1/2"CW, 4" INDIRECT DRAIN	NSF,AIR COOLED CONDENSING UNIT
2	1	STEAM WARMER	-	240V	12A	1/2"CW, 4" INDIRECT DRAIN	NSF
3	2	48" X 30" SANDWICH COOLER	-	120V	_	-	NSF
	2	60" X 30" PREP COOLER	-	120V	8A	-	NSF,W/ CASTERS
	1	1 DOOR GLASS REFRIG.	-	120V	3A	-	NSF
	1	2 DOOR GLASS REFRIG.	=	120V	4A	-	NSF
	15	WORK TABLE	-	1-	_	-	NSF,W/ 6" STAINLESS STEEL LEGS NSF APPROVED
	1	48" X 30" UNDERCOUNTER REFRIG.	-	120V	2.7A	-	NSF
	1	75 GALLON HWH	1"	120V	12	3/4" CW & 3/4" HW	NSF
0	11	SHELVING	_	-	_	-	NSF APPROVED STAINLESS STEEL SHELVING
1	1	3 COMPARTMENT SINK	-	-	_	1/2" CW,1/2" HW,4" INDIRECT DRAIN	NSF,W/ ECOLAB PATHWAY TO PREVENT BACKFLOW
2	1	MOP SINK	-	-		1/2"CW,1/2" HW, 4" DRAIN	NSF, W/ MOP HOOKS, SEAL EDGES
	5	HAND SINK	_	-	-	1/2" CW,1/2" HW, 2" DRAIN	NSF, WALL MOUNTED - SEALED
4	1	72" X 36" PIZZA COOLER	_	120V	4A	=	NSF
5	1	72" X 30" ICE-CREAM DISPLAY FREEZER	-	120V	4.5A	_	NSF.W/ CASTERS
6	1	2 COMPARTMENT SINK (BAR)	-	-	-	1/2"CW,1/2" HW, 4" INDIRECT DRAIN	NSF,W/ ECOLAB PATHWAY TO PREVENT BACKFLOW
7	1	STAINLESS STEEL PREP COUNTER	Α.	120V	-	=	NSF
8	1	ICE BIN	-	-	-	4" INDIRECT DRAIN	NSF
9	2	CASHIER COUNTER	_	-	_	-	NSF
0	1	PREP SINK	-	-	-	1/2"CW,1/2" HW, 4" INDIRECT DRAIN	NSF,W/ ECOLAB PATHWAY TO PREVENT BACKFLOW
1	1	CHINESE WOK	1.5"	-	_	-	NSF, 770000 BTU
2	2	DEEP FRYER	3/4"	-	-	-	NSF, 120000 BTU
3	1	GAS STOCK POT RANGE	3/4"	1	н	-	NSF, 120000 BTU
4	2	14'-0" X 4'-0" TYPE I EXHAUST HOOD	1	-	-	_	U.L. W/ ANSUL FIRE SUPPRESSION SYSTEM
5	1	10'-0" X 10'-0" WALK IN FREEZER	-	240V	16A	-	NSF
16	1	1 COMPARTMENT SINK	-	-	=	1/2"CW,1/2" HW, 4" INDIRECT DRAIN	NSF,W/ ECOLAB PATHWAY TO PREVENT BACKFLOW
7	2	RICE COOKER	3/4"	-	_	-	NSF, 40000 BTU
8	1	ICE CREAM MACHINE	-	240V	3600W	1/2"CW, 4" INDIRECT DRAIN	NSF
9	1	10'-0" X 10'-0" WALK IN COOLER	-	240V	10A	-	NSF

	DOOR SCHEDULE									
TAG	DESCRIPTION	FRAME CONSTRUCTION	NOMINA	AL SIZ	Έ	DOOR FINISH	FRAME FINISH	LABEL	HARDWARE	COMMENTS
			WXH							
A	STORE FRONT GLASS DOOR	ALUMINUM	3'-0"	X	7'-0"	TEMPERED GLASS	ALUMINUM	_	3	EXIST'G
В	HOLLOW METAL DOOR	PRE-HUNG METAL	3'-0"	X	7'-0"	PAINT	PAINT	_	3	EXIST'G
С	WOOD DOOR	PRE-HUNG METAL	3'-0"	X	6'-8"	PAINT	PAINT	_	2	NEW
	ALL EXIT DOORS MUST	OPEN WITHOUT THE	E USE	OF A	KEY	OR SPECIAL KNOV	WLEDGE FRO	OM THE	SIDE WHI	CH EGRESS IS MADE
	LEVERED HANDLE HARDWARE AS REQUIRED BY ILLINOIS ACCESSIBILITY CODE									
	PROVIDE DOOR CLOSE	ERS ALONG ALL ACC	ESSIBL	ER	OUTE	S				

	ROOM FINISH SCHEDULE										
NO ROOM WALLS BASE FLOOR CEILING											
100	ENTRY	GYP. BD. PAINTED	QT COVE BASE	FLOOR TILE	GYP BD PAINTED						
101	WAITING AREA	GYP. BD. PAINTED	QT COVE BASE	FLOOR TILE	2X2 ACOUTIC TILE CEILING						
102	SERVICE AREA	WALL TILE	QT COVE BASE	QUARRY TILE	2X2 VINYL TILE CEILING						
103	KITCHEN	STAINLESS STEEL	QT COVE BASE	QUARRY TILE	2X4 VINYL TILE CEILING						
104	TOILET 1	CERAMIC TILE	CERAMIC TILE	FLOOR TILE	2X4 VINYL TILE CEILING						
105	TOILET 2	CERAMIC TILE	CERAMIC TILE	FLOOR TILE	2X4 VINYL TILE CEILING						

	HARDWARE SCHEDULE								
TAG	TAG DESCRIPTION								
1	1 1/2 PAIR BUTT HINGES, W/ SELF CLOSING DEVICE								
2	1 1/2 PAIR BUTT HINGES, SELF CLOSING DEVICE, ACCESSIBLE HARDWARE								
3	1 1/2 PAIR BUTT HINGES, PADDLE LATCH EXIT DEVICE AND DOOR CLOSER, PANIC HARDWARE								

#### KITCHEN EQUIPMENT NOTES

CONTRACTOR SHALL INSTALL AND CONNECT ALL EQUIPMENT AS PER EQUIPMENT SUPPLIER'S SPECIFICATIONS. ALL LOCATIONS TO BE VERIFIED WITH OWNER PRIOR TO INSTALLATION.

PLUMBING CONTRACTOR SHALL PROVIDE ALL ROUGH-INS. INSULATE ALL COLD/HOT WATER PIPES AS REQUIRED. MAINTAIN MIN 36" IN FRONT OF ALL COOKING EQUIPMENT.

ELECTRICAL CONTRACTOR SHALL PROVIDE ALL ELECTRICAL OUTLETS FOR

EQUIPMENT. VERIFY ALL ELECTRICAL REQUIREMENTS WITH EQUIPMENT SUPPLIER. VERIFY ALL GAS AND WATER REQUIREMENTS WITH EQUIPMENT SUPPLIER.

ALL PERMANENT EQUIPMENT MUST BE LOCATED SO THAT AREAS BEHIND, UNDERNEATH, AND ON THE SIDES OF THE EQUIPMENT CAN BE EASILY CLEANED

TWO DRAIN BOARDS ARE REQUIRED AT ALL THREE-COMPARTMENT SINKS ALONG WITH AN APPROPRIATELY SIZED FAUCET, LOCKABLE DRAIN PLUGS, AND AN INDIRECT CONNECTION TO THE SEWER.

#### DRY STORAGE

DRY STORAGE: 25% OF 1400SF (KITCHEN AREA.) = 350SF REQ'D ACTUAL DRY STORAGE 9X4X4X2+5X4X2+1X5X4X1.5 = 358SF PROVIDED.

ALL FOOD AND FOOD RELATED ITEMS MUST BE STORED OFF THE FLOOR ON DURABLE WASHABLE SHELVES. THE STORAGE AREA MUST BE APPROPRIATELY SIZED BASED ON THE NUMBER OF MEALS SERVED DAILY AND THE NUMBER OF DELIVERIES WEEKLY.

ALL FOOD EQUIPMENT TO BE ON CASTERS, 6" LEGS, OR SEALED TO THE FLOOR FOR EASY CLEANING.

NO RAW WOOD SURFACES PERMITTED ANYWHERE. UNDERSIDES OF COUNTERTOPS, INSIDE OF CABINETRY, AND WATER HEATER PLATFORMS MUST BE SEALED.

- Dial stem thermometers (ranging from 0° to 220°F) are required in all preparation areas.
- Chemical test kits (specific to the sanitizer) are required for the appropriate sanitizer.
- pH meter and log for acidifying rice.
- All cooling/freezing units must have accurate thermometers.
- Covered waste cans are required in all restrooms.
- Toilets, urinals, hand sinks, 3 compartment sinks, mop sink, prep sinks, and permanent counters/cabinets must be sealed to floors and walls with a silicone caulk seal.
- · Anti-siphon devices are required on all toilet tanks, urinals, and faucets with hose connections.
- Soap and paper towels are required at all hand sinks.
- Provide hair restraints and disposable gloves for all food handlers.

If sinks are provided with spring-loaded faucets, the faucets must remain running for a minimum of 15 seconds

Doors leading to the outside and restroom doors are required to be self-closing and tight-fitting. Please confirm that the doors leading to the outside are equipped with a self-closer and weather strips to eliminate any air gaps.

PROVIDE THE FOLLOWING: NSF STAINLESS STEEL OPEN WIRE SHELVING UNITS. NSF STAINLESS STEEL SHELF OVER 3-COMPTMENT SINK. ICE MAKER A MIN. 8" FROM ALL WALLS.

HEAVY-DUTY MOP RACKS LOCATED OVER MOP SINK.

HEAVY-DUTY BROOM RACKS IN JANITORIAL AREA. METAL GARBAGE CANS WITH LIDS FOR RESTROOMS. SANITARY BOX IN WOMEN'S RESTROOMS. METAL GARBAGE CANS WITH LIDS FOR DIAPER CHANGING STATION.

ALL NSF APPROVED HAND SINKS TO BE WITH BLADE HANDLED FAUCETS.

BEVERAGE STATION & BAR COUNTER TOP -STAINLESS STEEL.


ALL CABINET SHELVES -STAINLESS STEEL.

ALL CABINET BASE - 6" STAINLESS STEEL LEGS (NO KICK BASE)

LAVATORY COUNTERTOP TO BE SOLID SURFACE (NO PLASTIC LAMINATE OR CABINETRY)

ANY PAINTED FINISHES TO BE SEMI-GLOSS OR GLOSS (NO FLAT, NO EGG SHELL, NO TEXTURE), PROVIDE TILE ON WALL AND UNDERSIDE OF BAR.

STAINLESS STEEL WALL FINISH FOR BEHIND AND ADJACENT TO COOK LINE

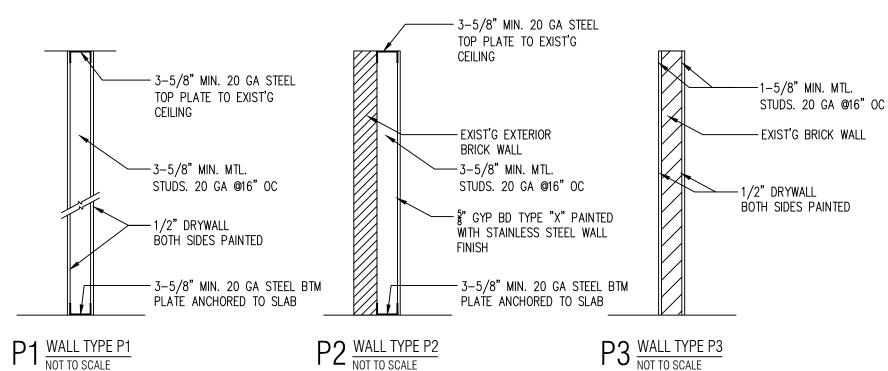

WEI TAN 2425 S WENTWORTH AVE CHICAGO IL 60616

Phone: (312) 912-5798 Email: twarchitect98@yahoo.com

LICENSE NO: 001-022013 EXPIRES: 11/30/2022

> Ш

 $\triangleleft$ 

SSUED FOR PERMIT




FLOOR PLANS & NOTES

DOOR PUSH/ PULL CLEARANCES TO COMPLY TO ICC/ ANSI SEC. 404 GRAPHICALLY DIMENSION ON ALL PROVIDE 1 ACCESSIBLE SEATING IN DINING ROOM TO INCLUDE RAISED AND/ OR LOWERED SEATING IF PLANS THE REQ'D PUSH/ PULL CLEARANCES AS REQ'D PER ACCESSIBILITY CODE. DOOR THRESHOLD CANNOT EXCEED 3/4" AND MUST BE BEVELED DOOR MIN WIDTH ON ALL PUBLIC FACILITIES TO BE MIN.

OF 36" WIDE WITH APPROPRIATE CLEARANCES.

BEING PROVIDED; ALL RAISED AND LOWERED SEATING MUST CONSIST OF AN ACCESS ROUTE TO THE ACCESSIBLE SEATING AS WELL AND MUST FULLY COMPLY TO ICC/ ANSI CHAPTER 18-11-1109.10

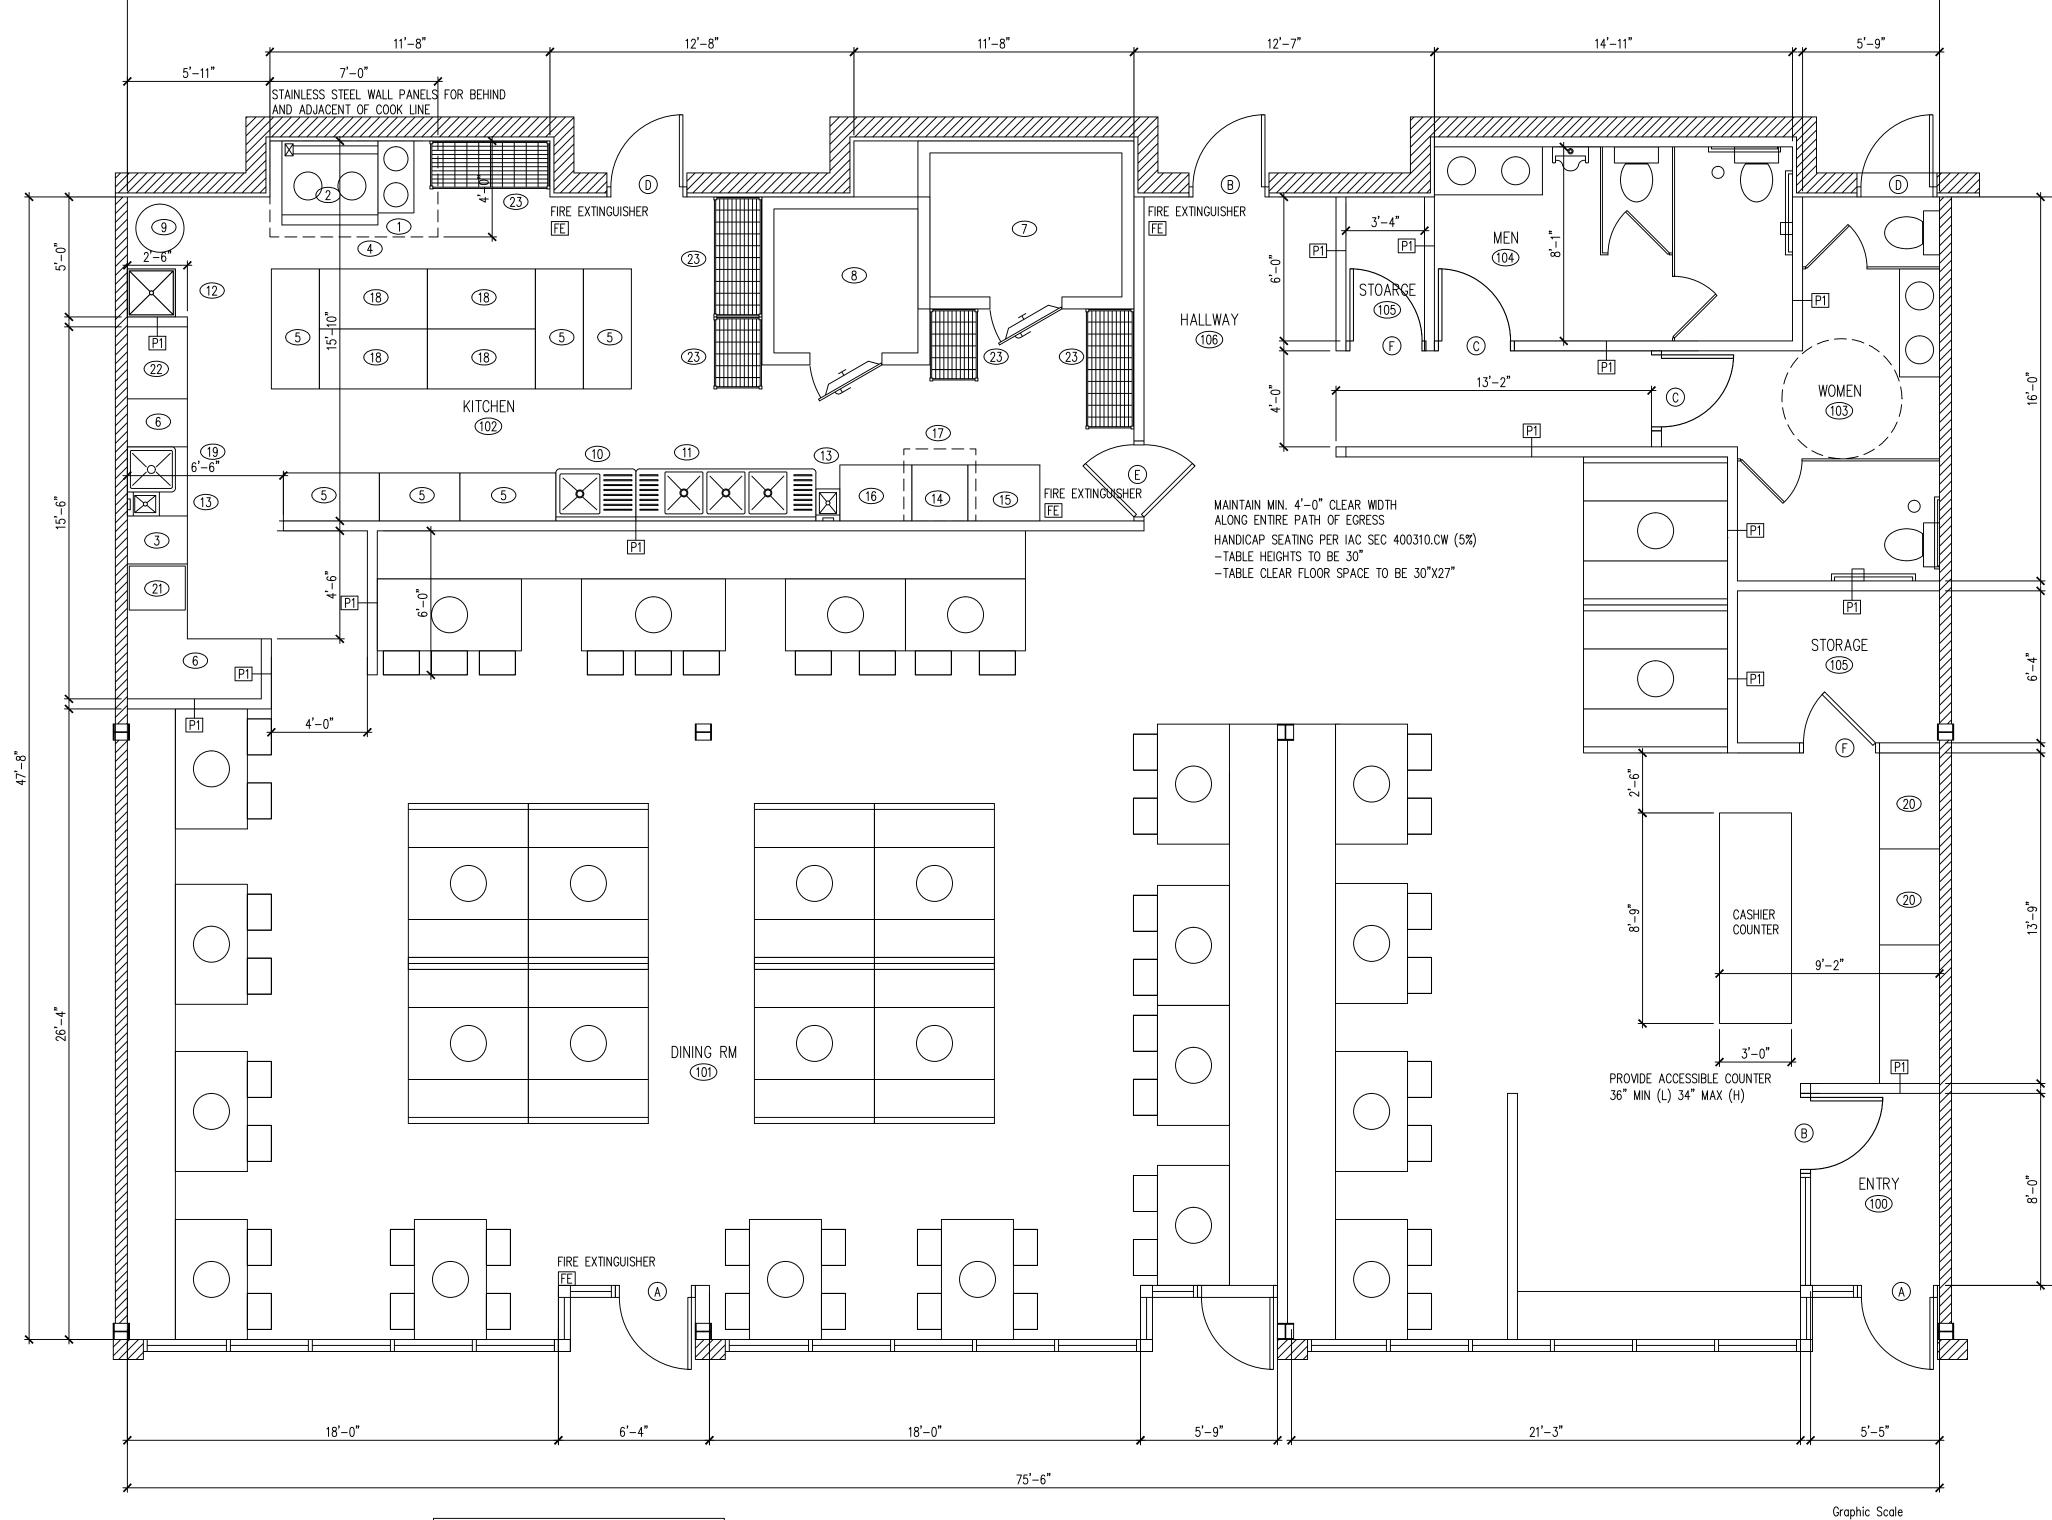

FIRE EXTINGUISHERS TO BE TYPE K IN KITCHEN A FLOOR SERVICE PLAN
SCALE 1/4"=1'-0" AND TYPE A IN DINING ROOM

DOOR SCHEDULE								
TAG	DESCRIPTION	FRAME CONSTRUCTION	NOMINAL SIZE	DOOR FINISH	FRAME FINISH	LABEL	HARDWARE SET	COMMENTS
			WXH					
Α	STORE FRONT GLASS DOOR	ALUMINUM	3'-0" x 7'-0"	TEMPERED GLASS	ALUMINUM	-	2	EXIST'G
В	TEMPERED GLASS DOOR	ALUMINUM	3'-0" x 7'-0"	TEMPERED GLASS	ALUMINUM	_	2	NEW
С	WOOD DOOR	WOOD	3'-0" x 6'-8"	PAINT	PAINT	-	1	NEW
D	METAL DOOR	EXIST'G METAL	3'-0" x 6'-8"	PAINT	PAINT	-	2	EXIST'G BACK EXIT DOOR
E	METAL DOOR	DOUBLE ACTION DOOR	3'-0" x 7'-0"	PAINT	PAINT	-	4	NEW
F	WOOD DOOR	WOOD	3'-0" x 7'-0"	PAINT	PAINT	-	3	NEW
	* ALL EVIT DOODS MUST ODEN WIT	HOLIT THE HEE OF A KEY	V OD CDECIAL KA	IOW/ EDGE EDOM	THE CIDE W/	IICH ECDE	TOO TO MADE	

\* ALL EXIT DOORS MUST OPEN WITHOUT THE USE OF A KEY OR SPECIAL KNOWLEDGE FROM THE SIDE WHICH EGRESS IS MADE

\* LEVERED HANDLE HARDWARE AS REQUIRED BY ILLINOIS ACCESSIBILITY CODE \* PROVIDE DOOR CLOSERS ALONG ALL ACCESSIBLE ROUTES

OCCUPANT LOAD SIGNAGE WILL BE PLACED IN A CONSPICUOUS LOCATION AT THE 10 0 5 10 ENTRANCE TO THE RESTAURANT AND EACH ASSEMBLY SPACE.


THE EXIT DOORS ARE EQUIPPED WITH PANIC HARDWARE.CBC 1008. 1. 9

1 1/2 PAIR BUTT HINGES

EMERGENCY AND GENERAL EGRESS DISCHARGE LIGHTING. CBC 1006.1 ON SHEET E1

	HARDWARE SCHEDULE
AG	DESCRIPTION
	1 1/2 PAIR BUTT HINGES, W/LEVERED PRIVACY LOCKSET , KICKPLATE AND SELF CLOSING DEVICE, ACCESSIBLE HARDWARE
)	1 1/2 PAIR BUTT HINGES, PADDLE LATCH EXIT DEVICE AND DOOR CLOSER, PANIC HARDWARE
~	1 1/2 PAIR BUTT HINGES, W/PRIVACY LOCKSET

1 Inch = 4 Feet

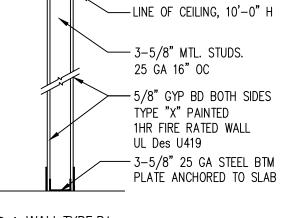

— 3–5/8" 25 GA STEEL

TOP PLATE

## P1 WALL TYPE P1 NOT TO SCALE

#### KITCHEN EQUIPMENT NOTES

CONTRACTOR SHALL INSTALL AND CONNECT ALL EQUIPMENT AS PER EQUIPMENT SUPPLIER'S SPECIFICATIONS. ALL LOCATIONS TO BE VERIFIED WITH OWNER PRIOR TO INSTALLATION. PLUMBING CONTRACTOR SHALL PROVIDE ALL ROUGH-INS. INSULATE ALL COLD/HOT WATER PIPES AS REQUIRED. MAINTAIN MIN 36" IN FRONT OF ALL COOKING EQUIPMENT.

ELECTRICAL CONTRACTOR SHALL PROVIDE ALL ELECTRICAL OUTLETS FOR EQUIPMENT. VERIFY ALL ELECTRICAL REQUIREMENTS WITH EQUIPMENT SUPPLIER. VERIFY ALL GAS AND WATER REQUIREMENTS WITH EQUIPMENT SUPPLIER. ALL PERMANENT EQUIPMENT MUST BE LOCATED SO THAT AREAS BEHIND, UNDERNEATH, AND ON THE SIDES OF THE EQUIPMENT CAN BE EASILY CLEANED.

TWO DRAIN BOARDS ARE REQUIRED AT ALL THREE-COMPARTMENT SINKS ALONG WITH AN APPROPRIATELY SIZED FAUCET, LOCKABLE DRAIN PLUGS, AND AN INDIRECT CONNECTION TO THE SEWER.

COOKLINE EQUIPMENT AND REACH-IN REFRIGERATION AND FREEZER UNITS TO BE INSTALLED ON CASTERS. PROVIDE THE FOLLOWING: NSF STAINLESS STEEL SHELF OVER 3-COMPTMENT SINK. HEAVY-DUTY MOP RACKS LOCATED OVER MOP SINK. METAL GARBAGE CANS WITH LIDS FOR RESTROOMS. SANITARY BOX IN RESTROOM. METAL GARBAGE CANS WITH LIDS FOR DIAPER CHANGING STATION.

Exhausted duct to make sure contractor installs vibration isolation pads at EVERY point where the support brackets touch any part of the building. There also needs to be sufficient vibration pads beneath any legs/supports on the roof. installing speakers make sure not to install into the ceiling space.

	ROOM FINISH SCHEDULE										
NO	ROOM	WALLS	BASE	FLOOR	CEILING						
100	ENTRY	TEMPERED GLASS	QT COVE BASE	FLOOR TILE	2'X2' LAY IN CEILIN						
101	DINING ROOM	GYP. BD. PAINTED	QT COVE BASE	FLOOR TILE	OPEN CEILING						
102	KITCHEN	STAINLESS STEEL/FRP	QT COVE BASE	QUARRY TILE	2'X4' VINYL CEILING						
103	WOMEN'S	CERAMIC TILE	QT COVE BASE	FLOOR TILE	2'X2' VINYL CEILING						
104	MEN'S	CERAMIC TILE	QT COVE BASE	FLOOR TILE	2'X2' VINYL CEILING						
105	STORAGE	TEMPERED GLASS	QT COVE BASE	FLOOR TILE	2'X2' LAY IN CEILIN						
106	HALLWAY	GYP. BD. PAINTED	QT COVE BASE	FLOOR TILE	OPEN CEILING						

NO	QTY	DESCRIPTION	GAS	ELECT	RIC	PLUMBING	REMARKS	
1	1	SOUP STOVE	3/4"	E		-	NSF, 34000 BTU	
2	1	2 BURNER CHINESE WOK	3/4"	-	-	1/2"CW, 3" INDIRECT DRAIN	NSF, 220000 BTU	
3	1	WATER BOILER	-	240V		1/2"CW, 3" INDIRECT DRAIN	NSF	
4	1	7'-0"X4'-0" EXHAUST HOOD,TYPE I		-		-	U.L. W/ANSUL FIRE SUPPRESSION SYSTEM	
5	6	WORK TABLE	9	1	-	-	NSF,W/ 6" STAINLESS STEEL LEGS NSF APPROVED	
6	1	STAINLESS COUNTER	-		-	-	NSF	
7	1	9'-0"X7'-0" WALK-IN COOLER	=	240V	1 HP 9A	=	NSF	
8	1	7'-0"X7'-0" WALK-IN FREEZER	_	240V	1 HP 9A	-	NSF	
9	1	HOT WATER HEATER	3/4"	120V	_	1" CW & 1" HW	NSF, 100 GALLONS	
10	1	1 SINGLE COMPARTMENT SINK				1/2"CW,1/2" HW, 3" INDIRECT DRAIN	NSF,W/ ECOLAB PATHWAY TO PREVENT BACKFLOW	
11	1	3 COMPARTMENT SINK		1	-	1/2"CW,1/2" HW, 3" INDIRECT DRAIN	NSF,W/ ECOLAB PATHWAY TO PREVENT BACKFLOW	
12	1	MOP SINK	-	=		1/2"CW,1/2" HW, 3" DRAIN	NSF, W/ MOP HOOKS, SEAL EDGES	
13	2	HAND SINK	_	_	<u> </u>	1/2" CW,1/2" HW, 2" DRAIN	NSF, WALL MOUNTED - SEALED	
14	1	DISHWASHER	6	240V		1/2" HW, 3" DRAIN	NSF	
15	1	3' DISHTABLE (SOILED)	-	-		1/2"CW,1/2" HW, 3" INDIRECT DRAIN	NSF,W/ 6" STAINLESS STEEL LEGS NSF APPROVED	
16	1	3' DISHTABLE (CLEAN)	-	-		-	NSF,W/ 6" STAINLESS STEEL LEGS NSF APPROVED	
17	1	3'-6"X3'-6" EXHAUST HOOD,TYPE II	_	1		-	NSF	
18	4	54" REACH-IN REFRIGERATOR	=	120V		-	NSF, W/CASTER	
19	1	SERVICE SINK	i i	-		1/2"CW,1/2" HW, 3" INDIRECT DRAIN	NSF,W/ ECOLAB PATHWAY TO PREVENT BACKFLOW	
20	2	UNDERCOUNTER COOLER	9	120V		_	NSF	
21	1	STEEL COUNTER W/ICE BIN				3" INDIRECT DRAIN	NSF	
22	1	ICE MAKER		240V		1/2" CW, 3" INDIRECT DRAIN	NSF,W/ CASTERS	
23	5	SHELVING					NSF,W/ CASTERS	

TAN ARCHITECT FIRM 2425 S WENTWORTH AVE CHICAGO, IL 60616

EXPIRES: 11/30/2020

PHONE: (312) 912-5798 EMAIL: twarchitect98@yahoo.com

LICENSE NO: 001-022013

MEP PROFESSIONAL ENGINEER 236 W ALEXANDER STREET CHICAGO IL 60616


PHONE: (312)720-8800 BILLY\_WANG68@HOTMAIL.COM LICENSE NO: 062.068227 EXPIRES: 11 / 30 /2019

OWNER

ELING  $\triangleleft$ Z T

04/15/2019 SSUED FOR PERMIT

> DEMO PLAN, FLOOR PLAN &

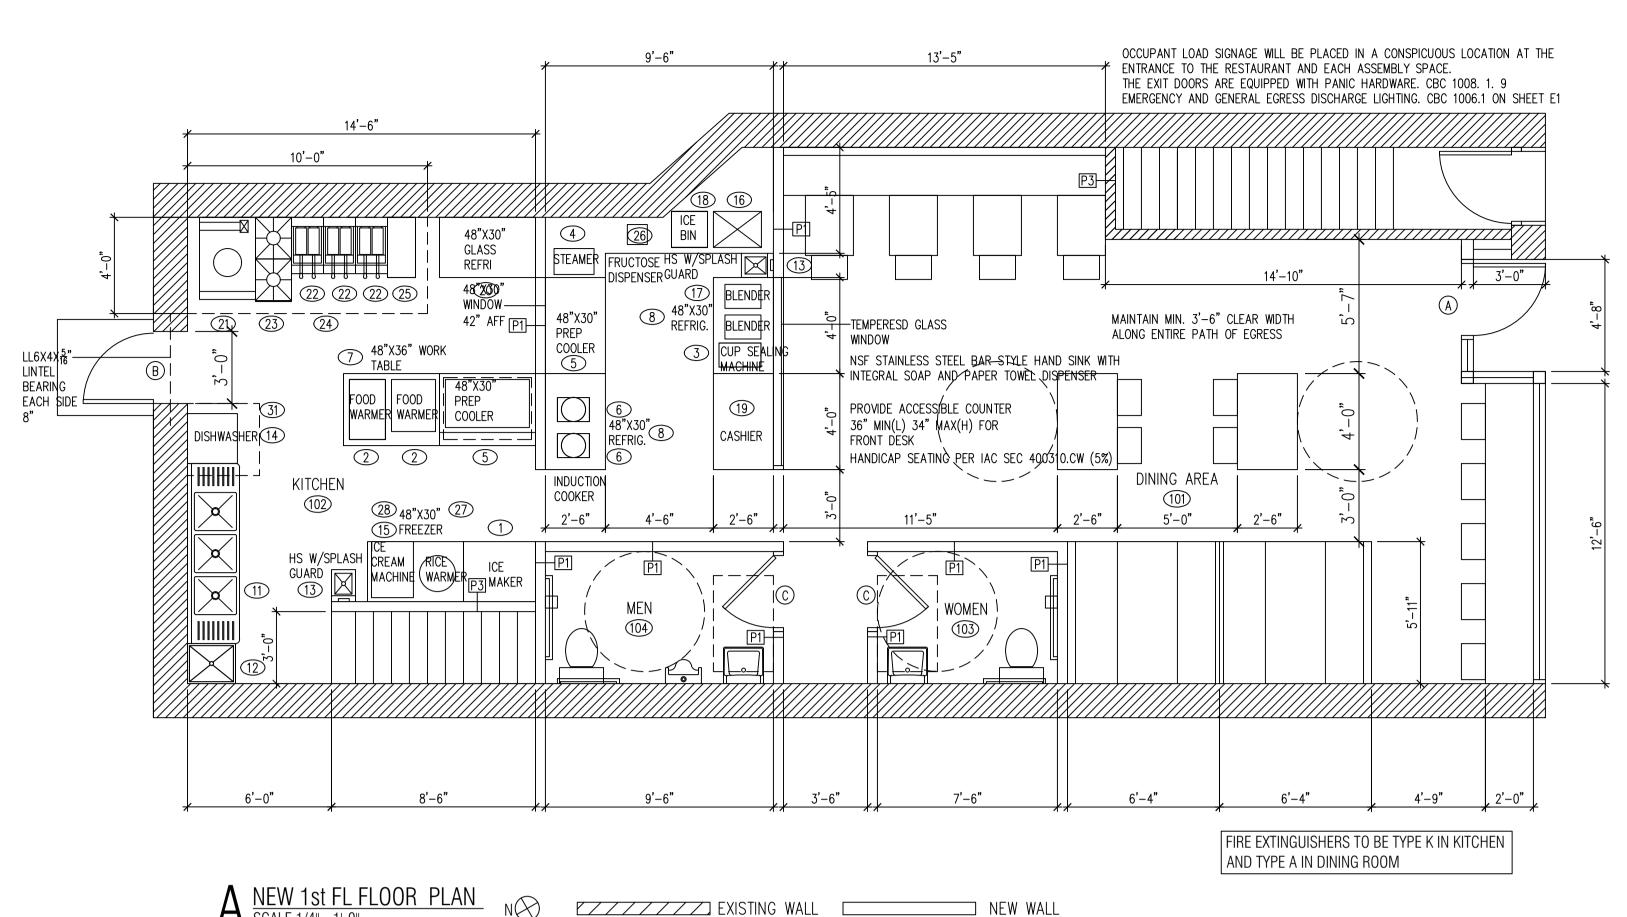

NO	QTY	DESCRIPTION	GAS	ELECTF	RIC	PLUMBING	REMARKS	
1	1	ICE MAKER	-	220V	10A	1/2" CW	NSF,AIR COOLED CONDENSING UNIT	
2	4	FOOD WARMER	-	120V	12A	-	NSF	
3	1	CUP SEALING MACHINE	-	120V	-	-	NSF	
4	1	BEVERAGE STEAMER	-	220V	20A	1/2"CW, 4" INDIRECT DRAIN	NSF	
5	2	48" X 30" PREP COOLER	-	120V	8A	-	NSF,W/ CASTERS	
6	2	INDUCTION COOKER	_	240V	3500W	-	NSF	
7	1	WORK TABLE	-	_	-	-	NSF,W/ 6" STAINLESS STEEL LEGS NSF APPROVED	
8	2	48" X 30" UNDERCOUNTER REFRIG.	-	120V	2.7A	-	NSF	
9	1	75 GALLON HWH	1"	120V	-	3/4" CW & 3/4" HW	NSF	
10	5	SHELVING	-	-		-	NSF APPROVED STAINLESS STEEL SHELVING	
11	1	3 COMPARTMENT SINK	_	_	-	1/2" CW,1/2" HW,4" INDIRECT DRAIN	NSF,W/ ECOLAB PATHWAY TO PREVENT BACKFLOW	
12	1	MOP SINK	-	-		1/2"CW,1/2" HW, 4" DRAIN	NSF, W/ MOP HOOKS, SEAL EDGES	
13	2	HAND SINK	-	-	-	1/2" CW,1/2" HW, 2" DRAIN	NSF, WALL MOUNTED - SEALED	
14	1	DISHWASHER	-	120V	16A	1/2"CW, 4" INDIRECT DRAIN	NSF	
15	1	48" X 30" FREEZER	-	120V	4.5A	-	NSF,W/ CASTERS	
16	1	BAR SINK	-	-	-	1/2"CW,1/2" HW, 4" INDIRECT DRAIN	NSF,W/ ECOLAB PATHWAY TO PREVENT BACKFLOW	
17	2	BLENDER	-	120V	H	-	NSF	
18	1	ICE BIN	-	-	1-	4" INDIRECT DRAIN	NSF	
19	1	CASHIER COUNTER	-	-	-	-	NSF	
20	1	48" X 30" GLASS REFRIG.	-	120V	4.8A	-	NSF,W/ CASTERS	
21	1	CHINESE WOK	3/4"	-	-	-	NSF, 120000 BTU	
22	3	DEEP FRYER	3/4"	-	iu .	_	NSF, 120000 BTU	
23	1	GAS STOCK POT RANGE	3/4"	-	-	-	NSF, 160000 BTU	
24	1	10'-0" X4' TYPE I EXHAUST HOOD	-	-	1-	-	U.L. W/ ANSUL FIRE SUPPRESSION SYSTEM	
25	1	12" RADIANT CHARBROILER	3/4"	-	-	-	NSF, 80000BTU	
26	1	FRUCTOSE DISPENSER	-	120V	1-	-	NSF	
27	1	RICE WARMER	-	120V	-	-	NSF	
28	1	ICE CREAM MACHINE	-	120V	2200W	-	NSF	
29	1	8'X10' WALK IN COOLER	-	240V	10A	-	NSF	
30	1	8'X10' WALK IN FREEZER	-	240V	16A	-	NSF	
31	1	3'X3' TYPE II EXHAUST HOOD	-	-	1-	-	NSF	

				D	00R S	SCHEDULE					
TAG	DESCRIPTION	FRAME CONSTRUCTION	NOMINA W X H	AL SI	ZE	DOOR FINISH	FRAME FINISH	LABEL	HARDWARE	COMMENTS	
Α	STORE FRONT GLASS DOOR	ALUMINUM	3'-0"	X	8'-6"	TEMPERED GLASS	ALUMINUM	-	3	NEW	
В	HOLLOW METAL DOOR	PRE-HUNG METAL	3'-0"	X	7'-0"	PAINT	PAINT	-	3	NEW	
С	WOOD DOOR	PRE-HUNG METAL	3'-0"	X	6'-8"	PAINT	PAINT	-	2	NEW	
D	D WOOD DOOR PRE-HUNG METAL 3'-0" x 7'-0" PAINT - 1 EXIST'G										
	ALL EXIT DOORS MUST OPEN WITHOUT THE USE OF A KEY OR SPECIAL KNOWLEDGE FROM THE SIDE WHICH EGRESS IS MADE										
	LEVERED HANDLE HAR	DWARE AS REQUIRE	D BY I	LLIN	NOIS A	CCESSIBILITY COI	DE				

PROVIDE DOOR CLOSERS ALONG ALL ACCESSIBLE ROUTES

	ROOM FINISH SCHEDULE										
NO	ROOM	WALLS	BASE	FLOOR	CEILING						
101	DINING AREA	GYP. BD. PAINTED	QT COVE BASE	FLOOR TILE	GYP BD PAINTED						
102	KITCHEN	STAINLESS STEEL	QT COVE BASE	QUARRY TILE	2X4 VINYL TILE CEILING						
103	WOMEN	CERAMIC TILE	CERAMIC TILE	FLOOR TILE	GYP BD PAINTED						
104	MEN	CERAMIC TILE	CERAMIC TILE	FLOOR TILE	GYP BD PAINTED						
105	DRY STORAGE	FRP	QT COVE BASE	QUARRY TILE	EPOXY GYP BD PAINTED						

#### KITCHEN EQUIPMENT NOTES

CONTRACTOR SHALL INSTALL AND CONNECT ALL EQUIPMENT AS PER EQUIPMENT SUPPLIER'S SPECIFICATIONS. ALL LOCATIONS TO BE VERIFIED WITH OWNER PRIOR TO INSTALLATION.

PLUMBING CONTRACTOR SHALL PROVIDE ALL ROUGH-INS. INSULATE ALL COLD/HOT WATER PIPES AS REQUIRED. MAINTAIN MIN 36" IN FRONT OF ALL COOKING EQUIPMENT.

ELECTRICAL CONTRACTOR SHALL PROVIDE ALL ELECTRICAL OUTLETS FOR EQUIPMENT. VERIFY ALL ELECTRICAL REQUIREMENTS WITH EQUIPMENT SUPPLIER. VERIFY ALL GAS AND WATER REQUIREMENTS WITH EQUIPMENT SUPPLIER.

ALL PERMANENT EQUIPMENT MUST BE LOCATED SO THAT AREAS BEHIND, UNDERNEATH, AND ON THE SIDES OF THE EQUIPMENT CAN BE EASILY CLEANED.

TWO DRAIN BOARDS ARE REQUIRED AT ALL THREE-COMPARTMENT SINKS ALONG WITH AN APPROPRIATELY SIZED FAUCET, LOCKABLE DRAIN PLUGS, AND AN INDIRECT CONNECTION TO THE SEWER.

## DRY STORAGE

DRY STORAGE: 25% OF 525 SF (KITCHEN AREA.)=131SF REQ'D ACTUAL DRY STORAGE 5X4X4X2 = 160SF PROVIDED.

ALL FOOD AND FOOD RELATED ITEMS MUST BE STORED OFF THE FLOOR ON DURABLE WASHABLE SHELVES. THE STORAGE AREA MUST BE APPROPRIATELY SIZED BASED ON THE NUMBER OF MEALS SERVED DAILY AND THE NUMBER OF DELIVERIES WEEKLY.

ALL FOOD EQUIPMENT TO BE ON CASTERS, 6" LEGS, OR SEALED TO THE FLOOR FOR EASY CLEANING.

NO RAW WOOD SURFACES PERMITTED ANYWHERE. UNDERSIDES OF COUNTERTOPS, INSIDE OF CABINETRY, AND WATER HEATER PLATFORMS MUST BE SEALED.

- Dial stem thermometers (ranging from 0° to 220°F) are required in all preparation areas.
- Chemical test kits (specific to the sanitizer) are required for the appropriate sanitizer.
- pH meter and log for acidifying rice.
- All cooling/freezing units must have accurate thermometers.
- Covered waste cans are required in all restrooms
- Toilets, urinals, hand sinks, 3 compartment sinks, mop sink, prep sinks, and permanent counters/cabinets must be sealed to floors and walls with a silicone caulk seal.
- Anti-siphon devices are required on all toilet tanks, urinals, and faucets with hose
- Soap and paper towels are required at all hand sinks.
- Provide hair restraints and disposable gloves for all food handlers.

If sinks are provided with spring-loaded faucets, the faucets must remain running for a minimum

Doors leading to the outside and restroom doors are required to be self-closing and tight-fitting. Please confirm that the doors leading to the outside are equipped with a self-closer and weather strips to eliminate any air gaps.

HARDWARE SCHEDULE DESCRIPTION 1 1/2 PAIR BUTT HINGES, W/ SELF CLOSING DEVICE 1 1/2 PAIR BUTT HINGES, SELF CLOSING DEVICE, ACCESSIBLE HARDWARE 3 1 1/2 PAIR BUTT HINGES, PADDLE LATCH EXIT DEVICE AND DOOR CLOSER, PANIC HARDWARE


PROVIDE THE FOLLOWING: NSF STAINLESS STEEL OPEN WIRE SHELVING UNITS. NSF STAINLESS STEEL SHELF OVER 3-COMPTMENT SINK. ICE MAKER A MIN. 8" FROM ALL WALLS. HEAVY-DUTY MOP RACKS LOCATED OVER MOP SINK. HEAVY-DUTY BROOM RACKS IN JANITORIAL AREA. METAL GARBAGE CANS WITH LIDS FOR RESTROOMS. SANITARY BOX IN WOMEN'S RESTROOMS. METAL GARBAGE CANS WITH LIDS FOR DIAPER CHANGING STATION. ALL NSF APPROVED HAND SINKS TO BE WITH BLADE HANDLED FAUCETS.

BEVERAGE STATION & BAR COUNTER TOP -STAINLESS STEEL ALL CABINET SHELVES -STAINLESS STEEL ALL CABINET BASE - 6" STAINLESS STEEL LEGS (NO KICK BASE)

LAVATORY COUNTERTOP TO BE SOLID SURFACE (NO PLASTIC LAMINATE OR CABINETRY) ANY PAINTED FINISHES TO BE SEMI-GLOSS OR GLOSS (NO FLAT, NO EGG SHELL, NO TEXTURE), PROVIDE TILE ON WALL AND UNDERSIDE OF BAR.

STAINLESS STEEL WALL FINISH FOR BEHIND AND ADJACENT TO COOK LINE

- 2-2X4 WD PLATE - 2-2X4 WD PLATE TO EXIST'G CEILING TO EXIST'G CEILING - 3-5/8" MIN. 20 GA STEEL TOP PLATE TO EXIST'G CEILING - EXIST'G EXTERIOR BRICK WALL \_\_\_\_2X4 WD STUDS @ 16" -3-5/8" MIN. MTL. STUDS. 20 GA @16" OC §" GYP BD TYPE "X" BOTH SIDES PAINTED — 2X4 WD STUDS @ 16" — 1/2" DRYWALL PAINTED - §" GYP BD TYPE "X" PAINTED - 2X4 WD PLATE — 2X4 WD PLATE — 3-5/8" MIN. 20 GA STEEL BTM PLATE ANCHORED TO SLAB ANCHORED TO SLAB

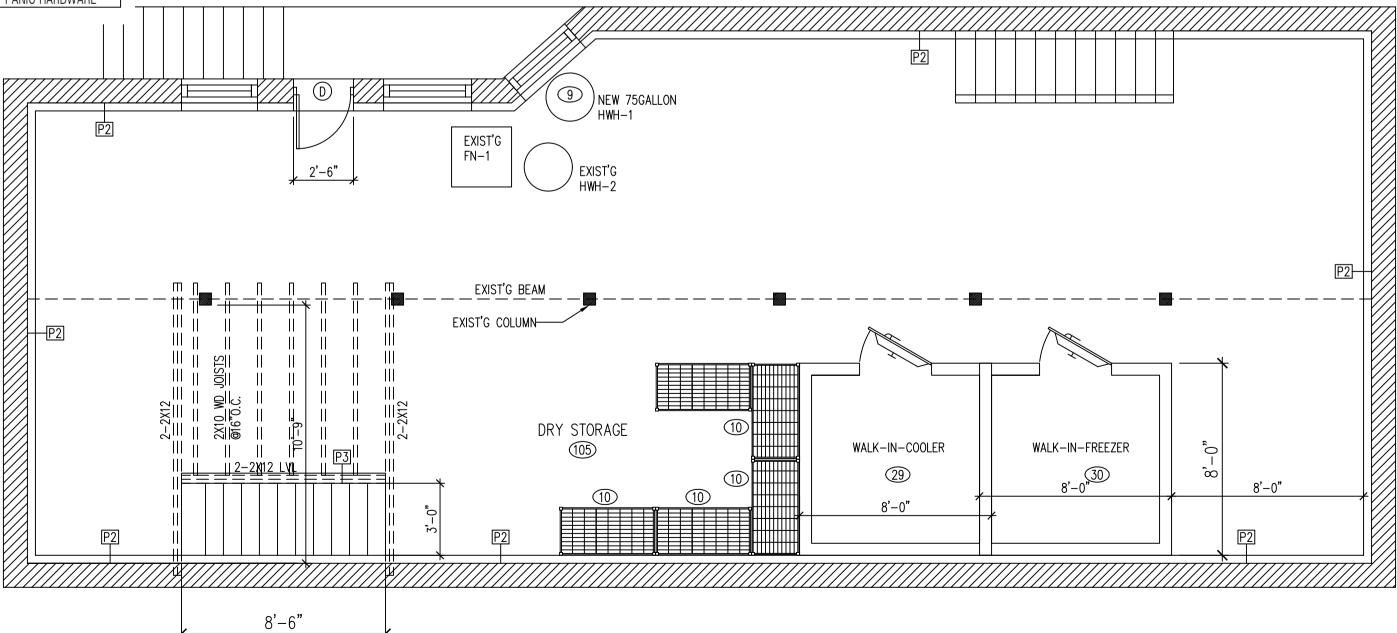



EXISTING WALL \_\_\_\_ NEW WALL

DEPARTMENT OF BUILDINGS STANDARD PLAN REVIEW CONDITIONAL PERMIT Construction subject to full compliance with the Municipal Code o Chicago and field inspection

> SELF CERTIFICATION

TW ARCHITECT 2425 S WENTWORTH AVE CHICAGO, IL 60616

PHONE: (312) 912-5798 EMAIL: twarchitect98@yahoo.com

LICENSE NO: 001-022013 EXPIRES: 11/30/2022

4705 N LINCOLN AVE CHICAGO IL 60625

 $\overline{\simeq}$ 

 $\perp$ 

SSUED FOR PERMIT REISSUED FOR PERMI 2/14/2022



FLOOR PLANS & NOTES




DEPARTMENT OF BUILDINGS



Phone: (312) 912-5798 Email: twarchitect98@yahoo.com

LICENSE NO: 001-022013 EXPIRES: 11/30/2022


> $\overline{\simeq}$

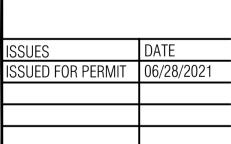



**NEW FLOOR** PLANS


SHEET NUMBER

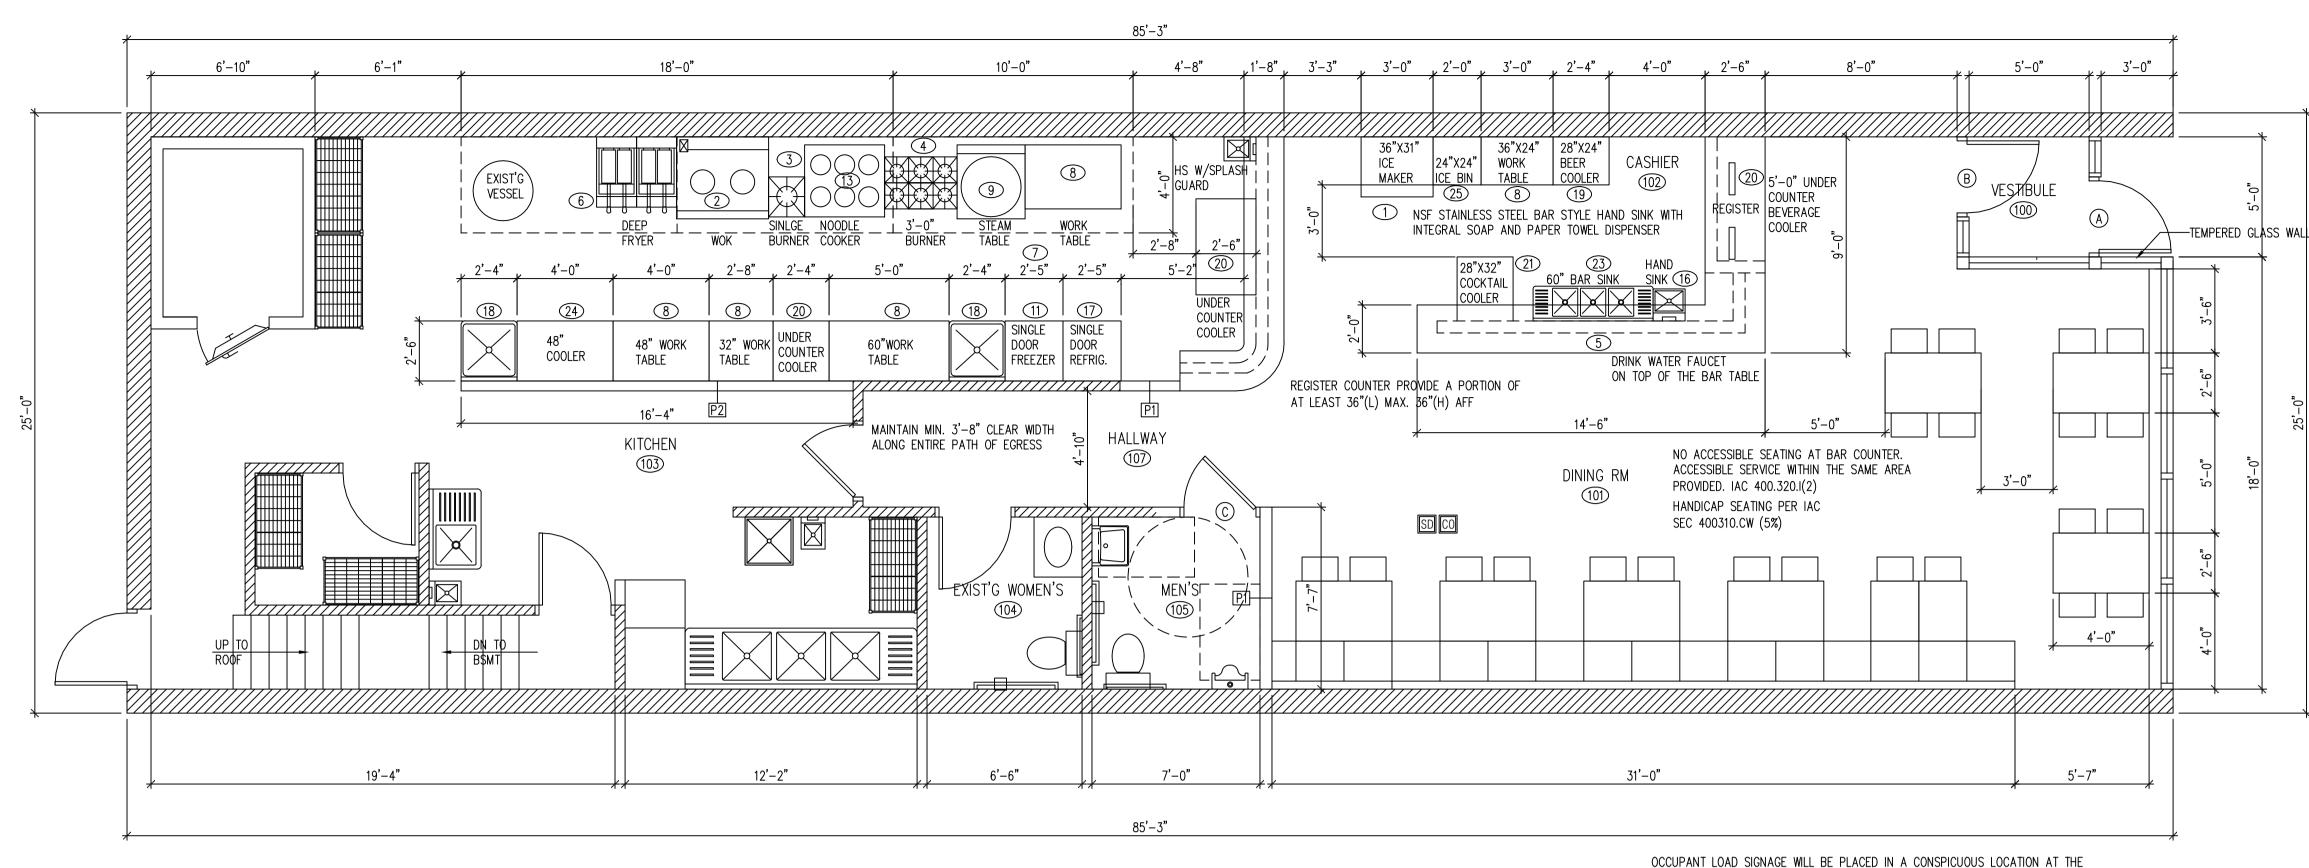

NEW WALL

NEW WALL

ENTRANCE TO THE RESTAURANT AND EACH ASSEMBLY SPACE. THE EXIT DOORS ARE EQUIPPED WITH PANIC HARDWARE. CBC 1008. 1. 9 EMERGENCY AND GENERAL EGRESS DISCHARGE LIGHTING.CBC 1006.1 ON SHEET E2

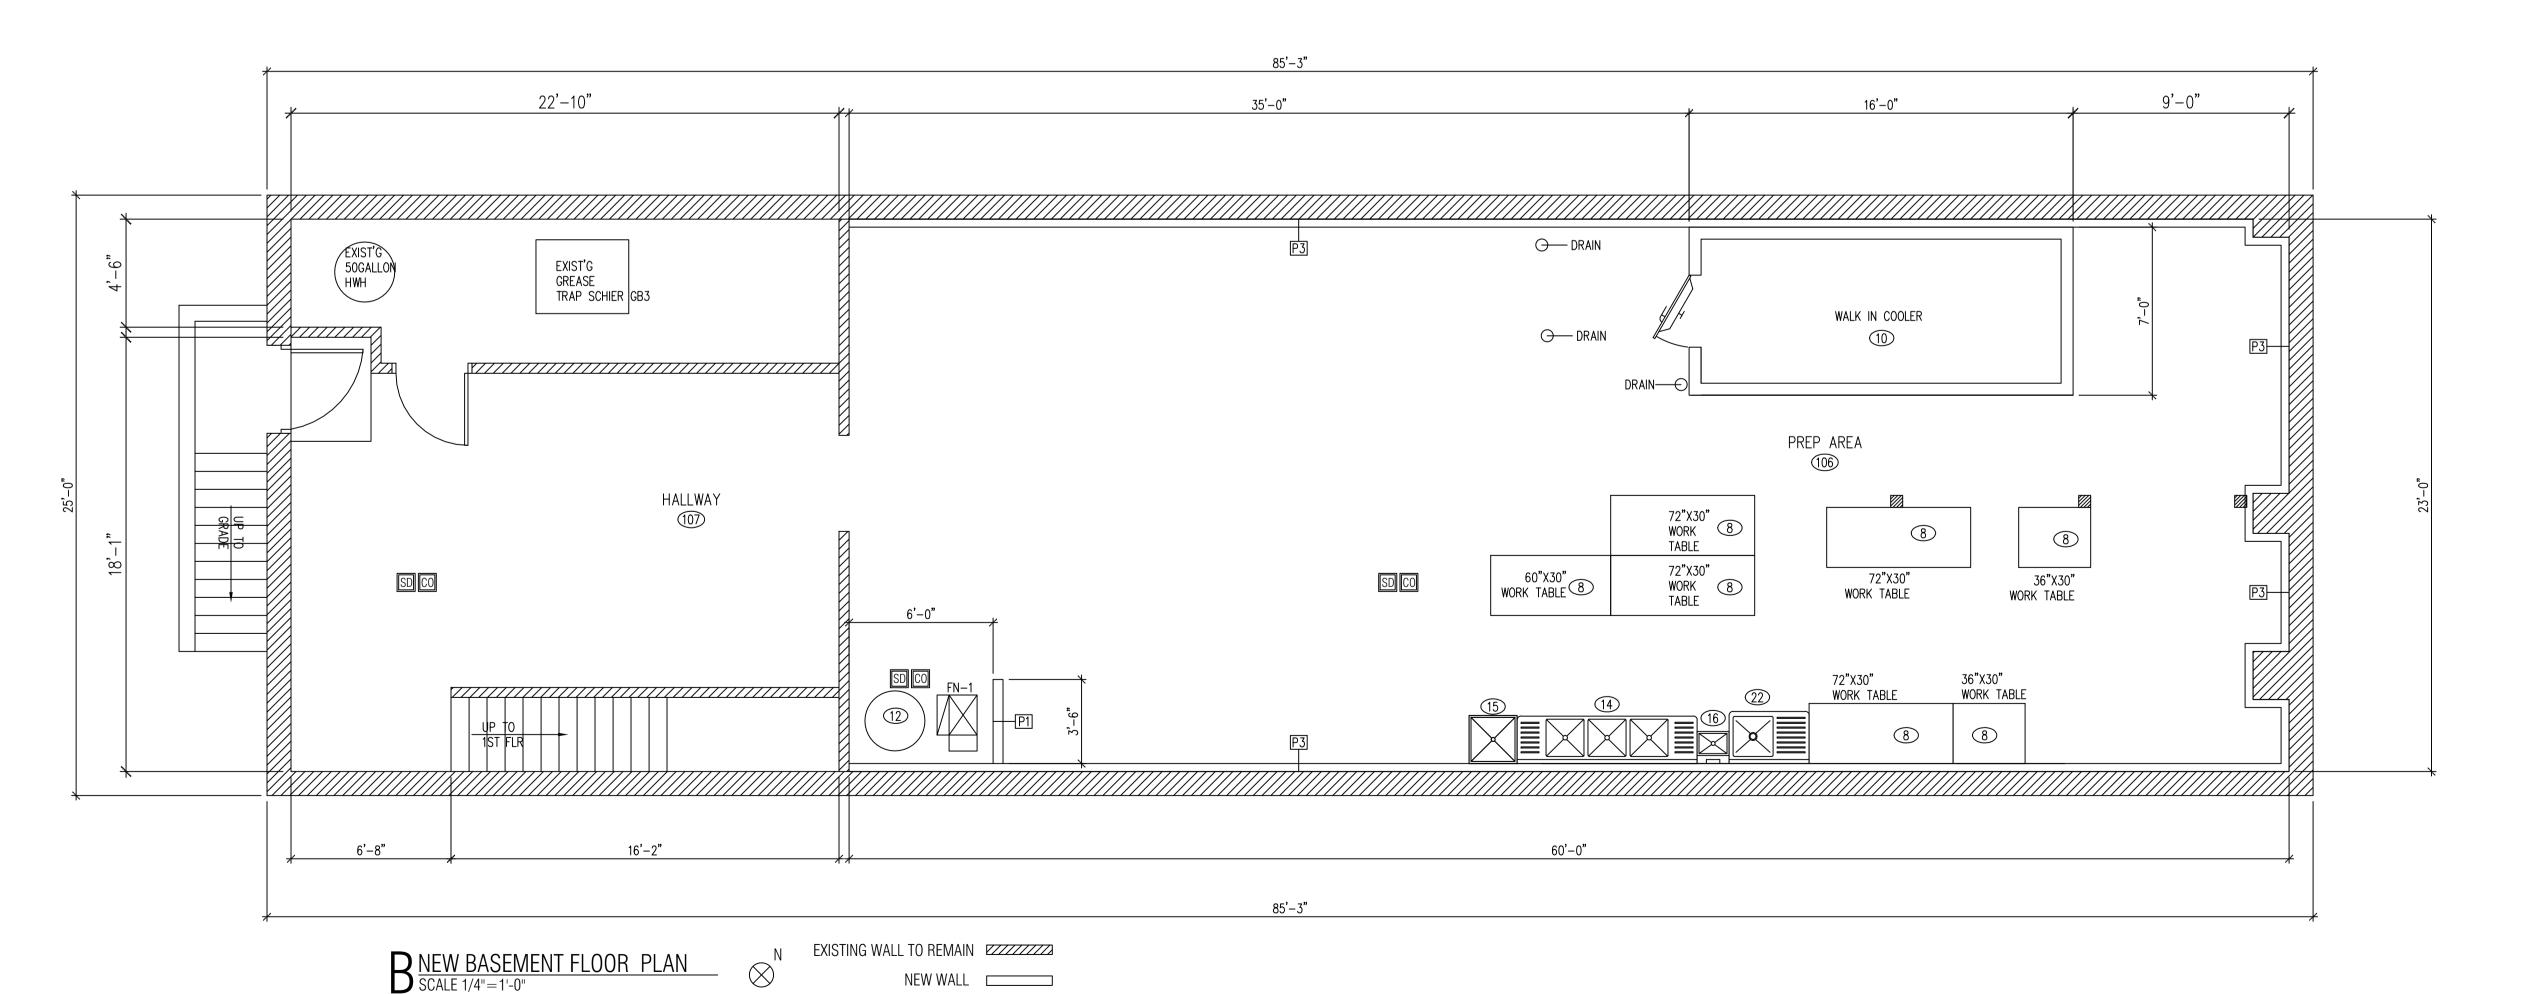

**Permit Reviewer: EB APPROVED WITH** CONDITIONS

**COMMISSION ON** 

**CHICAGO LANDMARKS** 

DATE & CONDITIONS:

8/9/21 Existing stone to remain. New storefront as per stamped plans.

#### KITCHEN EQUIPMENT NOTES

CONTRACTOR SHALL INSTALL AND CONNECT ALL EQUIPMENT AS PER EQUIPMENT SUPPLIER'S SPECIFICATIONS. ALL LOCATIONS TO BE VERIFIED WITH OWNER PRIOR TO INSTALLATION.

PLUMBING CONTRACTOR SHALL PROVIDE ALL ROUGH-INS. INSULATE ALL COLD/HOT WATER PIPES AS REQUIRED. MAINTAIN MIN 36" IN FRONT OF ALL COOKING EQUIPMENT.

ELECTRICAL CONTRACTOR SHALL PROVIDE ALL ELECTRICAL OUTLETS FOR EQUIPMENT. VERIFY ALL ELECTRICAL REQUIREMENTS WITH EQUIPMENT SUPPLIER. VERIFY ALL GAS AND WATER REQUIREMENTS WITH EQUIPMENT SUPPLIER.

ALL PERMANENT EQUIPMENT MUST BE LOCATED SO THAT AREAS BEHIND, UNDERNEATH, AND ON THE SIDES OF THE EQUIPMENT CAN BE EASILY CLEANED.

TWO DRAIN BOARDS ARE REQUIRED AT ALL THREE-COMPARTMENT SINKS ALONG WITH AN APPROPRIATELY SIZED FAUCET, LOCKABLE DRAIN PLUGS, AND AN INDIRECT CONNECTION TO THE SEWER.

#### DRY STORAGE

DRY STORAGE: 25% OF 1600SF (KITCHEN AREA.) = 400SF REQ'D ACTUAL DRY STORAGE 400SF PROVIDED. LIQUOR STORAGE: 35% OF BAR AREA = 35%X180=63SF REQ'D ACTURAL STORAGE: 63SF PROVIDED.

ALL FOOD AND FOOD RELATED ITEMS MUST BE STORED OFF THE FLOOR ON DURABLE WASHABLE SHELVES. THE STORAGE AREA MUST BE APPROPRIATELY SIZED BASED ON THE NUMBER OF MEALS SERVED DAILY AND THE NUMBER OF DELIVERIES WEEKLY.

ALL FOOD EQUIPMENT TO BE ON CASTERS, 6" LEGS, OR SEALED TO THE FLOOR FOR EASY CLEANING.

NO RAW WOOD SURFACES PERMITTED ANYWHERE. UNDERSIDES OF COUNTERTOPS, INSIDE OF CABINETRY, AND WATER HEATER PLATFORMS MUST BE SEALED.

Dial stem thermometers (ranging from 0° to 220°F) are required in all preparation areas.

- Chemical test kits (specific to the sanitizer) are required for the appropriate sanitizer.
- pH meter and log for acidifying rice.
- All cooling/freezing units must have accurate thermometers.
- Covered waste cans are required in all restrooms.
- Toilets, urinals, hand sinks, 3 compartment sinks, mop sink, prep sinks, and permanent counters/cabinets must be sealed to floors and walls with a silicone caulk seal.
- Anti-siphon devices are required on all toilet tanks, urinals, and faucets with hose connections.
- Soap and paper towels are required at all hand sinks.
- Provide hair restraints and disposable gloves for all food handlers.
- If sinks are provided with spring-loaded faucets, the faucets must remain running for a minimum

Doors leading to the outside and restroom doors are required to be self-closing and tight-fitting. Please confirm that the doors leading to the outside are equipped with a self-closer and weather strips to eliminate any air gaps.



TW ARCHITECT INC 2425 S WENTWORTH AVE CHICAGO IL 60616

Phone: (312) 912-5798 Email: twarchitect98@yahoo.com

LICENSE NO: 001-022013


EXPIRES: 11/30/2022

 $\geq$ SSUED FOR PERMIT 03/25/2021 ISSUED FOR PERMIT

001-022013

FLOOR PLAN & NOTES

SHEET NUMBER

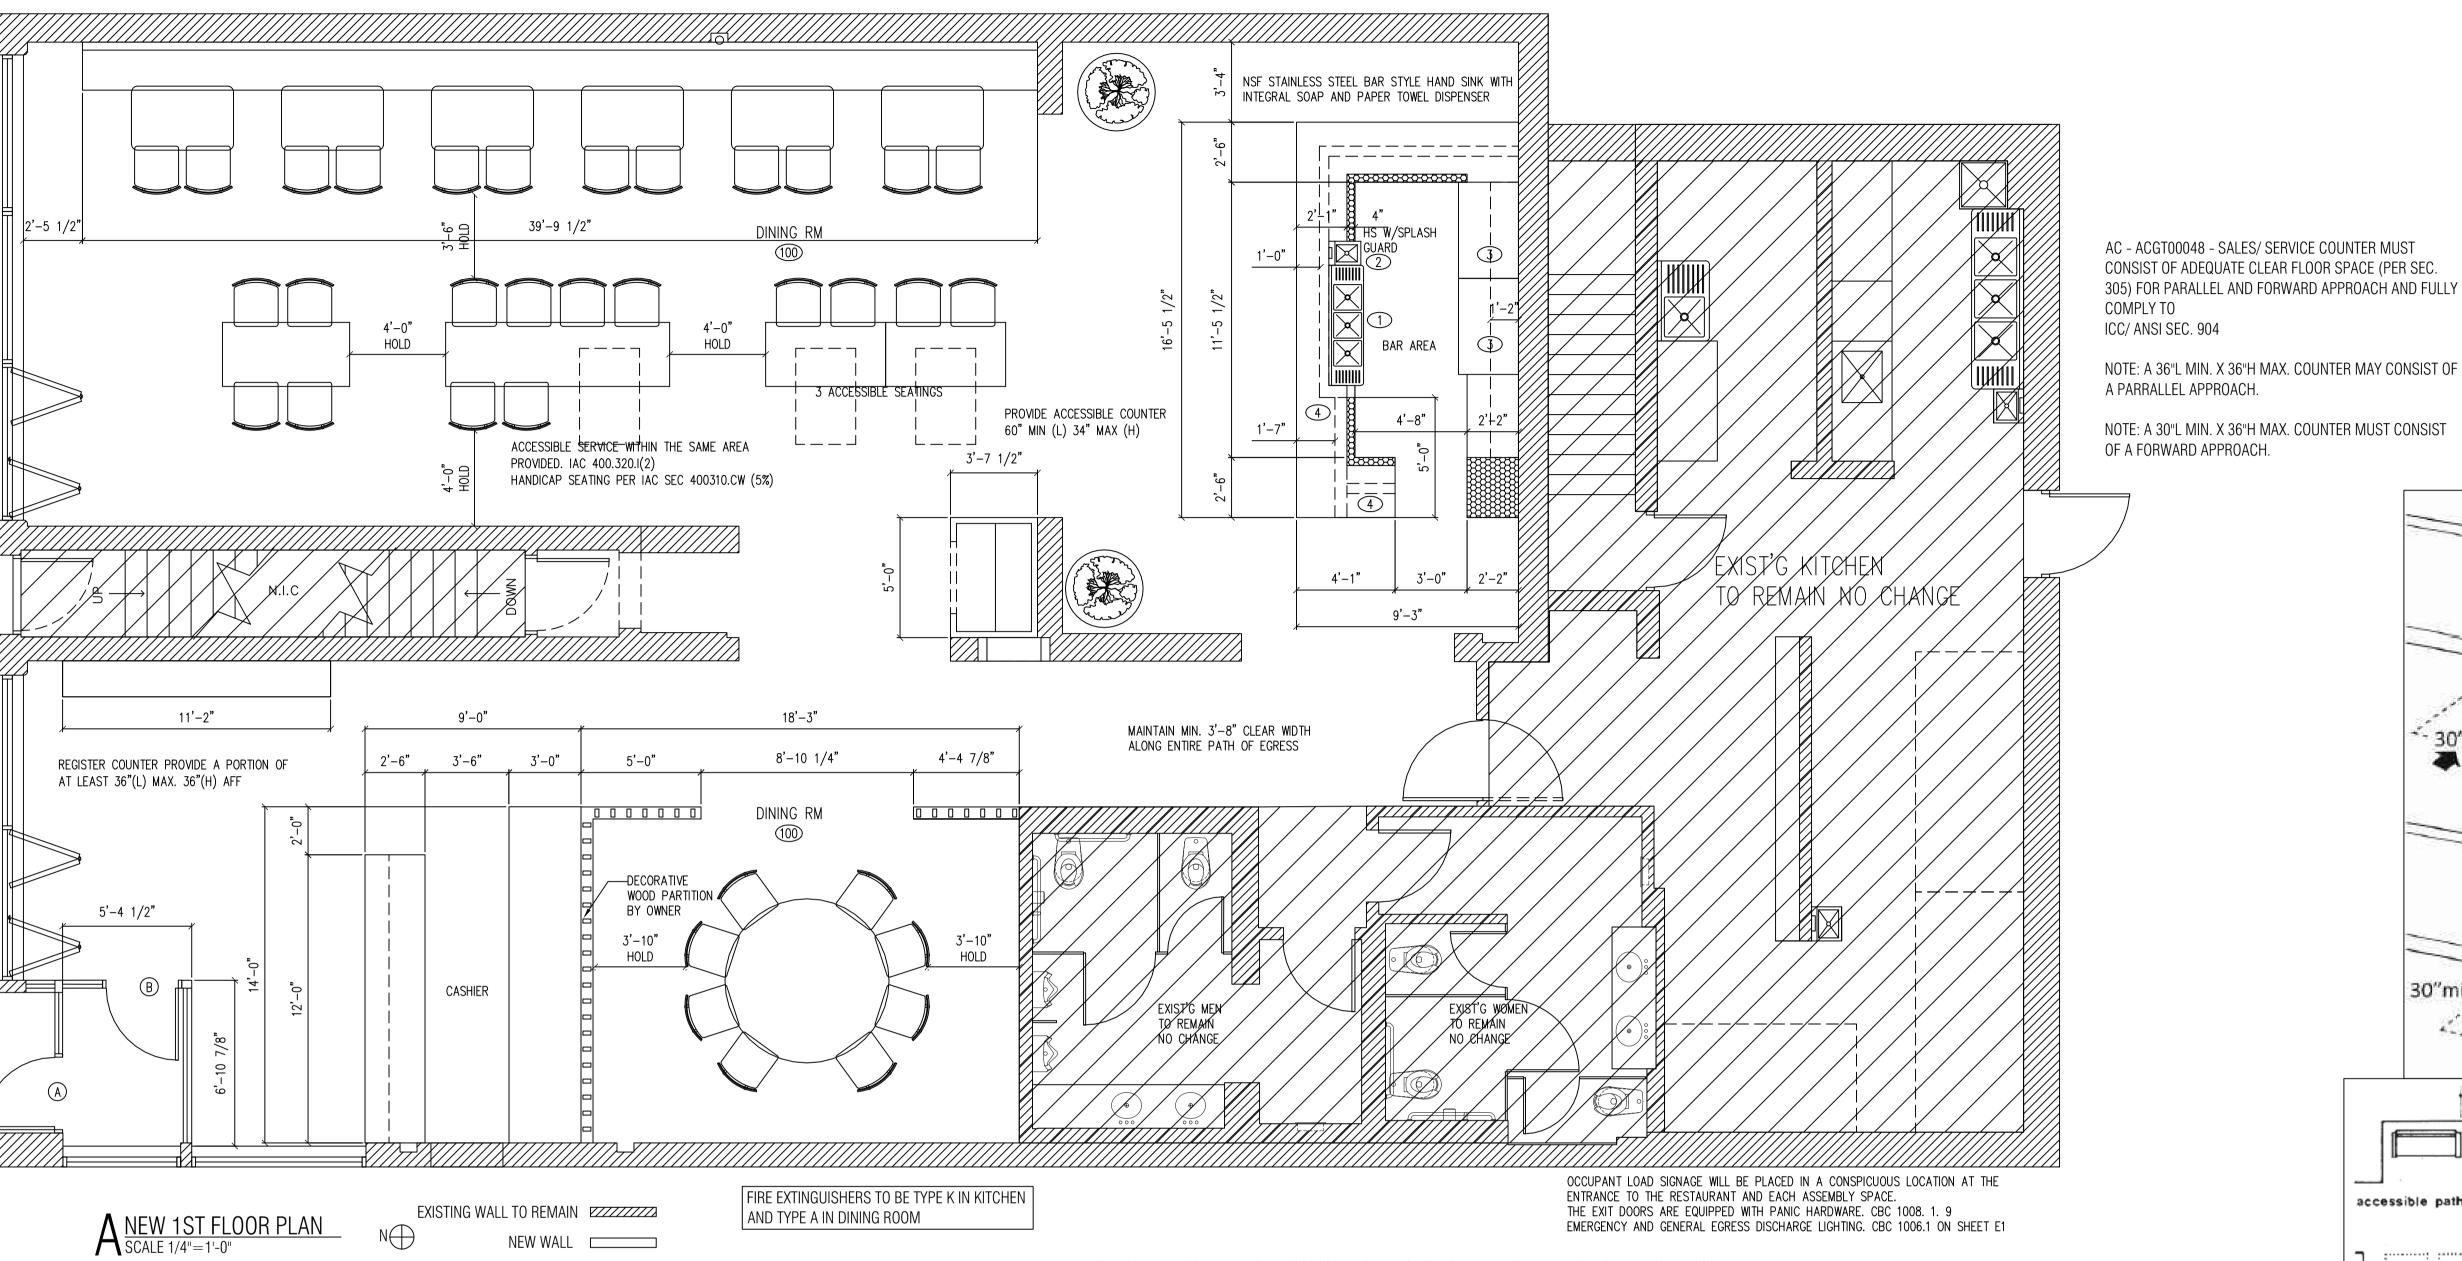

ROOM FINISH SCHEDULE NO ROOM WALLS BASE **FLOOR CEILING** FLOOR TILE 100 DINING AREA GYP. BD. PAINTE QT COVE BASE EXIST'G CLG. PAINTED 101 BAR AREA QT COVE BASE **CERAMIC TILE QUARRY TILE** EXIST'G CLG.

	EQUIPMENT SCHEDULE										
NO	QTY	DESCRIPTION	GAS	ELEC	TRIC	PLUMBING	REMARKS				
1	1	3 COMPARTMENT BAR SINK	_	=	н	1/2" CW,1/2" HW,4" INDIRECT DRAIN	NSF,W/ ECOLAB PATHWAY TO PREVENT BACKFLOW				
2	1	HAND SINK	_	-	-	1/2" CW,1/2" HW, 2" DRAIN	NSF, WALL MOUNTED - SEALED				
3	2	BAR COOLER	_	120V	4A	-	NSF,W/ CASTERS				
4	1	BAR COUNTER W/CABINETS	_	-	-	-	NSF				
ALL	EQUIPI	MENTS WILL BE NSF APPROVED CLEAN,OPER.	ABLE AND S	UBJECT TO	THE FINAL APPROVAL BY	Y THE HEALTH					

			DOOR	SCHEDULE				
TAG	DESCRIPTION	FRAME CONSTRUCTION	NOMINAL SIZE W X H	DOOR FINISH	FRAME FINISH	LABEL	HARDWARE SET	COMMENTS
Α	STORE FRONT GLASS DOOR	ALUMINUM	3'-0" x 7'-0"	TEMPERED GLASS	ALUMINUM	-	2	EXIST'G FRONT EXIT DOOR
В	TEMPERED GLASS DOOR	ALUMINUM	3'-0" x 7'-0"	TEMPERED GLASS	ALUMINUM	-1	2	EXIST'G
	* ALL EXIT DOORS MUST	OPEN WITHOUT THE USE	OF A KEY OR S	SPECIAL KNOWLED	GE FROM TH	E SIDE	WHICH EGRESS	IS MADE

\* ALL EXIT DOORS MUST OPEN WITHOUT THE USE OF A KEY OR SPECIAL KNOWLEDGE FROM THE SIDE WHICH EGRESS IS MADE \* LEVERED HANDLE HARDWARE AS REQUIRED BY ILLINOIS ACCESSIBILITY CODE

\* PROVIDE DOOR CLOSERS ALONG ALL ACCESSIBLE ROUTES

	HARDWARE SCHEDULE
TAG	DESCRIPTION
1	3 HINGES, W/LEVERED PRIVACY LOCKSET , KICKPLATE AND DOOR CLOSER
2	PADDLE LATCH EXIT DEVICE AND DOOR CLOSER, PANIC HARDWARE

**DEPARTMENT** 

3 PRIVACY LOCKET

AC - PROVIDE 5% OR AT LEAST 1 ACCESSIBLE SEATING TO INCLUDE RAISED AND/ OR LOWERED SEATING IF BEING PROVIDED; ALL RAISED AND LOWERED SEATING MUST CONSIST OF AN ACCESS ROUTE TO THE ACCESSIBLE SEATING AS WELL AND MUST FULLY COMPLY TO ICC/ ANSI CHAPTER 18-11-1109.10

NOTE: IF A BAR IS PROVIDED, A 5 FT. SECTION OF BAR MUST BE AT ACCESSIBLE HEIGHT OR PROVIDE 5% OR AT LEAST 1 ACCESSIBLE SEATING WITH WAITING SERVICES TO BE PROVIDED.

1. There must be a 36" aisle between any fixed seats Be sure to organize your booth seating or movable tables accordingly. 2. Spaces for wheelchairs at tables must be available by either leaving them open or adding movable chairs at ADA compliant tables.

3. 5% of the tables (or at least one if you have less than 20 tables) in your establishment must be ADA Compliant tables. 4. A floor area of 30" by 48" should be cleared to accommodate wheelchair seating at a table or counter. 5. Tabletops and counters should be between 28" to 34" in height to be accessible in a wheelchair.

7. If the bar exceeds 34 inches in height, a 60-inch long protion of the counter must be lowered, where it is readily achievable, to between 28 and 34 inches from the floor to the top of the bar with knee space at least 27 inches high, 30 inches wide, and 19 inches deep, for customers who use wheelchairs.

ALL CABINET SHELVES -STAINLESS STEEL.

ALL CABINET BASE - 6" STAINLESS STEEL LEGS (NO KICK BASE)

ANY PAINTED FINISHES TO BE SEMI-GLOSS OR GLOSS (NO FLAT, NO EGG SHELL, NO TEXTURE), PROVIDE FRP ON WALL SIDE AND UNDERSIDE OF BAR.

SERVED DAILY AND THE NUMBER OF DELIVERIES WEEKLY.

TO THE FLOOR FOR EASY CLEANING.

NO RAW WOOD SURFACES PERMITTED ANYWHERE. UNDERSIDES OF COUNTERTOPS, INSIDE OF CABINETRY, AND WATER HEATER PLATFORMS MUST BE SEALED.

6. Customers should have ample knee room under a table or counter that measures a minimum of 30" wide, 27" high, and


ALL NSF APPROVED HAND SINKS TO BE WITH BLADE HANDLED FAUCETS.

BEVERAGE STATION & BAR COUNTER TOP -STAINLESS STEEL

STAINLESS STEEL WALL FINISH FOR BEHIND AND ADJACENT TO COOK LINE.

ALL FOOD AND FOOD RELATED ITEMS MUST BE STORED OFF THE FLOOR ON DURABLE WASHABLE SHELVES. THE STORAGE AREA MUST BE APPROPRIATELY SIZED BASED ON THE NUMBER OF MEALS

ALL FOOD EQUIPMENT TO BE ON CASTERS, 6" LEGS, OR SEALED

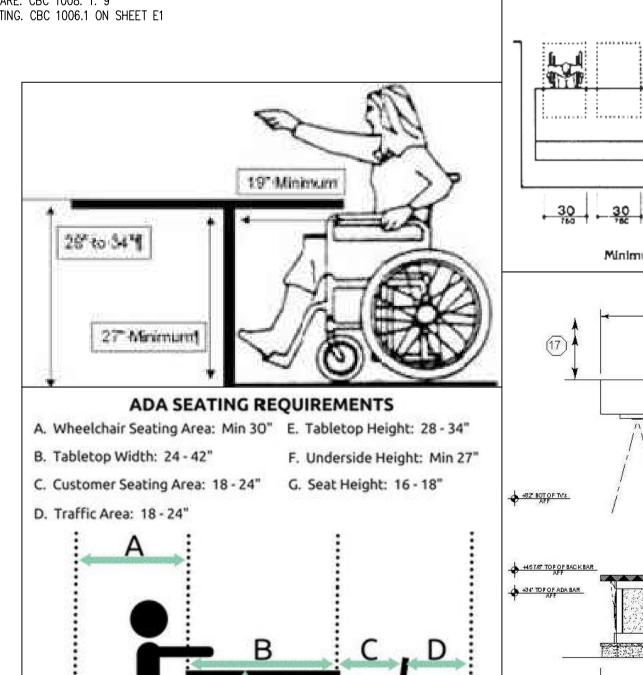

30"min,

accessible path of travel

48"min


Minimum Clearances for Seating and Tables


172 7/8"


ADA SEATING 172 7/8"

**ELEVATION** 

SCALE: 3/8" = 1" 0"

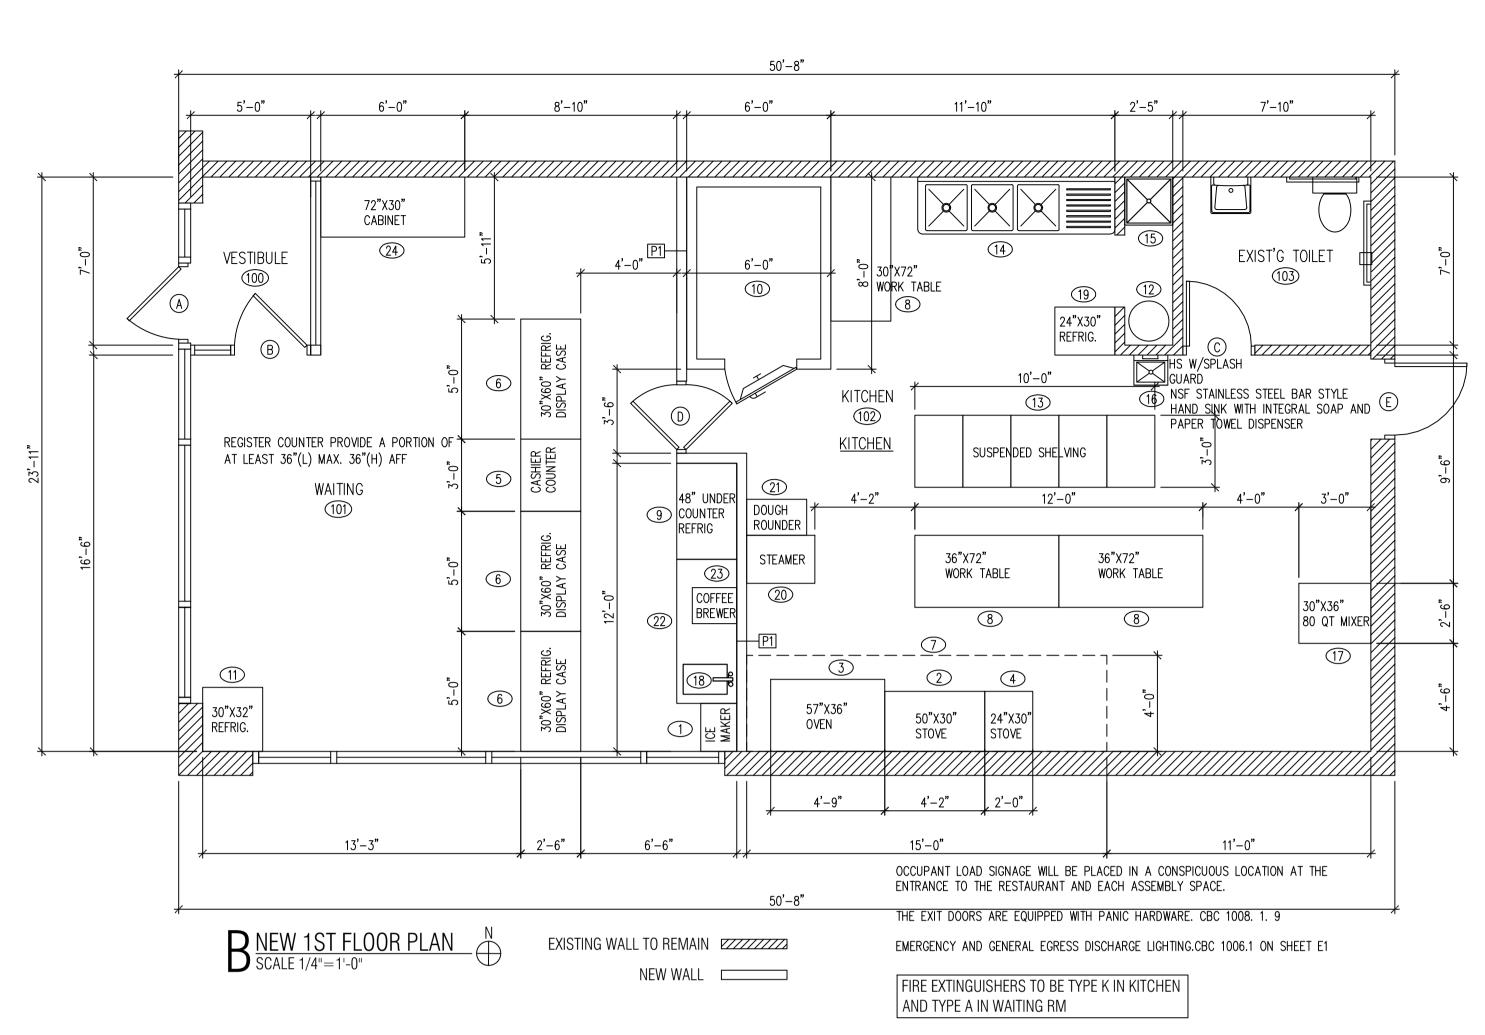

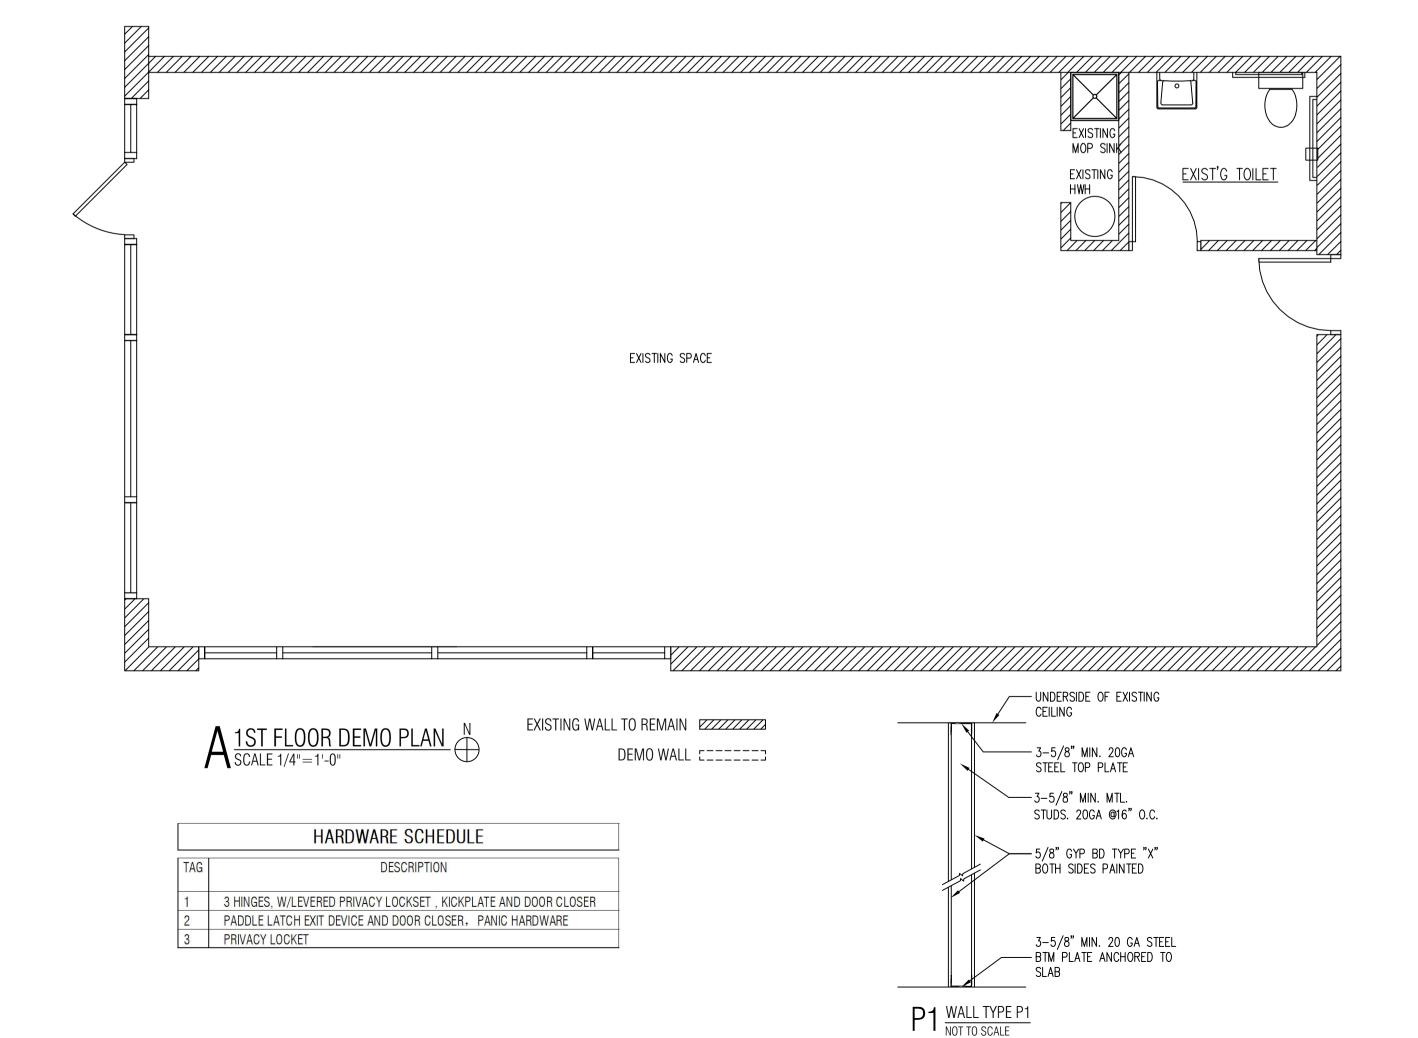

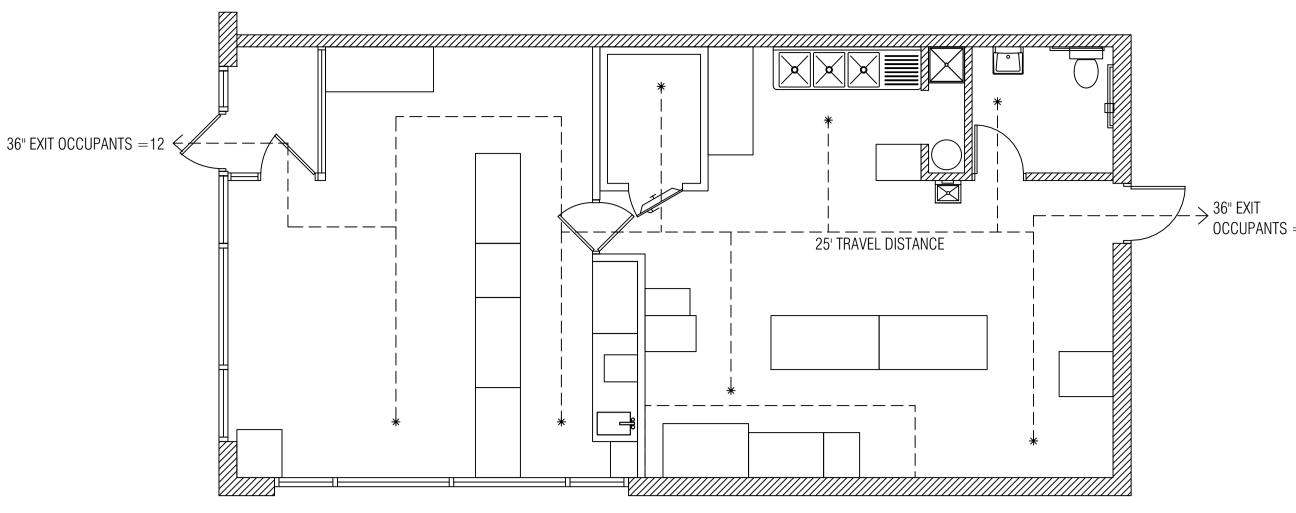

#### OCCUPANCY & EXITING DIAGRAM $\mathbf{SCALE} \ 3/16" = 1'-0"$

					EQUIPMENT SCH	IEDULE	
NO	QTY	DESCRIPTION	GAS	ELEC	CTRIC	PLUMBING	REMARKS
1	1	ICE MAKER	-	120V	5A	3/8" CW	NSF,AIR COOLED CONDENSING UNIT
2	1	50"X30" STOVE	3/4"	_	_	-	NSF, 110000 BTU
3	1	OVEN	-	240V	48A	_	NSF
4	1	24"X30" STOVE	3/4"	1-	-	-	NSF, 40000 BTU
5	1	CASH COUNTER	-	-	-		NSF
6	3	30X60 REFRIG. DISPLAY CASE	_	120V	6A	_	NSF
7	1	15'X4' EXHAUST HOOD, TYPE I	-	1-	-	-	U.L. W/ANSUL FIRE SUPPRESSION SYSTEM
8	3	WORK TABLE	_	-	-	_	NSF,W/ 6" STAINLESS STEEL LEGS NSF APPROVED
9	2	48" UNDER COUNTER REFRIG	-	120V	3A	-	NSF
10	1	6'X8' WALK-IN COOLER	-	240V	15A	_	NSF
11	1	30"X32" REFRIG.	-	120V	4A	_	NSF
12	1	HOT WATER HEATER	3/4"	120V	-	3/4" CW & 3/4" HW	NSF, 50GALLONS
13	1	SHELVING	_	1-	_	_	NSF APPROVED STAINLESS STEEL SHELVING
14	1	3 COMPARTMENT SINK	-	-	-	1/2" CW,1/2" HW,4" INDIRECT DRAIN	NSF,W/ ECOLAB PATHWAY TO PREVENT BACKFLOW
15	1	EXIST'G MOP SINK/A FLOOR BASIN UNIT	-	1-		1/2"CW,1/2" HW, 4" DRAIN	NSF, W/ MOP HOOKS, SEAL EDGES
16	1	HAND SINK	-	-	-	1/2" CW,1/2" HW, 2" DRAIN	NSF, WALL MOUNTED - SEALED
17	1	80 QT MIXER	_	240V	7A	_	NSF
18	1	PREP SINK	-	-	_	1/2"CW,1/2" HW, 4" INDIRECT DRAIN	NSF
19	1	24"X30" REFRIG.	_	120V	2.5A	_	NSF,W/ CASTERS
20	1	STEAMER	-	240V	6A	1/2" HW, 4" INDIRECT DRAIN	NSF
21	1	DOUGH ROUNDER	-	120V	-	-	NSF
22	1	STAINLESS STEEL COUNTER	-		-	_	NSF
23	1	COFFEE BREWER	_	120V	2A	-	NSF
24	1	72"X30" CABINET	:=:	1-	_	-	NSF

ALL EQUIPMENTS WILL BE NSF APPROVED CLEAN, OPERABLE AND SUBJECT TO THE FINAL APPROVAL BY THE HEALTH

**DEPARTMENT** 

	ROOM FINISH SCHEDULE										
NO	ROOM	WALLS	BASE	FLOOR	CEILING						
1	WAITING AREA	GYP. BD. PAINTED	QT COVE BASE	FLOOR TILE	OPEN CEILING						
2	KITCHEN	STAINLESS STEEL	QT COVE BASE	QUARRY TILE	2'X4' VINYL TILE CLG.						
3	SERVICE AREA	CERAMIC TILE	QT COVE BASE	QUARRY TILE	OPEN CEILING						
4	EXISTING TOILET	EXISTING	EXISTING	FLOOR TILE	EXIST'G CLG. PAINTED						
5	VESTIBULE	GYP. BD. PAINTED	QT COVE BASE	FLOOR TILE	OPEN CEILING						

				D	00R	SCHEDULE				
TAG	DESCRIPTION	FRAME CONSTRUCTION	NOMINA	AL SI	ZE	DOOR FINISH	FRAME FINISH	LABEL	HARDWARE SET	COMMENTS
			WXH							
Α	STORE FRONT GLASS DOOR	ALUMINUM	3'-0"	X	7'-0"	TEMPERED GLASS	ALUMINUM	-	2	EXIST'G FRONT EXIT DOOR
В	TEMPERED GLASS DOOR	ALUMINUM	3'-0"	X	7'-0"	TEMPERED GLASS	ALUMINUM	-	2	NEW
C	HOLLOW METAL DOOR	HOLLOW METAL	3'-0"	X	6'-8"	PAINT	PAINT	-	1	EXIST'G
D	ALUMINUM	ALUMINUM	3'-6"	X	6'-8"	PAINT	PAINT	-1	DOUBLE ACTION	NEW
Е	HOLLOW METAL DOOR	HOLLOW METAL	3'-0"	X	6'-8"	PAINT	PAINT	-	2	EXIST'G
,	* ALL EXIT DOORS MUST	OPEN WITHOUT THE US	E OF A	KE)	ORS	SPECIAL KNOWLED	GE FROM TH	E SIDE	WHICH EGRESS	IS MADE
	* LEVERED HANDLE HARD	OWARE AS REQUIRED BY	Y II I INC	OIS.	ACCES	SSIBILITY CODE				

\* LEVERED HANDLE HARDWARE AS REQUIRED BY ILLINOIS ACCESSIBILITY CODE \* PROVIDE DOOR CLOSERS ALONG ALL ACCESSIBLE ROUTES

COOKLINE EQUIPMENT AND REACH-IN REFRIGERATION AND FREEZER UNITS TO BE INSTALLED ON CASTERS. NSF STAINLESS STEEL SHELF OVER 3-COMPTMENT SINK. ICE MAKER A MIN. 8" FROM ALL WALLS. HEAVY-DUTY MOP RACKS LOCATED OVER MOP SINK. HEAVY-DUTY BROOM RACKS IN JANITORIAL AREA. METAL GARBAGE CANS WITH LIDS FOR RESTROOMS. SANITARY BOX IN WOMEN'S RESTROOMS. METAL GARBAGE CANS WITH LIDS FOR DIAPER CHANGING STATION.

ALL NSF APPROVED HAND SINKS TO BE WITH BLADE HANDLED FAUCETS. WAITRESS, BEVERAGE STATION & BAR COUNTER TOP -STAINLESS STEEL. ALL CABINET SHELVES -STAINLESS STEEL. ALL CABINET BASE - 6" STAINLESS STEEL LEGS (NO KICK BASE) LAVATORY COUNTERTOP TO BE SOLID SURFACE (NO PLASTIC LAMINATE OR CABINETRY) ANY PAINTED FINISHES TO BE SEMI-GLOSS OR GLOSS (NO FLAT, NO EGG SHELL, NO TEXTURE), PROVIDE FRP ON WALL AND UNDERSIDE OF BAR. STAINLESS STEEL WALL FINISH FOR BEHIND AND ADJACENT TO COOK LINE

#### KITCHEN EQUIPMENT NOTES

CONTRACTOR SHALL INSTALL AND CONNECT ALL EQUIPMENT AS PER EQUIPMENT SUPPLIER'S SPECIFICATIONS. ALL LOCATIONS TO BE VERIFIED WITH OWNER PRIOR TO INSTALLATION.

PLUMBING CONTRACTOR SHALL PROVIDE ALL ROUGH-INS. INSULATE ALL COLD/HOT WATER PIPES AS REQUIRED. MAINTAIN MIN 36" IN FRONT OF ALL COOKING EQUIPMENT.

ELECTRICAL CONTRACTOR SHALL PROVIDE ALL ELECTRICAL OUTLETS FOR EQUIPMENT. VERIFY ALL ELECTRICAL REQUIREMENTS WITH EQUIPMENT SUPPLIER. VERIFY ALL GAS AND WATER REQUIREMENTS WITH EQUIPMENT SUPPLIER.

ALL PERMANENT EQUIPMENT MUST BE LOCATED SO THAT AREAS BEHIND. UNDERNEATH, AND ON THE SIDES OF THE EQUIPMENT CAN BE EASILY CLEANED.

TWO DRAIN BOARDS ARE REQUIRED AT ALL THREE-COMPARTMENT SINKS ALONG WITH AN APPROPRIATELY SIZED FAUCET, LOCKABLE DRAIN PLUGS, AND AN INDIRECT CONNECTION TO THE SEWER.

#### DRY STORAGE

DRY STORAGE: 25% OF 600SF (KITCHEN AREA.)=150SF REQ'D ACTUAL DRY STORAGE 160SF PROVIDED.

5 SHELVINGS X 4X4X2 = 160 SF

ALL FOOD AND FOOD RELATED ITEMS MUST BE STORED OFF THE FLOOR ON DURABLE WASHABLE SHELVES. THE STORAGE AREA MUST BE APPROPRIATELY SIZED BASED ON THE NUMBER OF MEALS SERVED DAILY AND THE NUMBER OF DELIVERIES WEEKLY.

ALL FOOD EQUIPMENT TO BE ON CASTERS, 6" LEGS, OR SEALED TO THE FLOOR FOR EASY CLEANING.

NO RAW WOOD SURFACES PERMITTED ANYWHERE. UNDERSIDES OF COUNTERTOPS, INSIDE OF CABINETRY, AND WATER HEATER PLATFORMS MUST BE SEALED.

• Dial stem thermometers (ranging from 0° to 220°F) are required in all preparation areas.

- Chemical test kits (specific to the sanitizer) are required for the appropriate sanitizer.
- pH meter and log for acidifying rice.
- All cooling/freezing units must have accurate thermometers.
- Covered waste cans are required in all restrooms.
- Toilets, urinals, hand sinks, 3 compartment sinks, mop sink, prep sinks, and permanent counters/cabinets must be sealed to floors and walls with a silicone caulk seal.
- Anti-siphon devices are required on all toilet tanks, urinals, and faucets with hose
- Soap and paper towels are required at all hand sinks.
- Provide hair restraints and disposable gloves for all food handlers.
- If sinks are provided with spring-loaded faucets, the faucets must remain running for a minimum

Doors leading to the outside and restroom doors are required to be self-closing and tight-fitting. Please confirm that the doors leading to the outside are equipped with a self-closer and weather strips to eliminate any air gaps.

TW ARCHITECT INC 2425 S WENTWORTH AVE CHICAGO IL 60616

Phone: (312) 912-5798 Email: twarchitect98@yahoo.com

DEPARTMENT OF BUILDINGS STANDARD PLAN REVIEW CONDITIONAL

PERMIT

Construction subject to full mpliance with the Municipal Code of Chicago and field inspection Building Commissioner

Vand anderson

SELF CERTIFICATION


LICENSE NO: 001-022013 EXPIRES: 11/30/2022

SSUED FOR PERMIT REISSUED FOR PERMIT 08/06/2021




FLOOR PLANS & NOTES



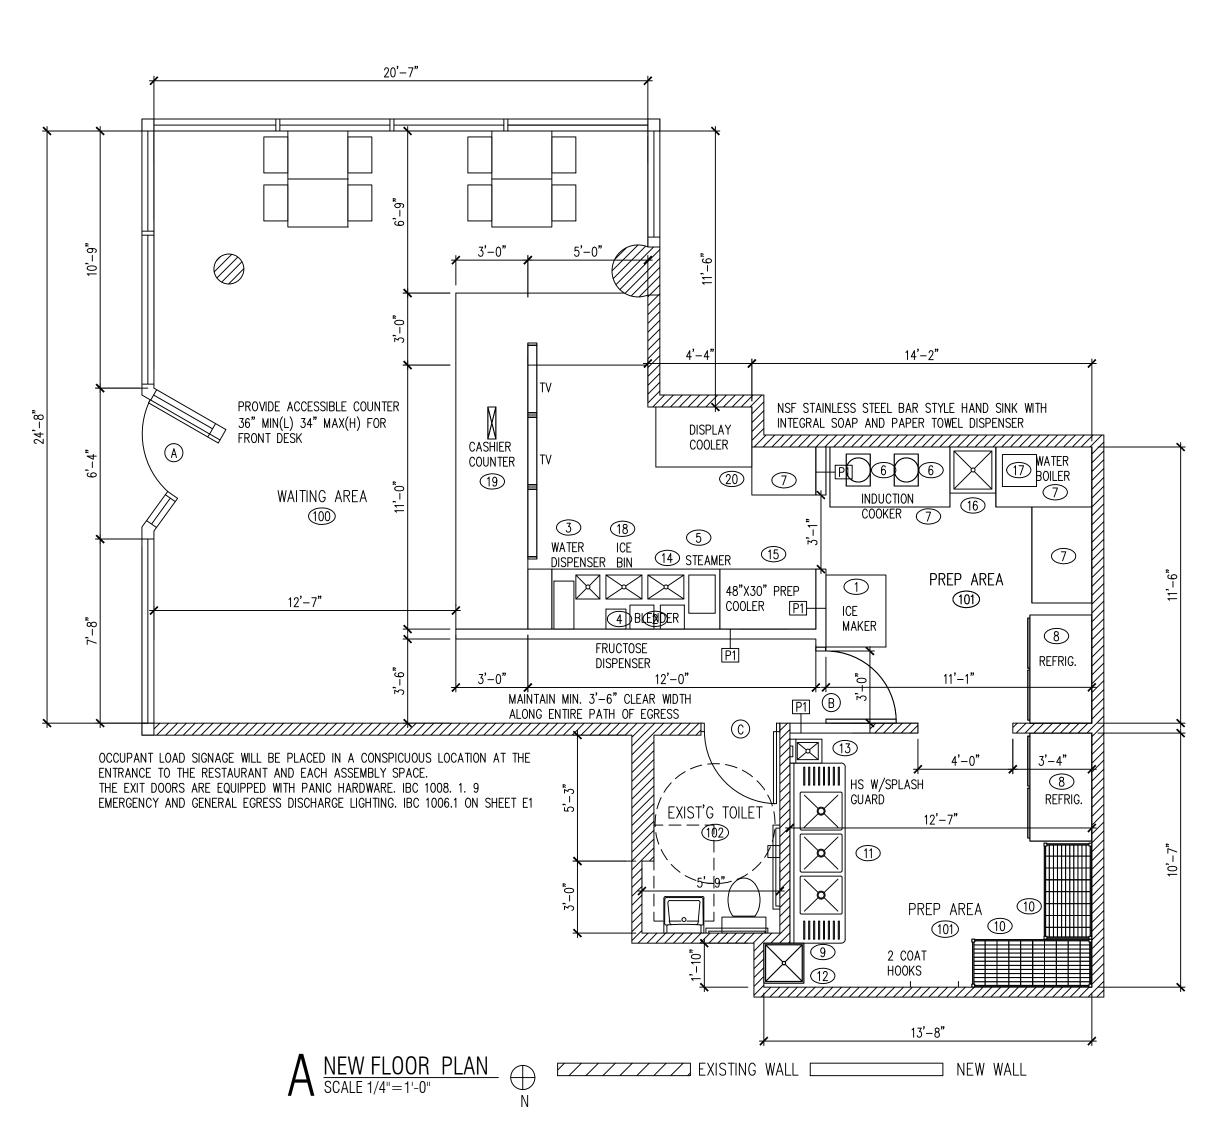

				E	QUIPMENT S	CHEDULE		
NO	QTY	DESCRIPTION	GAS	ELECTR	IIC	PLUMBING	REMARKS	
1	1	ICE MAKER	-	220V	10A	1/2"CW,4" OSD DRAIN	NSF,AIR COOLED CONDENSING UNIT	
2	1	BLENDER	-	120V	-		NSF	
3	1	WATER DISPENSER	_	120V	_	-	NSF	
4	1	FRUCTOSE DISPENSER	_	120V	-	-	NSF	
5	1	STEAMER	-	220V	2700W	1/2"CW,4" OSD DRAIN	NSF	
6	2	INDUCTION COOKER	-	120V	1800W	-	NSF	
7	3	STAINLESS STEEL WORK TABLE	=	1=	=	=	NSF	
8	2	REFRIGERATOR	_	120V	3A	-	NSF	
9	1	TANKLESS HWH	-	240V	40A	3/4" CW & 3/4" HW	NSF	
10	2	SHELVING	-	-	_	-	NSF APPROVED STAINLESS STEEL SHELVING	
11	1	3 COMPARTMENT SINK	-	-	-	1/2" CW,1/2" HW,4" INDIRECT DRAIN	NSF,W/ ECOLAB PATHWAY TO PREVENT BACKFLOW	
12	1	MOP SINK	_	-		1/2"CW,1/2" HW, 4" DRAIN	NSF, W/ MOP HOOKS, SEAL EDGES	
13	1	HAND SINK	-	-	_	1/2" CW,1/2" HW, 2" DRAIN	NSF, WALL MOUNTED - SEALED	
14	1	STAINLESS STEEL CABINET TABLE	-	-	-	1/2" CW,1/2" HW,4" INDIRECT DRAIN	NSF,W/ ECOLAB PATHWAY TO PREVENT BACKFLOW	
15	1	PREP COOLER	_	120V	3A	-	NSF,W/ CASTERS	
16	1	PREP SINK	-	-	-	1/2"CW,1/2" HW, 4" INDIRECT DRAIN	NSF,W/ ECOLAB PATHWAY TO PREVENT BACKFLOW	
17	1	WATER BOILER	_	220V	30A	1/2"CW, 4" INDIRECT DRAIN	NSF	
18	1	ICE BIN	-	1-	-	4" INDIRECT DRAIN	NSF	
19	1	SERVICE/CASHIER COUNTER	-	-	-	-	NSF	
20	1	DISPLAY COOLER	_	120V	3A	-	NSF	

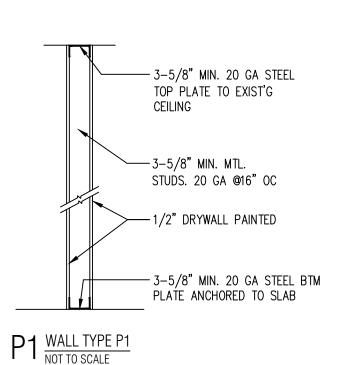

## PREP EQUIPMENT NOTES


CONTRACTOR SHALL INSTALL AND CONNECT ALL EQUIPMENT AS PER EQUIPMENT SUPPLIER'S SPECIFICATIONS. ALL LOCATIONS TO BE VERIFIED WITH OWNER PRIOR TO INSTALLATION.

PLUMBING CONTRACTOR SHALL PROVIDE ALL ROUGH-INS. INSULATE ALL COLD/HOT WATER PIPES AS REQUIRED. MAINTAIN MIN 36" IN FRONT OF ALL COOKING EQUIPMENT.

ELECTRICAL CONTRACTOR SHALL PROVIDE ALL ELECTRICAL OUTLETS FOR EQUIPMENT. VERIFY ALL ELECTRICAL REQUIREMENTS WITH EQUIPMENT SUPPLIER. VERIFY ALL GAS AND WATER REQUIREMENTS WITH EQUIPMENT SUPPLIER.

ALL PERMANENT EQUIPMENT MUST BE LOCATED SO THAT AREAS BEHIND, UNDERNEATH, AND ON THE SIDES OF THE EQUIPMENT CAN BE EASILY CLEANED.

TWO DRAIN BOARDS ARE REQUIRED AT ALL THREE-COMPARTMENT SINKS ALONG WITH AN APPROPRIATELY SIZED FAUCET, LOCKABLE DRAIN PLUGS, AND AN INDIRECT CONNECTION TO THE SEWER.

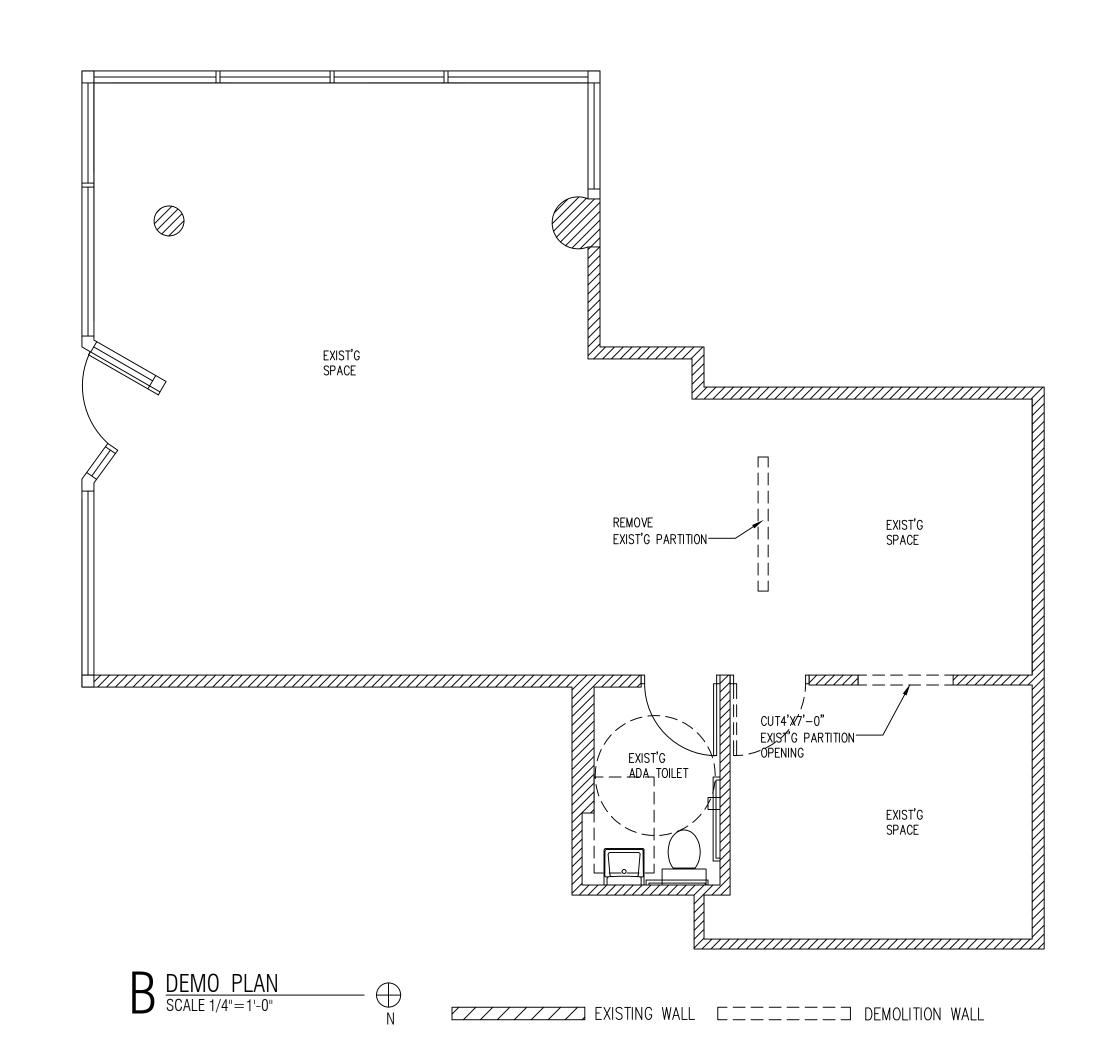

	HARDWARE SCHEDULE									
TAG	DESCRIPTION									
1	1 1/2 PAIR BUTT HINGES, W/ SELF CLOSING DEVICE									
2	1 1/2 PAIR BUTT HINGES, SELF CLOSING DEVICE, ACCESSIBLE HARDWARE									
3	1 1/2 PAIR BUTT HINGES, PADDLE LATCH EXIT DEVICE AND DOOR CLOSER, PANIC HARDWARE									

	ROOM FINISH SCHEDULE											
NO	ROOM	WALLS	BASE	FLOOR	CEILING							
100	WAITING AREA	GYP. BD. PAINTED	QT COVE BASE	FLOOR TILE	EXIST'G CEILING							
101	PREP AREA	FRP	QT COVE BASE	QUARRY TILE	VINYL CEILING							
102	EXIST'G TOILET	EXIST'G	EXIST'G	FLOOR TILE	EXIST'G GYP BD PAINTED							

	DOOR SCHEDULE										
TAG	DESCRIPTION	FRAME CONSTRUCTION	NOMINA	AL SI	ZE	DOOR FINISH	FRAME FINISH	LABEL	HARDWARE	COMMENTS	
			WXH								
Α	STORE FRONT GLASS DOOR	ALUMINUM	3'-0"	Χ	7'-0"	TEMPERED GLASS	ALUMINUM	-	3	EXIST'G	
В	WOOD DOOR	PRE-HUNG METAL	3'-0"	X	7'-0"	PAINT	PAINT	-	1	NEW	
C	HOLLOW METAL DOOR	PRE-HUNG METAL	3'-0"	X	6'-8"	PAINT	PAINT	-	2	EXIST'G	
	ALL EXIT DOORS MUST	OPEN WITHOUT TH	E USE	OF	A KEY	OR SPECIAL KNO	WLEDGE FRO	M THE	SIDE WHI	CH EGRESS IS MADE	
	LEVERED HANDLE HARDWARE AS REQUIRED BY ILLINOIS ACCESSIBILITY CODE										
	PROVIDE DOOR CLOSE	ERS ALONG ALL ACC	ESSIBI	EF	ROUTE	S					

#### DRY STORAGE

DRY STORAGE : 25% OF 267 SF (KITCHEN AREA.) = 67SF REQ'D ACTUAL DRY STORAGE 1X4X4X2+1x5X4X2=72SF PROVIDED.

ALL FOOD AND FOOD RELATED ITEMS MUST BE STORED OFF THE FLOOR ON DURABLE WASHABLE SHELVES. THE STORAGE AREA MUST BE APPROPRIATELY SIZED BASED ON THE NUMBER OF MEALS SERVED DAILY AND THE NUMBER OF DELIVERIES WEEKLY.

ALL FOOD EQUIPMENT TO BE ON CASTERS, 6" LEGS, OR SEALED TO THE FLOOR FOR EASY CLEANING.

NO RAW WOOD SURFACES PERMITTED ANYWHERE. UNDERSIDES OF COUNTERTOPS, INSIDE OF CABINETRY, AND WATER HEATER PLATFORMS MUST BE SEALED.

- Dial stem thermometers (ranging from 0° to 220°F) are required in all preparation areas.
- Chemical test kits (specific to the sanitizer) are required for the appropriate sanitizer.
- pH meter and log for acidifying rice.

strips to eliminate any air gaps.

- All cooling/freezing units must have accurate thermometers.
- Covered waste cans are required in all restrooms.
- Toilets, urinals, hand sinks, 3 compartment sinks, mop sink, prep sinks, and permanent counters/cabinets must be sealed to floors and walls with a silicone caulk seal.
- Anti-siphon devices are required on all toilet tanks, urinals, and faucets with hose connections.
- Soap and paper towels are required at all hand sinks.
- Provide hair restraints and disposable gloves for all food handlers.
- of 15 seconds

  Doors leading to the outside and restroom doors are required to be self-closing and tight-fitting.

  Please confirm that the doors leading to the outside are equipped with a self-closer and weather

If sinks are provided with spring-loaded faucets, the faucets must remain running for a minimum

PROVIDE THE FOLLOWING: NSF STAINLESS STEEL OPEN WIRE SHELVING UNITS.

NSF STAINLESS STEEL SHELF OVER 3-COMPTMENT SINK. ICE MAKER A MIN. 8" FROM ALL WALLS.

HEAVY-DUTY MOP RACKS LOCATED OVER MOP SINK.

HEAVY-DUTY BROOM RACKS IN JANITORIAL AREA. METAL GARBAGE CANS WITH LIDS FOR RESTROOMS.
SANITARY BOX IN RESTROOM. METAL GARBAGE CANS WITH LIDS FOR DIAPER CHANGING STATION.

ALL NSF APPROVED HAND SINKS TO BE WITH BLADE HANDLED FAUCETS.
BEVERAGE STATION & SERVICE COUNTER TOP -STAINLESS STEEL & QUARTZ.

ALL CABINET SHELVES -STAINLESS STEEL.
ALL CABINET BASE - 6" STAINLESS STEEL LEGS (NO KICK BASE)
LAVATORY COUNTERTOP TO BE SOLID SURFACE (NO PLASTIC LAMINATE OR CABINETRY)
ANY PAINTED FINISHES TO BE SEMI-GLOSS OR GLOSS (NO FLAT, NO EGG SHELL,NO TEXTURE),

FIRE EXTINGUISHERS TO BE TYPE K IN PREP AREA AND TYPE A IN DINING ROOM

PROVIDE TILE ON WALL AND UNDERSIDE OF SERVICE AREA.

WEI TAN 2425 S WENTWORTH AVE CHICAGO IL 60616

Phone: (312) 912-5798 Email: twarchitect98@yahoo.com

LICENSE NO: 001-022013 EXPIRES: 11/30/2022

MEP ENGINEER 236 W ALEXANDER STREET CHICAGO IL 60616

PHONE: (312)720-8800
BILLY\_WANG68@HOTMAIL.COM
LICENSE NO: 062.068227
EXPIRES: 11 / 30 /2023


VTERIOR REMODELING

SSUES DATE
SSUED FOR PERMIT 12/18/2021



FLOOR PLAN, NOTES, & SCHEDULES



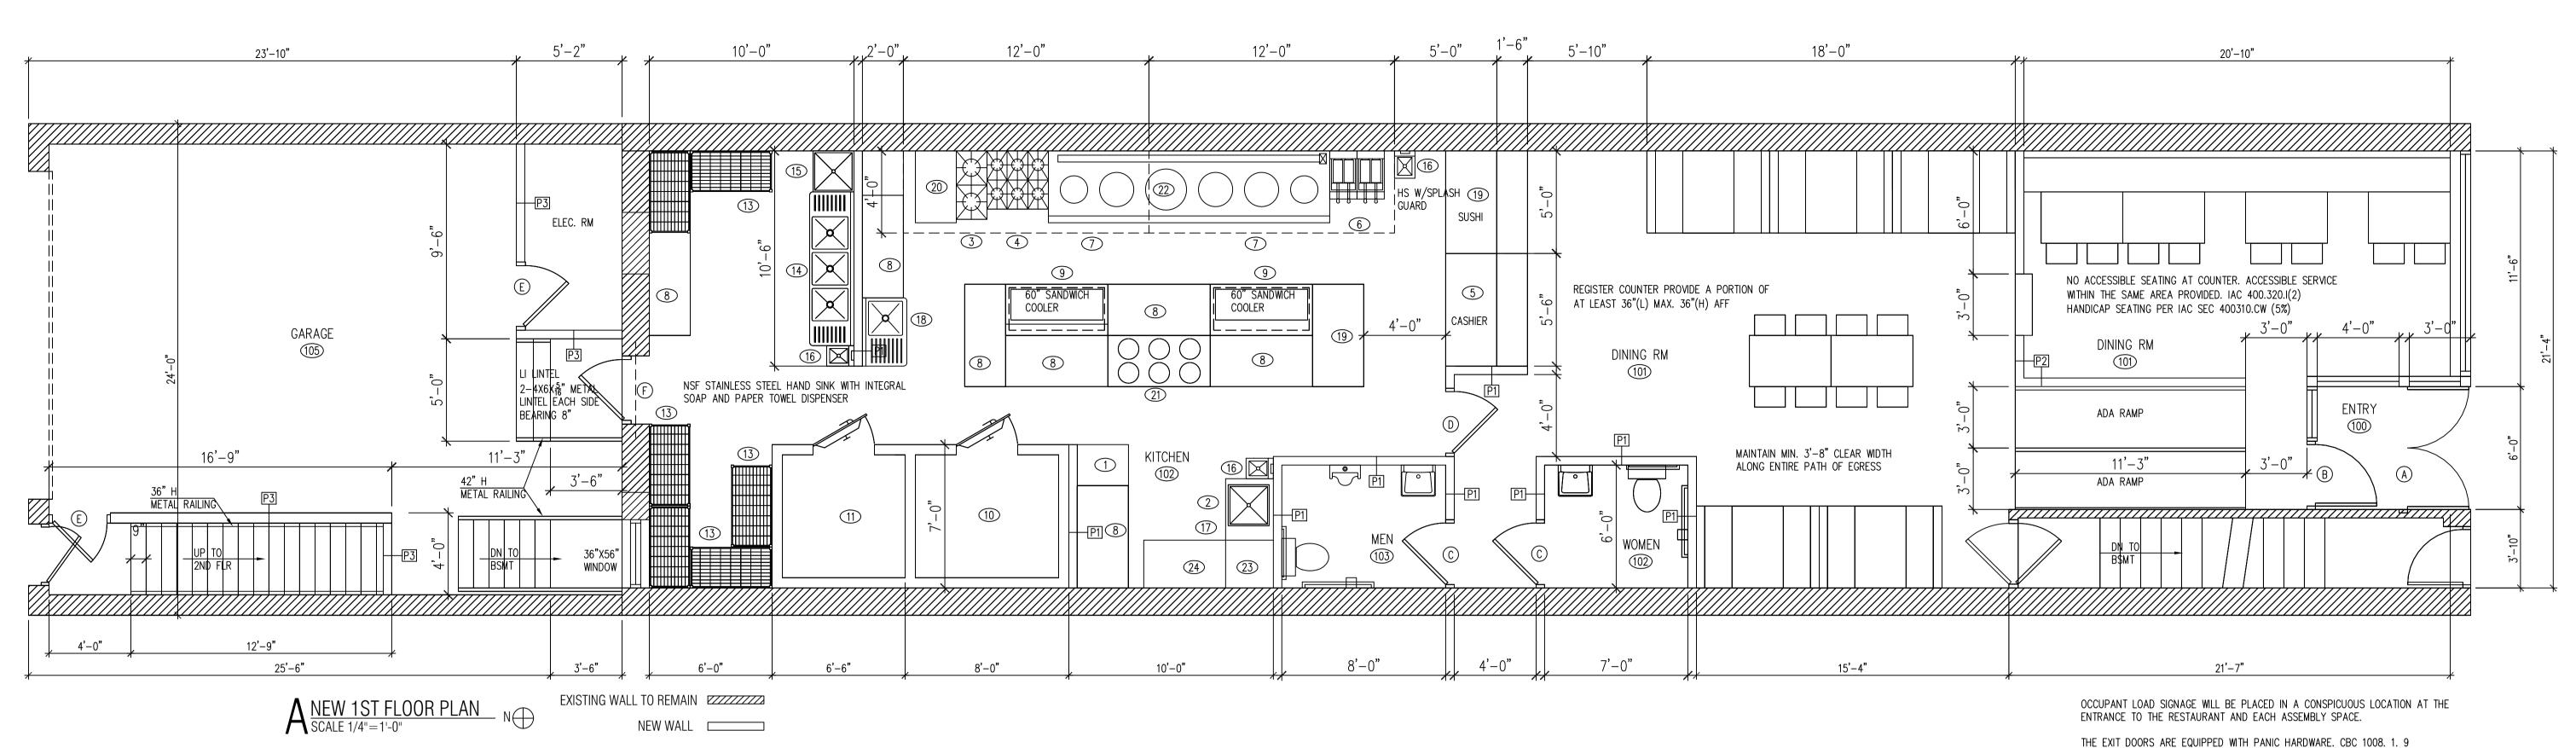

#### KITCHEN EQUIPMENT NOTES

CONTRACTOR SHALL INSTALL AND CONNECT ALL EQUIPMENT AS PER EQUIPMENT SUPPLIER'S SPECIFICATIONS. ALL LOCATIONS TO BE VERIFIED WITH OWNER PRIOR TO INSTALLATION.

PLUMBING CONTRACTOR SHALL PROVIDE ALL ROUGH-INS. INSULATE ALL COLD/HOT WATER PIPES AS REQUIRED. MAINTAIN MIN 36" IN FRONT OF ALL COOKING EQUIPMENT.

ELECTRICAL CONTRACTOR SHALL PROVIDE ALL ELECTRICAL OUTLETS FOR EQUIPMENT. VERIFY ALL ELECTRICAL REQUIREMENTS WITH EQUIPMENT SUPPLIER. VERIFY ALL GAS AND WATER REQUIREMENTS WITH EQUIPMENT SUPPLIER.

ALL PERMANENT EQUIPMENT MUST BE LOCATED SO THAT AREAS BEHIND, UNDERNEATH, AND ON THE SIDES OF THE EQUIPMENT CAN BE EASILY CLEANED.

TWO DRAIN BOARDS ARE REQUIRED AT ALL THREE-COMPARTMENT SINKS ALONG WITH AN APPROPRIATELY SIZED FAUCET, LOCKABLE DRAIN PLUGS, AND AN INDIRECT CONNECTION TO THE SEWER.

#### DRY STORAGE

DRY STORAGE: 25% OF 700SF (KITCHEN AREA.) = 175SF REQ'D ACTUAL DRY STORAGE 160SF PROVIDED. 6 SHELVINGS X 4X4X2 = 192 SF

ALL FOOD AND FOOD RELATED ITEMS MUST BE STORED OFF THE FLOOR ON DURABLE WASHABLE SHELVES. THE STORAGE AREA MUST BE APPROPRIATELY SIZED BASED ON THE NUMBER OF MEALS SERVED DAILY AND THE NUMBER OF DELIVERIES WEEKLY.

ALL FOOD EQUIPMENT TO BE ON CASTERS, 6" LEGS, OR SEALED TO THE FLOOR FOR EASY CLEANING.

NO RAW WOOD SURFACES PERMITTED ANYWHERE. UNDERSIDES OF COUNTERTOPS, INSIDE OF CABINETRY, AND WATER HEATER PLATFORMS MUST BE SEALED.

- Dial stem thermometers (ranging from 0° to 220°F) are required in all preparation areas.
- Chemical test kits (specific to the sanitizer) are required for the appropriate sanitizer.
- pH meter and log for acidifying rice.
- All cooling/freezing units must have accurate thermometers.
- Covered waste cans are required in all restrooms.
- Toilets, urinals, hand sinks, 3 compartment sinks, mop sink, prep sinks, and permanent counters/cabinets must be sealed to floors and walls with a silicone caulk seal.
- Anti-siphon devices are required on all toilet tanks, urinals, and faucets with hose connections.
- Soap and paper towels are required at all hand sinks.
- Provide hair restraints and disposable gloves for all food handlers.
- If sinks are provided with spring-loaded faucets, the faucets must remain running for a minimum of 15 seconds

Doors leading to the outside and restroom doors are required to be self-closing and tight-fitting. Please confirm that the doors leading to the outside are equipped with a self-closer and weather strips to eliminate any air gaps.

COOKLINE EQUIPMENT AND REACH-IN REFRIGERATION AND FREEZER UNITS TO BE INSTALLED ON CASTERS. NSF STAINLESS STEEL SHELF OVER 3-COMPTMENT SINK. ICE MAKER A MIN. 8" FROM ALL WALLS. HEAVY-DUTY MOP RACKS LOCATED OVER MOP SINK. HEAVY-DUTY BROOM RACKS IN JANITORIAL AREA. METAL GARBAGE CANS WITH LIDS FOR RESTROOMS. SANITARY BOX IN WOMEN'S RESTROOMS. METAL GARBAGE CANS WITH LIDS FOR DIAPER CHANGING STATION.

ALL NSF APPROVED HAND SINKS TO BE WITH BLADE HANDLED FAUCETS.

WAITRESS.BEVERAGE STATION & BAR COUNTER TOP -STAINLESS STEEL

ALL CABINET SHELVES -STAINLESS STEEL.

ALL CABINET BASE - 6" STAINLESS STEEL LEGS (NO KICK BASE)

3'-0"

LAVATORY COUNTERTOP TO BE SOLID SURFACE (NO PLASTIC LAMINATE OR CABINETRY) ANY PAINTED FINISHES TO BE SEMI-GLOSS OR GLOSS (NO FLAT, NO EGG SHELL, NO TEXTURE).

PROVIDE FRP ON WALL AND UNDERSIDE OF BAR.

STAINLESS STEEL WALL FINISH FOR BEHIND AND ADJACENT TO COOK LINE

FIRE EXTINGUISHERS TO BE TYPE K IN KITCHEN

AND TYPE A IN DINING ROOM HARDWARE SCHEDULE DESCRIPTION 3 HINGES. W/LEVERED PRIVACY LOCKSET . KICKPLATE AND DOOR CLOSER PADDLE LATCH EXIT DEVICE AND DOOR CLOSER, PANIC HARDWARE PRIVACY LOCKET

6'-0"

3'-0"

PRONT ELEVATION
SCALE 1/4"=1'-0"

3'-8"


3'-8"

11'-6"

- UNDERSIDE OF EXISTING CEILING -3-5/8" MIN. 20 GA STEEL TOP PLATE — 3−5/8" MIN. MTL. STUDS. 20 GA @16" -5/8" GYP BD TYPE"X" BOTH SIDES PAINTED 3-5/8" MIN. 20 GA STEEL

3'-8"

- BTM PLATE ANCHORED TO

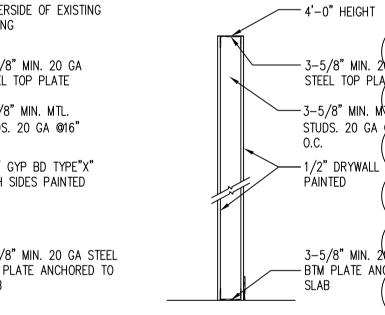

APPROVED B3-2 - Interior and

an existing

2 story 3 dwelling unit

building with basement

and attached 2 car

garage to establish a

restaurant on the 1st


story, to deconvert the

2nd story to 1 dwelling unit and to add a new rooftop deck on the

existing garage.

07/21/21

— BTM PLATE ANÇÃORED TO P2 WALL TYPE P2
NO SCALE

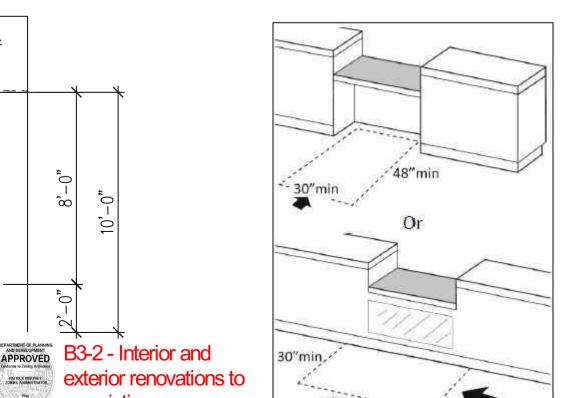

AC - ACGT00048 - SALES/ SERVICE COUNTER MUST CONSIST OF ADEQUATE CLEAR FLOOR SPACE (PER SEC. 305) FOR PARALLEL AND FORWARD APPROACH AND FULLY COMPLY TO ICC/ ANSI SEC. 904

NOTE: A 36"L MIN. X 36"H MAX. COUNTER MAY CONSIST OF A PARRALLEL APPROACH.

NOTE: A 30"L MIN. X 36"H MAX. COUNTER MUST CONSIST OF A FORWARD APPROACH.

4'-0" HEIGHT	UNDERSIDE OF EXISTING CEILING
3–5/8" MIN. 20 GA STEEL TOP PLATE 3–5/8" MIN. MTL.	5-5/8" MIN. 16GA STEEL TOP PLATE 5-5/8" MIN. MTL. STUDS. 16GA @16" O.C.
STUDS. 20 GA @16" 0.C. 1/2" DRYWALL BOTH SIDES PAINTED	5/8" TYPE C EXTERIOR GRADE GYPSUM BOARD FIBER CEMENT CLADDING W/TRAP CLICK SYSTEM
3-5/8" MIN. 20 GA STEEL BTM PLATE ANCHORED TO SLAB	2-LAYER 5/8" GYP BD TYPE"X" ONE SIDE PAINTED UI U419 2HR FIRE RATED WALL  5-5/8" MIN. 16GA STEEL BTM PLATE ANCHORED TO

K

DEPARTMENT

	ROOM FINISH SCHEDULE											
NO	ROOM	WALLS	BASE	FLOOR	CEILING							
100	ENTRY	GYP. BD. PAINTED	QT COVE BASE	FLOOR TILE	GYP BD PAINTED CLG							
101	DINING AREA	GYP. BD. PAINTED	QT COVE BASE	FLOOR TILE	GYP BD PAINTED CLG							
102	KITCHEN	STAINLESS STEEL	QT COVE BASE	QUARRY TILE	VINYL TILE CLG.							
103	WOMEN'S	CERAMIC TILE	CERAMIC TILE	FLOOR TILE	GYP BD PAINTED CLG							
104	MEN'S	CERAMIC TILE	CERAMIC TILE	FLOOR TILE	GYP BD PAINTED CLG							

EMERGENCY AND GENERAL EGRESS DISCHARGE LIGHTING. CBC 1006.1 ON SHEET E1

/													
١		DOOR SCHEDULE											
)	TAG	DESCRIPTION	FRAME CONSTRUCTION	NOMINAL SIZE	DOOR FINISH	FRAME FINISH	LABEL	HARDWARE SET	COMMENTS				
				WXH									
)	Α	STORE FRONT GLASS DOOR	ALUMINUM	6'-0" x 8'-0"	TEMPERED GLASS	ALUMINUM	-	2	NEW				
,	В	TEMPERED GLASS DOOR	ALUMINUM	3'-0" x 8'-0"	TEMPERED GLASS	ALUMINUM	-	2	NEW				
١	С	HOLLOW METAL DOOR	HOLLOW METAL	3'-0" x 6'-8"	PAINT	PAINT	-	1	NEW				
)	D	WD DOOR	HOLLOW METAL	3'-0" x 6'-8"	PAINT	PAINT	-	2	NEW				
	E	HOLLOW METAL DOOR	HOLLOW METAL	3'-0" x 6'-8"	PAINT	PAINT	-	2	NEW				
)	F	HOLLOW METAL DOOR	HOLLOW METAL	3'-0" x 6'-8"	PAINT	PAINT	-	2	NEW				
<u>'</u>		* ALL EXIT DOORS MUST	OPEN WITHOUT THE USE	OF A KEY OR	SPECIAL KNOWLED	GE FROM TH	F SIDE	WHICH EGRESS	IS MADE				

\* ALL EXIT DOORS MUST OPEN WITHOUT THE USE OF A KEY OR SPECIAL KNOWLEDGE FROM THE SIDE WHICH EGRESS IS MADE \* LEVERED HANDLE HARDWARE AS REQUIRED BY ILLINOIS ACCESSIBILITY CODE \* PROVIDE DOOR CLOSERS ALONG ALL ACCESSIBLE ROUTES

	EQUIPMENT SCHEDULE											
NO	QTY	DESCRIPTION	GAS	ELECT	RIC	PLUMBING	REMARKS					
1	1	ICE MAKER	-	220V	13.6A	3/8" CW	NSF,AIR COOLED CONDENSING UNIT					
2	1	PRE RINSE	_	_	_	1/2" CW,1/2" HW,4" INDIRECT DRAIN	NSF					
3	1	SOUP POT	3/4"	-	-	_	NSF, 110000 BTU					
4	1	36" RANGE	3/4"	_	_	-	NSF, 35000 BTU					
5	1	STEEL COUNTER W/CABINETS	_	_	-	-	NSF					
6	2	DEEP FRYER W/CASTERS	3/4"	-	-	_	NSF, 110000 BTU					
7	2	12'-0"X4'-0" EXHAUST HOOD, TYPE I	_	-	-	-	U.L. W/ANSUL FIRE SUPPRESSION SYSTEM					
8	7	WORK TABLE	_	-	-	-	NSF,W/ 6" STAINLESS STEEL LEGS NSF APPROVED					
9	2	REFRIGERATED PREP TABLE	_	120V	6A	_	NSF,W/ CASTERS					
10	1	8'X7' WALK-IN COOLER	-	220V	1.5 HP 9A	-	NSF					
11	1	6'-6"X7' WALK-IN FREEZER	-	220V	1.5 HP 9A	-	NSF					
12	1	HOT WATER HEATER	1"	120V	-	3/4" CW & 3/4" HW	NSF, 75GALLONS					
13	6	SHELVING	_	_	-	_	NSF APPROVED STAINLESS STEEL SHELVING					
14	1	3 COMPARTMENT SINK	-	-	-	1/2" CW,1/2" HW,4" INDIRECT DRAIN	NSF,W/ ECOLAB PATHWAY TO PREVENT BACKFLOW					
15	1	MOP SINK	_	_		1/2"CW,1/2" HW, 4" DRAIN	NSF, W/ MOP HOOKS, SEAL EDGES					
16	3	HAND SINK	-	_	-	1/2" CW,1/2" HW, 2" DRAIN	NSF, WALL MOUNTED - SEALED					
17	1	3'-6"X4'-0" EXHAUST HOOD,TYPE II	_	_	-	-	NSF					
18	1	PREP SINK W/1 DRAIN BOARD	-	_	-	1/2"CW,1/2" HW, 4" INDIRECT DRAIN	NSF, W/INTEGRAL DRAINBOARD					
19	2	COOLER	-	120V	4A	-	NSF,W/ CASTERS					
20	1	OVEN	3/4"	_	-	-	NSF, 54000 BTU					
21	1	SOUP WARMER	3/4"	-	-	1/2"CW,4" INDIRECT DRAIN	NSF, 80000 BTU					
22	1	6 BURNER CHINESE WOK	1.5"	-	-	1/2"CW, 4" INDIRECT DRAIN	NSF, 660000 BTU					
23	1	DISHWASHER		240V	-	1/2"HW, 4" INDIRECT DRAIN	NSF					
24	1	CLEAN DISH TABLE	-	-	-	-	NSF					

DEPARTMENT OF BUILDINGS STANDARD PLAN REVIEW CONDITIONAL PERMIT Construction subject to full upliance with the Municipal Code of Chicago and field inspection Building Commissioner

> Time anderson SELF CERTIFICATION

TW ARCHITECT INC 2425 S WENTWORTH AVE CHICAGO IL 60616

Phone: (312) 912-5798 Email: twarchitect98@yahoo.com

LICENSE NO: 001-022013

EXPIRES: 11/30/2022

 $\approx$  $\overline{\simeq}$ 

SSUED FOR PERMIT reissued for Perm



**NEW 1ST FLOOR** PLAN

COOKLINE EQUIPMENT AND REACH-IN REFRIGERATION AND FREEZER UNITS TO BE INSTALLED ON CASTERS. NSF STAINLESS STEEL SHELF OVER 3-COMPTMENT SINK. ICE MAKER A MIN. 8" FROM ALL WALLS. HEAVY-DUTY MOP RACKS LOCATED OVER MOP SINK. HEAVY-DUTY BROOM RACKS IN JANITORIAL AREA. METAL GARBAGE CANS WITH LIDS FOR RESTROOMS. SANITARY BOX IN WOMEN'S RESTROOMS. METAL GARBAGE CANS WITH LIDS FOR DIAPER CHANGING STATION.

ALL NSF APPROVED HAND SINKS TO BE WITH BLADE HANDLED FAUCETS. WAITRESS, BEVERAGE STATION & BAR COUNTER TOP -STAINLESS STEEL . ALL CABINET SHELVES -STAINLESS STEEL.

ALL CABINET BASE - 6" STAINLESS STEEL LEGS (NO KICK BASE)

LAVATORY COUNTERTOP TO BE SOLID SURFACE (NO PLASTIC LAMINATE OR CABINETRY)
ANY PAINTED FINISHES TO BE SEMI-GLOSS OR GLOSS (NO FLAT, NO EGG SHELL,NO TEXTURE),

PROVIDE FRP ON WALL AND UNDERSIDE OF BAR.

STAINLESS STEEL WALL FINISH FOR BEHIND AND ADJACENT TO COOK LINE

#### DRY STORAGE


DRY STORAGE: 25% OF 320SF (KITCHEN AREA.) = 80SF REQ'D ACTUAL DRY STORAGE 80SF PROVIDED.

1SHELVINGS X 5X4X2 = 40 + 40SF = 80SF

ALL FOOD AND FOOD RELATED ITEMS MUST BE STORED OFF THE FLOOR ON DURABLE WASHABLE SHELVES. THE STORAGE AREA MUST BE APPROPRIATELY SIZED BASED ON THE NUMBER OF MEALS SERVED DAILY AND THE NUMBER OF DELIVERIES WEEKLY.

ALL FOOD EQUIPMENT TO BE ON CASTERS, 6" LEGS, OR SEALED TO THE FLOOR FOR EASY CLEANING.

NO RAW WOOD SURFACES PERMITTED ANYWHERE. UNDERSIDES OF COUNTERTOPS, INSIDE OF CABINETRY, AND WATER HEATER PLATFORMS MUST BE SEALED.

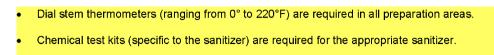

pH meter and log for acidifying rice.All cooling/freezing units must have accurate thermometers.

Covered waste cans are required in all restrooms.

 Toilets, urinals, hand sinks, 3 compartment sinks, mop sink, prep sinks, and permanent counters/cabinets must be sealed to floors and walls with a silicone caulk seal.

 Anti-siphon devices are required on all toilet tanks, urinals, and faucets with hose connections


Soap and paper towels are required at all hand sinks.

Provide hair restraints and disposable gloves for all food handlers.


If sinks are provided with spring-loaded faucets, the faucets must remain running for a minimum


Doors leading to the outside and restroom doors are required to be self-closing and tight-fitting.

Please confirm that the doors leading to the outside are equipped with a self-closer and weather

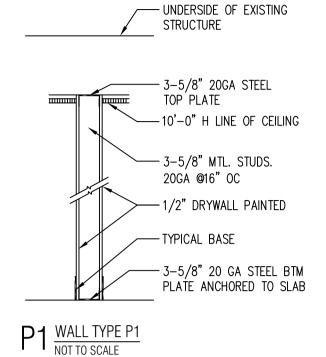



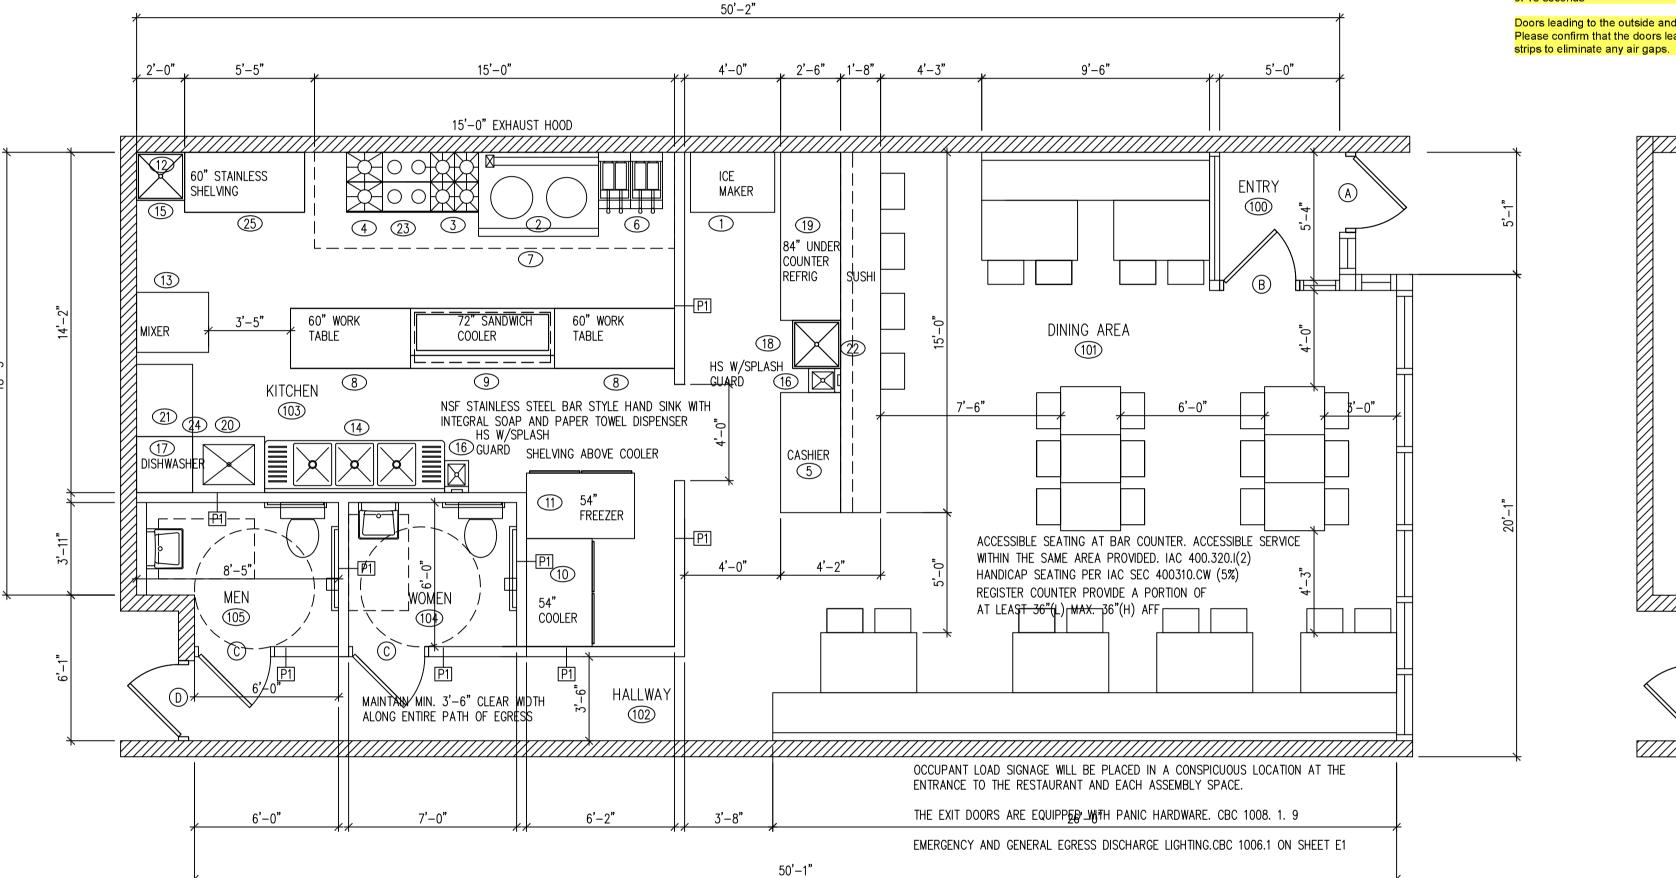

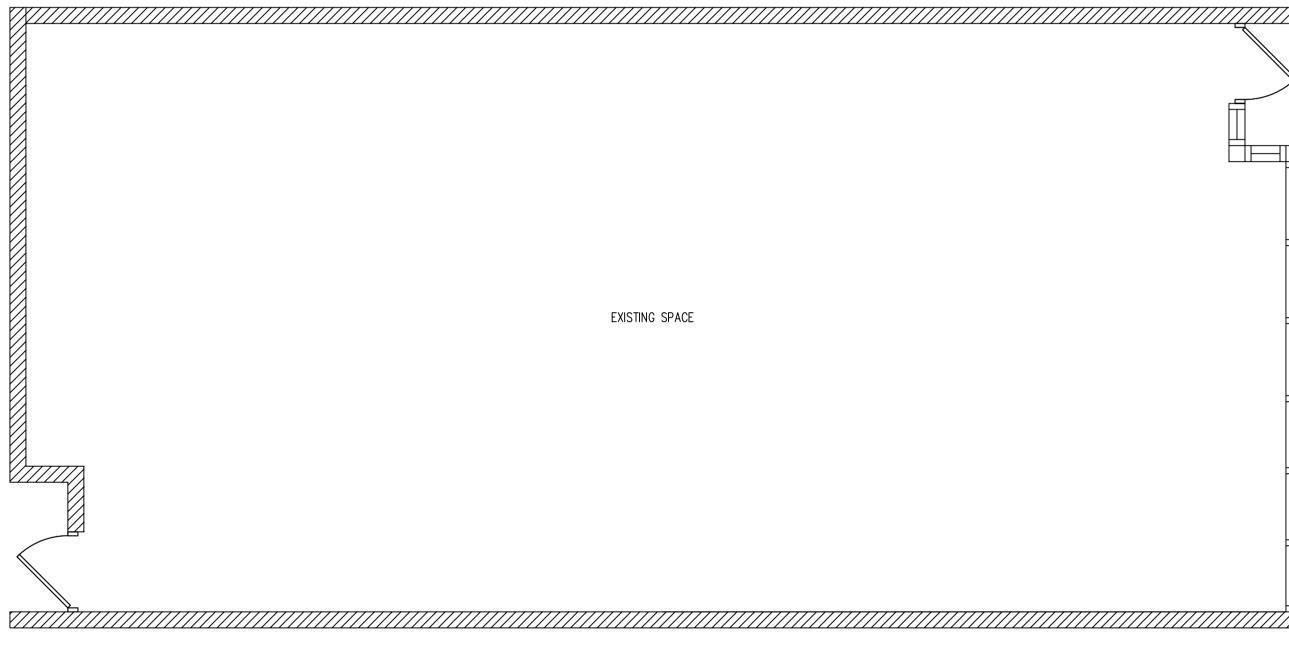

B DEMO PLAN
SCALE 3/16"=1'-0"

N EXIST

EXISTING WALL TO REMAIN

## A FLOOR PLAN SCALE 1/4"=1'-0" NEW WALL NEW WALL

EQUIPMENT SCHEDULE											
NO	QTY	DESCRIPTION	GAS	ELEC	TRIC	PLUMBING	REMARKS				
1	1	ICE MAKER	_	120V	6A	3/8" CW, 4" OSD	NSF,AIR COOLED CONDENSING UNIT				
2	1	2 BURNER CHINESE WOK	3/4"	_	_	1/2"CW, 4" INDIRECT DRAIN	NSF, 220000 BTU				
3	1	4 BURNER	3/4"	-	-	-	NSF, 90000 BTU				
4	1	STOVE	3/4"	-	-	-	NSF, 90000 BTU				
5	1	COUNTER W/CABINETS	-	-	-	-	NSF				
6	2	DEEP FRYER W/CASTERS	3/4"	_	-	-	NSF, 110000 BTU				
7	1	15'-0"X4'-0" EXHAUST HOOD, TYPE I	-	-	-	-	U.L. W/ANSUL FIRE SUPPRESSION SYSTEM				
8	2	WORK TABLE	_	-	-	_	NSF,W/ 6" STAINLESS STEEL LEGS NSF APPROVED				
9	1	REFRIGERATED PREP TABLE	-	120V	4A	-	NSF,W/ CASTERS				
10	1	54" REFRIG.	_	120V	5A	_	NSF				
11	1	54" FREEZER	-	120V	5A	-	NSF				
12	1	TANKLESS HOT WATER HEATER	1"	120V	=	3/4" CW & 3/4" HW	NSF, 200000 BTU				
13	1	MIXER	-	-	-	-	NSF				
14	1	3 COMPARTMENT SINK	-	-		1/2" CW,1/2" HW,4" INDIRECT DRAIN	NSF,W/ ECOLAB PATHWAY TO PREVENT BACKFLOW				
15	1	MOP SINK/A FLOOR BASIN UNIT	-	-		1/2"CW,1/2" HW, 4" DRAIN	NSF, W/ MOP HOOKS, SEAL EDGES				
16	2	HAND SINK	-	-	¥	1/2" CW,1/2" HW, 2" DRAIN	NSF, WALL MOUNTED - SEALED				
17	1	DISHWASHER	_	220V	_	1/2" HW, 4" INDIRECT DRAIN	NSF				
18	1	PREP SINK	-	-	¥	1/2"CW,1/2" HW, 4" INDIRECT DRAIN	NSF				
19	1	UNDER COUNTER REFRIG.	-	120V	4A	_	NSF				
20	1	3' DISHTABLE (SOILED)	-	-	-	1/2" HW, 4" INDIRECT DRAIN	NSF,W/ 6" STAINLESS STEEL LEGS NSF APPROVED				
21	1	3' DISHTABLE (CLEAN)	-	-	-	-	NSF,W/ 6" STAINLESS STEEL LEGS NSF APPROVED				
22	1	SUSHI COUNTER	-	-	-	-	NSF				
23	1	NOODLE COOKER	3/4"	_	-	1/2"CW, 4" INDIRECT DRAIN	NSF, 90000 BTU				
24	1	3'-0"X3'-0" EXHAUST HOOD, TYPE II	-	-	-	-	NSF				
25	1	STAINLESS STEEL SHELVING	-	-	-	-	NSF				
ALL	EQUIPN	MENTS WILL BE NSF APPROVED CLEAN,OPE	RABLE AND SU	JBJECT TO	THE FINAL APPROVAL	BY THE HEALTH					

DEPARTMENT

ROOM FINISH SCHEDULE										
NO	ROOM	WALLS	BASE	FLOOR	CEILING					
100	VESTIBULE	GYP. BD. PAINTED	QT COVE BASE	FLOOR TILE	OPEN CEILING					
101	DINING AREA	GYP. BD. PAINTED	QT COVE BASE	FLOOR TILE	OPEN CEILING					
102	HALLWAY	GYP. BD. PAINTED	QT COVE BASE	FLOOR TILE	OPEN CEILING					
103	KITCHEN	STAINLESS STEEL	QT COVE BASE	QUARRY TILE	2'X4' VINYL TILE CLG.					
104	WOMEN'S	CERAMIC TILE	CERAMIC TILE	FLOOR TILE	2'X4' CLG.					
105	MEN'S	CERAMIC TILE	CERAMIC TILE	FLOOR TILE	2'X4' CLG.					

	DOOR SCHEDULE										
TAG	DESCRIPTION	FRAME CONSTRUCTION	NOMINAL SIZE	DOOR FINISH	FRAME FINISH LABEL	HARDWARE SET	COMMENTS				
			WXH								
Α	STORE FRONT GLASS DOOR	ALUMINUM	3'-0" x 8'-0"	TEMPERED GLASS	ALUMINUM -	2	EXIST'G FRONT EXIT DOOR				
В	TEMPERED GLASS DOOR	ALUMINUM	3'-0" x 7'-0"	TEMPERED GLASS	ALUMINUM -	2	NEW				
С	HOLLOW METAL DOOR	HOLLOW METAL	3'-0" x 6'-8"	PAINT	PAINT -	1	NEW				
D	HOLLOW METAL DOOR	HOLLOW METAL	3'-0" x 6'-8"	PAINT	PAINT -	2	EXIST'G				
	* ALL EXIT DOORS MUST	OPEN WITHOUT THE US	E OF A KEY OR S	SPECIAL KNOWLED	GE FROM THE SIDE	WHICH EGRESS	S IS MADE				
	* LEVERED HANDLE HARD	OWARE AS REQUIRED BY	/ ILLINOIS ACCES	SSIBILITY CODE							

	HARDWARE SCHEDULE										
TAG	DESCRIPTION										
1	3 HINGES, W/LEVERED PRIVACY LOCKSET, KICKPLATE AND DOOR CLOSER										
2	PADDLE LATCH EXIT DEVICE AND DOOR CLOSER, PANIC HARDWARE										
3	PRIVACY LOCKET										

\* PROVIDE DOOR CLOSERS ALONG ALL ACCESSIBLE ROUTES

#### KITCHEN EQUIPMENT NOTES

CONTRACTOR SHALL INSTALL AND CONNECT ALL EQUIPMENT AS PER EQUIPMENT SUPPLIER'S SPECIFICATIONS. ALL LOCATIONS TO BE VERIFIED WITH OWNER PRIOR TO INSTALLATION.

PLUMBING CONTRACTOR SHALL PROVIDE ALL ROUGH-INS. INSULATE ALL COLD/HOT WATER PIPES AS REQUIRED. MAINTAIN MIN 36" IN FRONT OF ALL COOKING EQUIPMENT.

ELECTRICAL CONTRACTOR SHALL PROVIDE ALL ELECTRICAL OUTLETS FOR EQUIPMENT. VERIFY ALL ELECTRICAL REQUIREMENTS WITH EQUIPMENT SUPPLIER. VERIFY ALL GAS AND WATER REQUIREMENTS WITH EQUIPMENT SUPPLIER.

ALL PERMANENT EQUIPMENT MUST BE LOCATED SO THAT AREAS BEHIND, UNDERNEATH, AND ON THE SIDES OF THE EQUIPMENT CAN BE EASILY CLEANED.

TWO DRAIN BOARDS ARE REQUIRED AT ALL THREE-COMPARTMENT SINKS ALONG WITH AN APPROPRIATELY SIZED FAUCET, LOCKABLE DRAIN PLUGS, AND AN INDIRECT CONNECTION TO THE SEWER.

STANDARD PLAN REVIEW
CONDITIONAL
PERMIT
Construction subject to full compliance with the Municipal Code of Chicago and field inspection
Building
Commissioner

SELF CERTIFICATION

TW ARCHITECT INC 2425 S WENTWORTH AVE. CHICAGO IL 60616

PHONE: (312) 912-5798 EMAIL: twarchitect98@yahoo.com

LICENSE NO: 001-022013 EXPIRES: 11/30/2022


OWNER
JANE WAI TING MAK
2300 S ARCHER AVE UNIT 112A
CHICAGO IL 60616
PHONE: (312)-375-1178

NTERIOR REMODELING
2300 S ARCHER AVE UNIT 112A

SSUES DATE
SSUED FOR PERMIT 07/15/2021
REISSUED FOR PERMIT 08/05/2021



FLOOR PLAN & DEMO PLAN

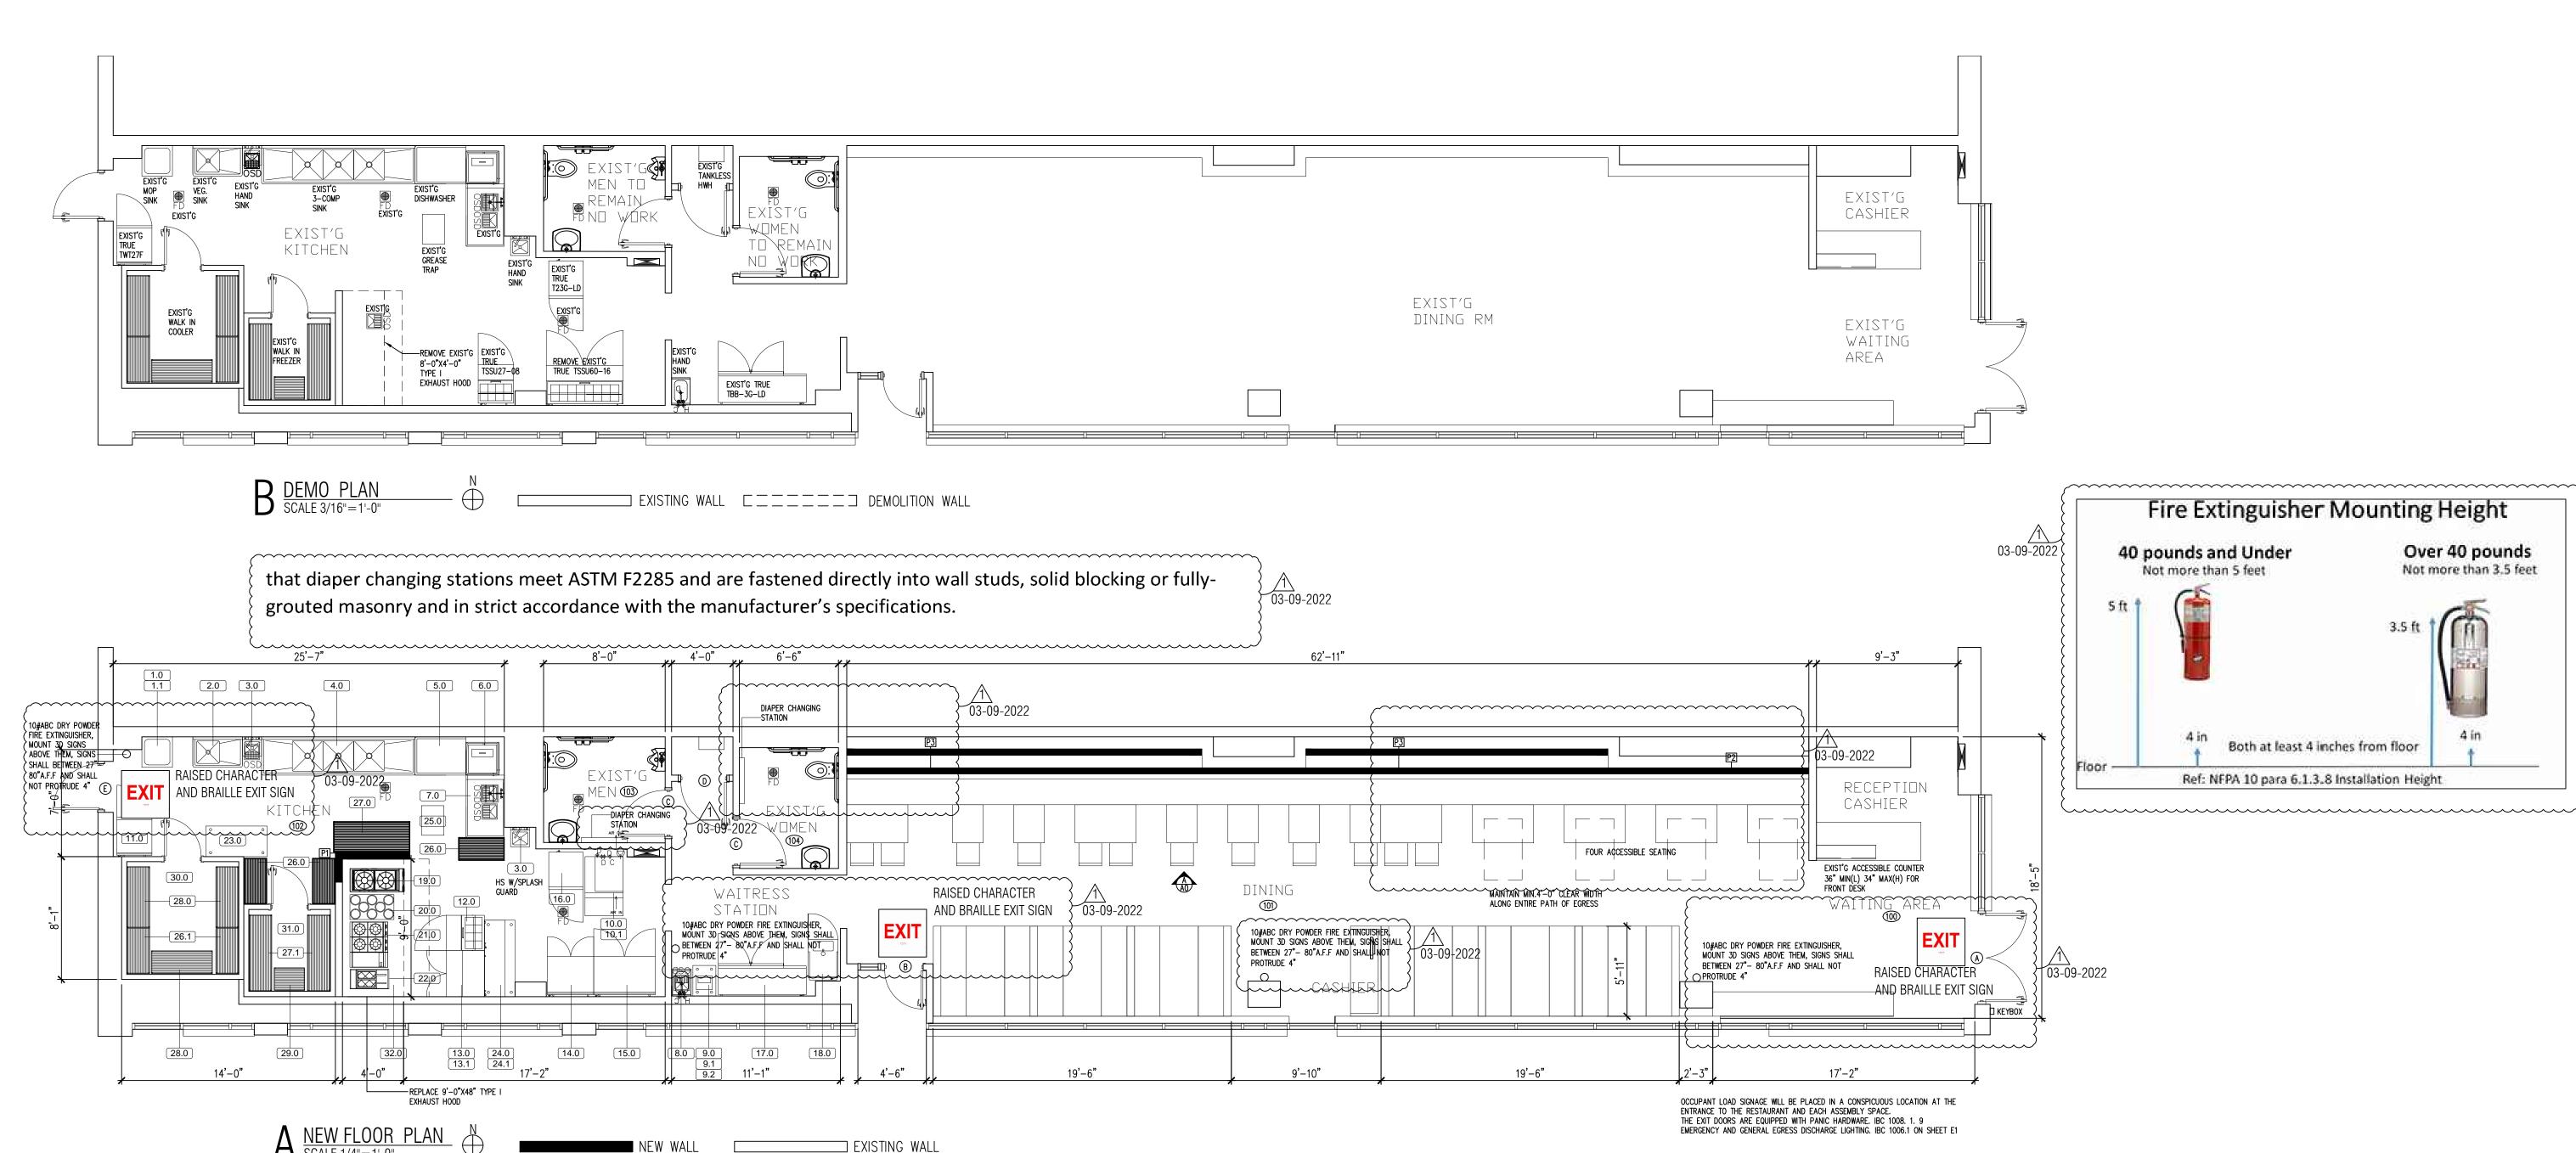

HARDWARE SCHEDULE DESCRIPTION 1 1/2 PAIR BUTT HINGES, W/ SELF CLOSING DEVICE

1 1/2 PAIR BUTT HINGES, PADDLE LATCH EXIT DEVICE AND DOOR CLOSER, PANIC HARDWARE

PROVIDE DOOR CLOSERS ALONG ALL ACCESSIBLE ROUTES

1 1/2 PAIR BUTT HINGES, SELF CLOSING DEVICE, ACCESSIBLE HARDWARE

	DOOR SCHEDULE										
TAG	DESCRIPTION	FRAME CONSTRUCTION	NOMINAL SIZ	ZE	DOOR FINISH	FRAME FINISH	LABEL	HARDWARE	COMMENTS		
.,,,,,			WXH								
A	STORE FRONT GLASS DOOR	ALUMINUM	6'-0" x	7'-0"	TEMPERED GLASS	ALUMINUM	-	3	EXIST'G		
В	STORE FRONT GLASS DOOR	ALUMINUM	3'-0" x	7'-0"	TEMPERED GLASS	ALUMINUM	-	3	EXIST'G		
С	HOLLOW METAL DOOR	PRE-HUNG METAL	3'-0" x	7'-0"	PAINT	PAINT	-	2	EXIST'G		
D	HOLLOW METAL DOOR	PRE-HUNG METAL	3'-0" x	7'-0"	PAINT	PAINT	1	1	EXIST'G		
E	HOLLOW METAL DOOR	PRE-HUNG METAL	3'-0" x	7'-0"	PAINT	PAINT	-	3	EXIST'G		
	ALL EXIT DOORS MUST OPEN WITHOUT THE USE OF A KEY OR SPECIAL KNOWLEDGE FROM THE SIDE WHICH EGRESS IS MADE										
	LEVERED HANDLE HAR	DWARE AS REQUIRE	D BY ILLIN	IOIS A	ACCESSIBILITY COI	DE					

	ROOM FINISH SCHEDULE											
NO	ROOM	WALLS	BASE	FLOOR	CEILING							
100	WAITING AREA	EXIST'G GYP. BD. PAINTED	EXIST'G QT COVE BASE	EXIST'G FLOOR TILE	EXIST'G 2'X2' CEILING							
101	DINING	EXIST'G GYP. BD. PAINTED	EXIST'G QT COVE BASE	EXIST'G FLOOR TILE	EXIST'G 2'X2' CEILING							
102	KITCHEN	EXIST'G STAINLESS STEEL	EXIST'G QT COVE BASE	EXIST'G QUARRY TILE	EXIST'G 4'X2' CEILING							
103	MEN'S TOILET	EXIST'G CERAMIC TILE	EXIST'G CERAMIC TILE	EXIST'G FLOOR TILE	EXIST'G 2'X2' CEILING							
104	WOMEN'S TOILET	EXIST'G CERAMIC TILE	EXIST'G CERAMIC TILE	EXIST'G FLOOR TILE	EXIST'G 2'X2' CEILING							

## KITCHEN EQUIPMENT NOTES

COOKING EQUIPMENT.

CONTRACTOR SHALL INSTALL AND CONNECT ALL EQUIPMENT AS PER EQUIPMENT SUPPLIER'S SPECIFICATIONS. ALL LOCATIONS TO BE VERIFIED WITH OWNER PRIOR

TO INSTALLATION. PLUMBING CONTRACTOR SHALL PROVIDE ALL ROUGH-INS. INSULATE ALL COLD/HOT WATER PIPES AS REQUIRED. MAINTAIN MIN 36" IN FRONT OF ALL

ELECTRICAL CONTRACTOR SHALL PROVIDE ALL ELECTRICAL OUTLETS FOR EQUIPMENT. VERIFY ALL ELECTRICAL REQUIREMENTS WITH EQUIPMENT SUPPLIER.

ALL PERMANENT EQUIPMENT MUST BE LOCATED SO THAT AREAS BEHIND, UNDERNEATH, AND ON THE SIDES OF THE EQUIPMENT CAN BE EASILY CLEANED.

VERIFY ALL GAS AND WATER REQUIREMENTS WITH EQUIPMENT SUPPLIER.

TWO DRAIN BOARDS ARE REQUIRED AT ALL THREE-COMPARTMENT SINKS ALONG WITH AN APPROPRIATELY SIZED FAUCET, LOCKABLE DRAIN PLUGS, AND AN INDIRECT CONNECTION TO THE SEWER.

- Dial stem thermometers (ranging from 0° to 220°F) are required in all preparation areas.
- Chemical test kits (specific to the sanitizer) are required for the appropriate sanitizer.
- pH meter and log for acidifying rice.
- All cooling/freezing units must have accurate thermometers.
- Covered waste cans are required in all restrooms.
- Toilets, urinals, hand sinks, 3 compartment sinks, mop sink, prep sinks, and permanent counters/cabinets must be sealed to floors and walls with a silicone caulk seal.
- Anti-siphon devices are required on all toilet tanks, urinals, and faucets with hose
- Soap and paper towels are required at all hand sinks.
- Provide hair restraints and disposable gloves for all food handlers.

If sinks are provided with spring-loaded faucets, the faucets must remain running for a minimum

Doors leading to the outside and restroom doors are required to be self-closing and tight-fitting. Please confirm that the doors leading to the outside are equipped with a self-closer and weather strips to eliminate any air gaps.

### DRY STORAGE

DRY STORAGE: 25% OF 360 SF (KITCHEN AREA.) = 90SF REQ'D ACTUAL DRY STORAGE 5X4X4X2 + 3X3X1.5X4 = 94SF PROVIDED.

ALL FOOD AND FOOD RELATED ITEMS MUST BE STORED OFF THE FLOOR ON DURABLE WASHABLE SHELVES. THE STORAGE AREA MUST BE APPROPRIATELY SIZED BASED ON THE NUMBER OF MEALS SERVED DAILY AND THE NUMBER OF DELIVERIES WEEKLY.

ALL FOOD EQUIPMENT TO BE ON CASTERS, 6" LEGS, OR SEALED TO THE FLOOR FOR EASY CLEANING.

NO RAW WOOD SURFACES PERMITTED ANYWHERE. UNDERSIDES OF COUNTERTOPS, INSIDE OF CABINETRY, AND WATER HEATER PLATFORMS MUST BE SEALED.

PROVIDE THE FOLLOWING: NSF STAINLESS STEEL OPEN WIRE SHELVING UNITS. NSF STAINLESS STEEL SHELF OVER 3-COMPTMENT SINK. ICE MAKER A MIN. 8" FROM ALL WALLS. HEAVY-DUTY MOP RACKS LOCATED OVER MOP SINK.


HEAVY-DUTY BROOM RACKS IN JANITORIAL AREA. METAL GARBAGE CANS WITH LIDS FOR RESTROOMS. SANITARY BOX IN WOMEN'S RESTROOMS. METAL GARBAGE CANS WITH LIDS FOR DIAPER CHANGING STATION.

ALL NSF APPROVED HAND SINKS TO BE WITH BLADE HANDLED FAUCETS. BEVERAGE STATION & BAR COUNTER TOP -STAINLESS STEEL ALL CABINET SHELVES -STAINLESS STEEL.

ALL CABINET BASE - 6" STAINLESS STEEL LEGS (NO KICK BASE) LAVATORY COUNTERTOP TO BE SOLID SURFACE (NO PLASTIC LAMINATE OR CABINETRY) ANY PAINTED FINISHES TO BE SEMI-GLOSS OR GLOSS (NO FLAT, NO EGG SHELL, NO TEXTURE),

PROVIDE FRP ON WALL AND UNDERSIDE OF BAR. STAINLESS STEEL WALL FINISH FOR BEHIND AND ADJACENT TO COOK LINE

FIRE EXTINGUISHERS TO BE TYPE K IN KITCHEN AND TYPE A IN DINING ROOM

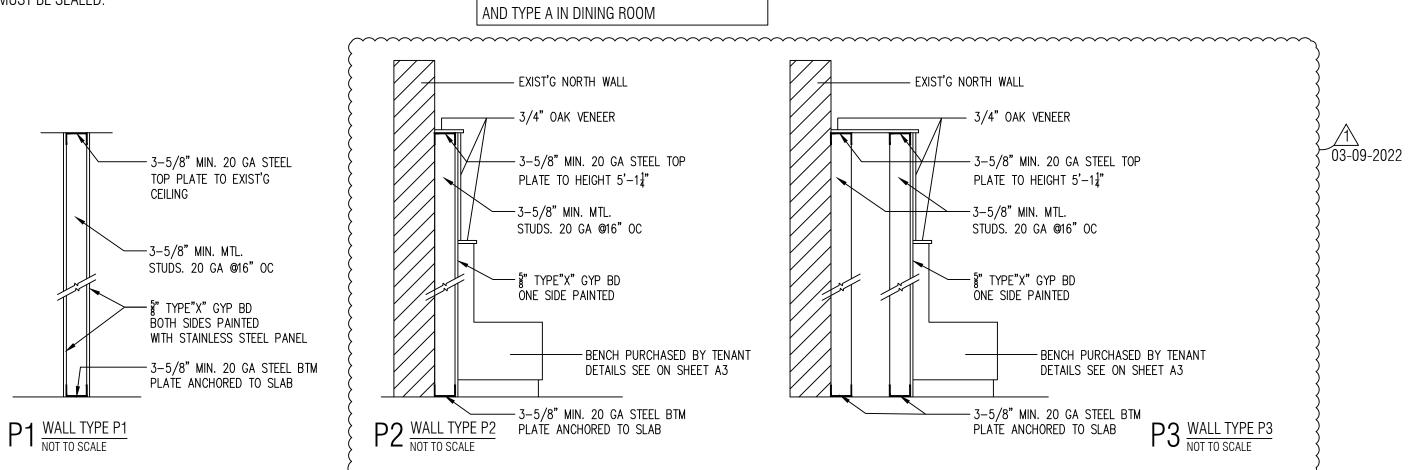

2425 S WENTWORTH AVE CHICAGO, IL 60616

PHONE: (312) 912-5798 EMAIL: twarchitect98@yahoo.com

LICENSE NO: 001-022013 EXPIRES: 11/30/2022

OWNER TANAKA RAMEN

112 E GREEN STREET CHAMPAIGN IL 61820

MEP PROFESSIONAL ENGINEER 236 W ALEXANDER STREET CHICAGO IL 60616


PHONE: (312)720-8800 BILLY WANG68@HOTMAIL.COM LICENSE NO: 062.068227 EXPIRES: 11/30/2023

 $\triangleleft$  $\triangleleft$  $\triangleleft$ 

ISSUES	DATE
ISSUED FOR PERMIT	11/05/2021
REISSUED FOR PERMIT	03/09/2022

FLOOR PLAN, NOTES, &



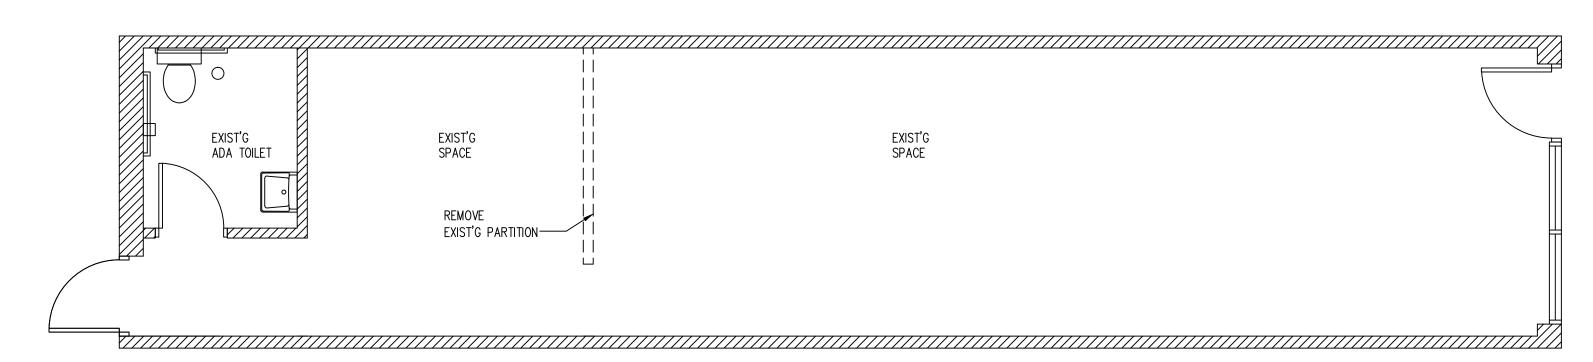


3-5/8" MIN. 20 GA STEEL
TOP PLATE TO EXIST'G
CEILING


3-5/8" MIN. MTL.
STUDS. 20 GA @16" OC

1/2" DRYWALL PAINTED

3-5/8" MIN. 20 GA STEEL BTM
PLATE ANCHORED TO SLAB

P1 WALL TYPE I

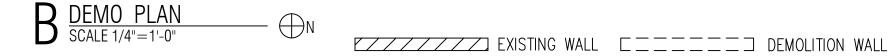

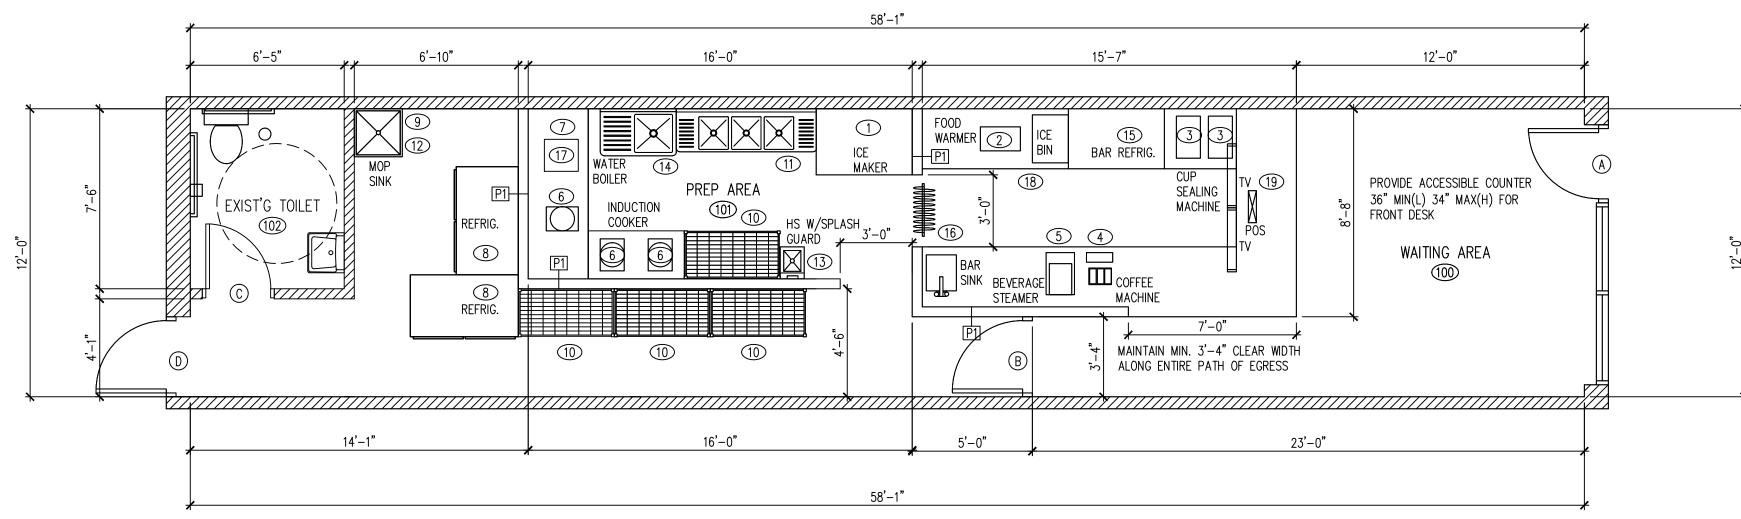

A NEW FLOOR PLAN ON EXISTING WALL NEW WALL

OCCUPANT LOAD SIGNAGE WILL BE PLACED IN A CONSPICUOUS LOCATION AT THE ENTRANCE TO THE RESTAURANT AND EACH ASSEMBLY SPACE.

THE EXIT DOORS ARE EQUIPPED WITH PANIC HARDWARE. IBC 1008. 1. 9

EMERGENCY AND GENERAL EGRESS DISCHARGE LIGHTING. IBC 1006.1 ON SHEET E1

	DOOR SCHEDULE											
TAG	TAG DESCRIPTION FRAME CONSTRUCTION NOMINAL SIZE DOOR FINISH FRAME FINISH LABEL HARDWARE COMMENTS											
			WXH									
Α	STORE FRONT GLASS DOOR	ALUMINUM	3'-0"	X	7'-0"	TEMPERED GLASS	ALUMINUM	-	3	EXIST'G		
В	WOOD DORO	WOOD	3'-0"	X	6'-8"	PAINT	PAINT	-	1	NEW		
С	HOLLOW METAL DOOR	PRE-HUNG METAL	3'-0"	X	6'-8"	PAINT	PAINT	-	2	EXIST'G		
D	HOLLOW METAL DOOR	PRE-HUNG METAL	3'-0"	X	6'-8"	PAINT	PAINT	_	3	EXIST'G		
	ALL EXIT DOORS MUST OPEN WITHOUT THE USE OF A KEY OR SPECIAL KNOWLEDGE FROM THE SIDE WHICH EGRESS IS MADE											
	LEVERED HANDLE HAR	DWARE AS REQUIRE	D BY I	LLIN	IOIS A	CCESSIBILITY CO	DE					
	PROVIDE DOOR CLOSE	ERS ALONG ALL ACC	ESSIBL	EF	OUTE	S						

	HARDWARE SCHEDULE						
TAG	TAG DESCRIPTION						
1	1 1/2 PAIR BUTT HINGES, W/ SELF CLOSING DEVICE						
2	1 1/2 PAIR BUTT HINGES, SELF CLOSING DEVICE, ACCESSIBLE HARDWARE						
3	1 1/2 PAIR BUTT HINGES, PADDLE LATCH EXIT DEVICE AND DOOR CLOSER, PANIC HARDWARE						

DEPARTMENT

	ROOM FINISH SCHEDULE											
NO	NO ROOM WALLS BASE FLOOR CEILING											
100	WAITING AREA	GYP. BD. PAINTED	QT COVE BASE	FLOOR TILE	GYP BD PAINTED							
101	PREP AREA	STAINLESS STEEL	QT COVE BASE	QUARRY TILE	EPOXY PAINTED							
102	TOILET	CERAMIC TILE	CERAMIC TILE	FLOOR TILE	GYP BD PAINTED							

	EQUIPMENT SCHEDULE										
NO	QTY	DESCRIPTION	GAS	ELECTR	IC	PLUMBING	REMARKS				
1	1	ICE MAKER	-	220V	12.8A	3/8"CW,4" INDIRECT DRAING	NSF,AIR COOLED CONDENSING UNIT				
2	1	FOOD WARMER	_	120V	12A	-	NSF				
3	1	CUP SEALING MACHINE	-	120V	3.6A	_	NSF				
4	1	COFFEE MACHINE	-	220V	30A	3/8"CW,4" INDIRECT DRAING	NSF				
5	1	BEVERAGE STEAMER	-	220V	13.6A	3/8"CW,4" INDIRECT DRAING	NSF				
6	3	INDUCTION COOKER	=	220V	15.9A	-	NSF				
7	1	STAINLESS STEEL CABINET TABLE	-	-	-	_	NSF				
8	2	REFRIGERATOR	H	120V	4.5A	-	NSF				
9	1	TANKLESS HWH	3/4"	120V	=	3/4" CW & 3/4" HW	NSF				
10	4	SHELVING	-	-	-	-	NSF APPROVED STAINLESS STEEL SHELVING				
11	1	3 COMPARTMENT SINK	-	-	_	1/2" CW,1/2" HW,4" INDIRECT DRAIN	NSF,W/ ECOLAB PATHWAY TO PREVENT BACKFLOW				
12	1	MOP SINK	-	-		1/2"CW,1/2" HW, 4" DRAIN	NSF, W/ MOP HOOKS, SEAL EDGES				
13	1	HAND SINK	-	_	_	1/2" CW,1/2" HW, 2" DRAIN	NSF, WALL MOUNTED - SEALED				
14	1	SINGLE COMPARTMENT SINK	-	-	-	1/2"CW,1/2" HW, 4" INDIRECT DRAIN	NSF, W/INTEGRAL DRAINBOARD				
15	1	BAR REFRIGERATOR	-	120V	4.5A	_	NSF,W/ CASTERS				
16	1	BAR SINK	-	-	-	1/2"CW,1/2" HW, 4" INDIRECT DRAIN	NSF,W/ ECOLAB PATHWAY TO PREVENT BACKFLOW				
17	1	WATER BOILER	-	220V	18.1A	1/2"CW, 4" INDIRECT DRAIN	NSF				
18	1	STAINLESS STEEL CABINET TABLE W/ICE BIN	-	-	-	3" INDIRECT DRAIN	NSF				
19	1	COUNTER	-	-	=		NSF				

NSF STAINLESS STEEL SHELF OVER 3-COMPTMENT SINK. ICE MAKER A MIN. 8" FROM ALL WALLS.
HEAVY-DUTY MOP RACKS LOCATED OVER MOP SINK.
HEAVY-DUTY BROOM RACKS IN JANITORIAL AREA. METAL GARBAGE CANS WITH LIDS FOR RESTROOMS.
SANITARY BOX IN WOMEN'S RESTROOMS. METAL GARBAGE CANS WITH LIDS FOR DIAPER CHANGING STATION.

ALL NSF APPROVED HAND SINKS TO BE WITH BLADE HANDLED FAUCETS.
BEVERAGE STATION & BAR COUNTER TOP -STAINLESS STEEL.

ALL CABINET SHELVES -STAINLESS STEEL.

ALL CABINET BASE - 6" STAINLESS STEEL LEGS (NO KICK BASE)
LAVATORY COUNTERTOP TO BE SOLID SURFACE (NO PLASTIC LAMINATE OR CABINETRY)

ANY PAINTED FINISHES TO BE SEMI-GLOSS OR GLOSS (NO FLAT, NO EGG SHELL,NO TEXTURE),
PROVIDE FRP ON WALL AND UNDERSIDE OF BAR.
STAINLESS STEEL WALL FINISH FOR BEHIND AND ADJACENT TO COOK LINE

FIRE EXTINGUISHERS TO BE TYPE K IN KITCHEN
AND TYPE A IN DINING ROOM

PROVIDE THE FOLLOWING: NSF STAINLESS STEEL OPEN WIRE SHELVING UNITS.

#### KITCHEN EQUIPMENT NOTES

CONTRACTOR SHALL INSTALL AND CONNECT ALL EQUIPMENT AS PER EQUIPMENT SUPPLIER'S SPECIFICATIONS. ALL LOCATIONS TO BE VERIFIED WITH OWNER PRIOR TO INSTALLATION.

PLUMBING CONTRACTOR SHALL PROVIDE ALL ROUGH-INS. INSULATE ALL COLD/HOT WATER PIPES AS REQUIRED. MAINTAIN MIN 36" IN FRONT OF ALL COOKING EQUIPMENT.

ELECTRICAL CONTRACTOR SHALL PROVIDE ALL ELECTRICAL OUTLETS FOR EQUIPMENT. VERIFY ALL ELECTRICAL REQUIREMENTS WITH EQUIPMENT SUPPLIER. VERIFY ALL GAS AND WATER REQUIREMENTS WITH EQUIPMENT SUPPLIER.

ALL PERMANENT EQUIPMENT MUST BE LOCATED SO THAT AREAS BEHIND, UNDERNEATH, AND ON THE SIDES OF THE EQUIPMENT CAN BE EASILY CLEANED.

TWO DRAIN BOARDS ARE REQUIRED AT ALL THREE-COMPARTMENT SINKS ALONG WITH AN APPROPRIATELY SIZED FAUCET, LOCKABLE DRAIN PLUGS, AND AN INDIRECT CONNECTION TO THE SEWER.

#### DRY STORAGE

DRY STORAGE: 25% OF 500 SF (KITCHEN AREA.)=125SF REQ'D ACTUAL DRY STORAGE 4X4X4X2 = 128SF PROVIDED.

ALL FOOD AND FOOD RELATED ITEMS MUST BE STORED OFF THE FLOOR ON DURABLE WASHABLE SHELVES. THE STORAGE AREA MUST BE APPROPRIATELY SIZED BASED ON THE NUMBER OF MEALS SERVED DAILY AND THE NUMBER OF DELIVERIES WEEKLY.

## ALL FOOD EQUIPMENT TO BE ON CASTERS, 6" LEGS, OR SEALED TO THE FLOOR FOR EASY CLEANING.

NO RAW WOOD SURFACES PERMITTED ANYWHERE. UNDERSIDES OF COUNTERTOPS, INSIDE OF CABINETRY, AND WATER HEATER PLATFORMS MUST BE SEALED.

- Dial stem thermometers (ranging from 0° to 220°F) are required in all preparation areas.
- Chemical test kits (specific to the sanitizer) are required for the appropriate sanitizer.
- pH meter and log for acidifying rice.
- All cooling/freezing units must have accurate thermometers.
- Covered waste cans are required in all restrooms.
- Toilets, urinals, hand sinks, 3 compartment sinks, mop sink, prep sinks, and permanent counters/cabinets must be sealed to floors and walls with a silicone caulk seal.
- Anti-siphon devices are required on all toilet tanks, urinals, and faucets with hose connections.
- Soap and paper towels are required at all hand sinks.
- Provide hair restraints and disposable gloves for all food handlers.
- If sinks are provided with spring-loaded faucets, the faucets must remain running for a minimum of 15 seconds

Doors leading to the outside and restroom doors are required to be self-closing and tight-fitting. Please confirm that the doors leading to the outside are equipped with a self-closer and weather strips to eliminate any air gaps.

WEI TAN
2425 S WENTWORTH AVE
CHICAGO, IL 60616

PHONE: (312) 912-5798 EMAIL: twarchitect98@yahoo.com

LICENSE NO: 001-022013 EXPIRES: 11/30/2022

OWNER VSKD UIUC INC. 509 E GREEN STREET


SUITE C
CHAMPAIGN IL 61820


TERIOR REMODELING 509 E GREEN SUITE C


ISSUES DATE
ISSUED FOR PERMIT 01/08/2020

FLOOR PLAN, NOTES, & SCHEDULES



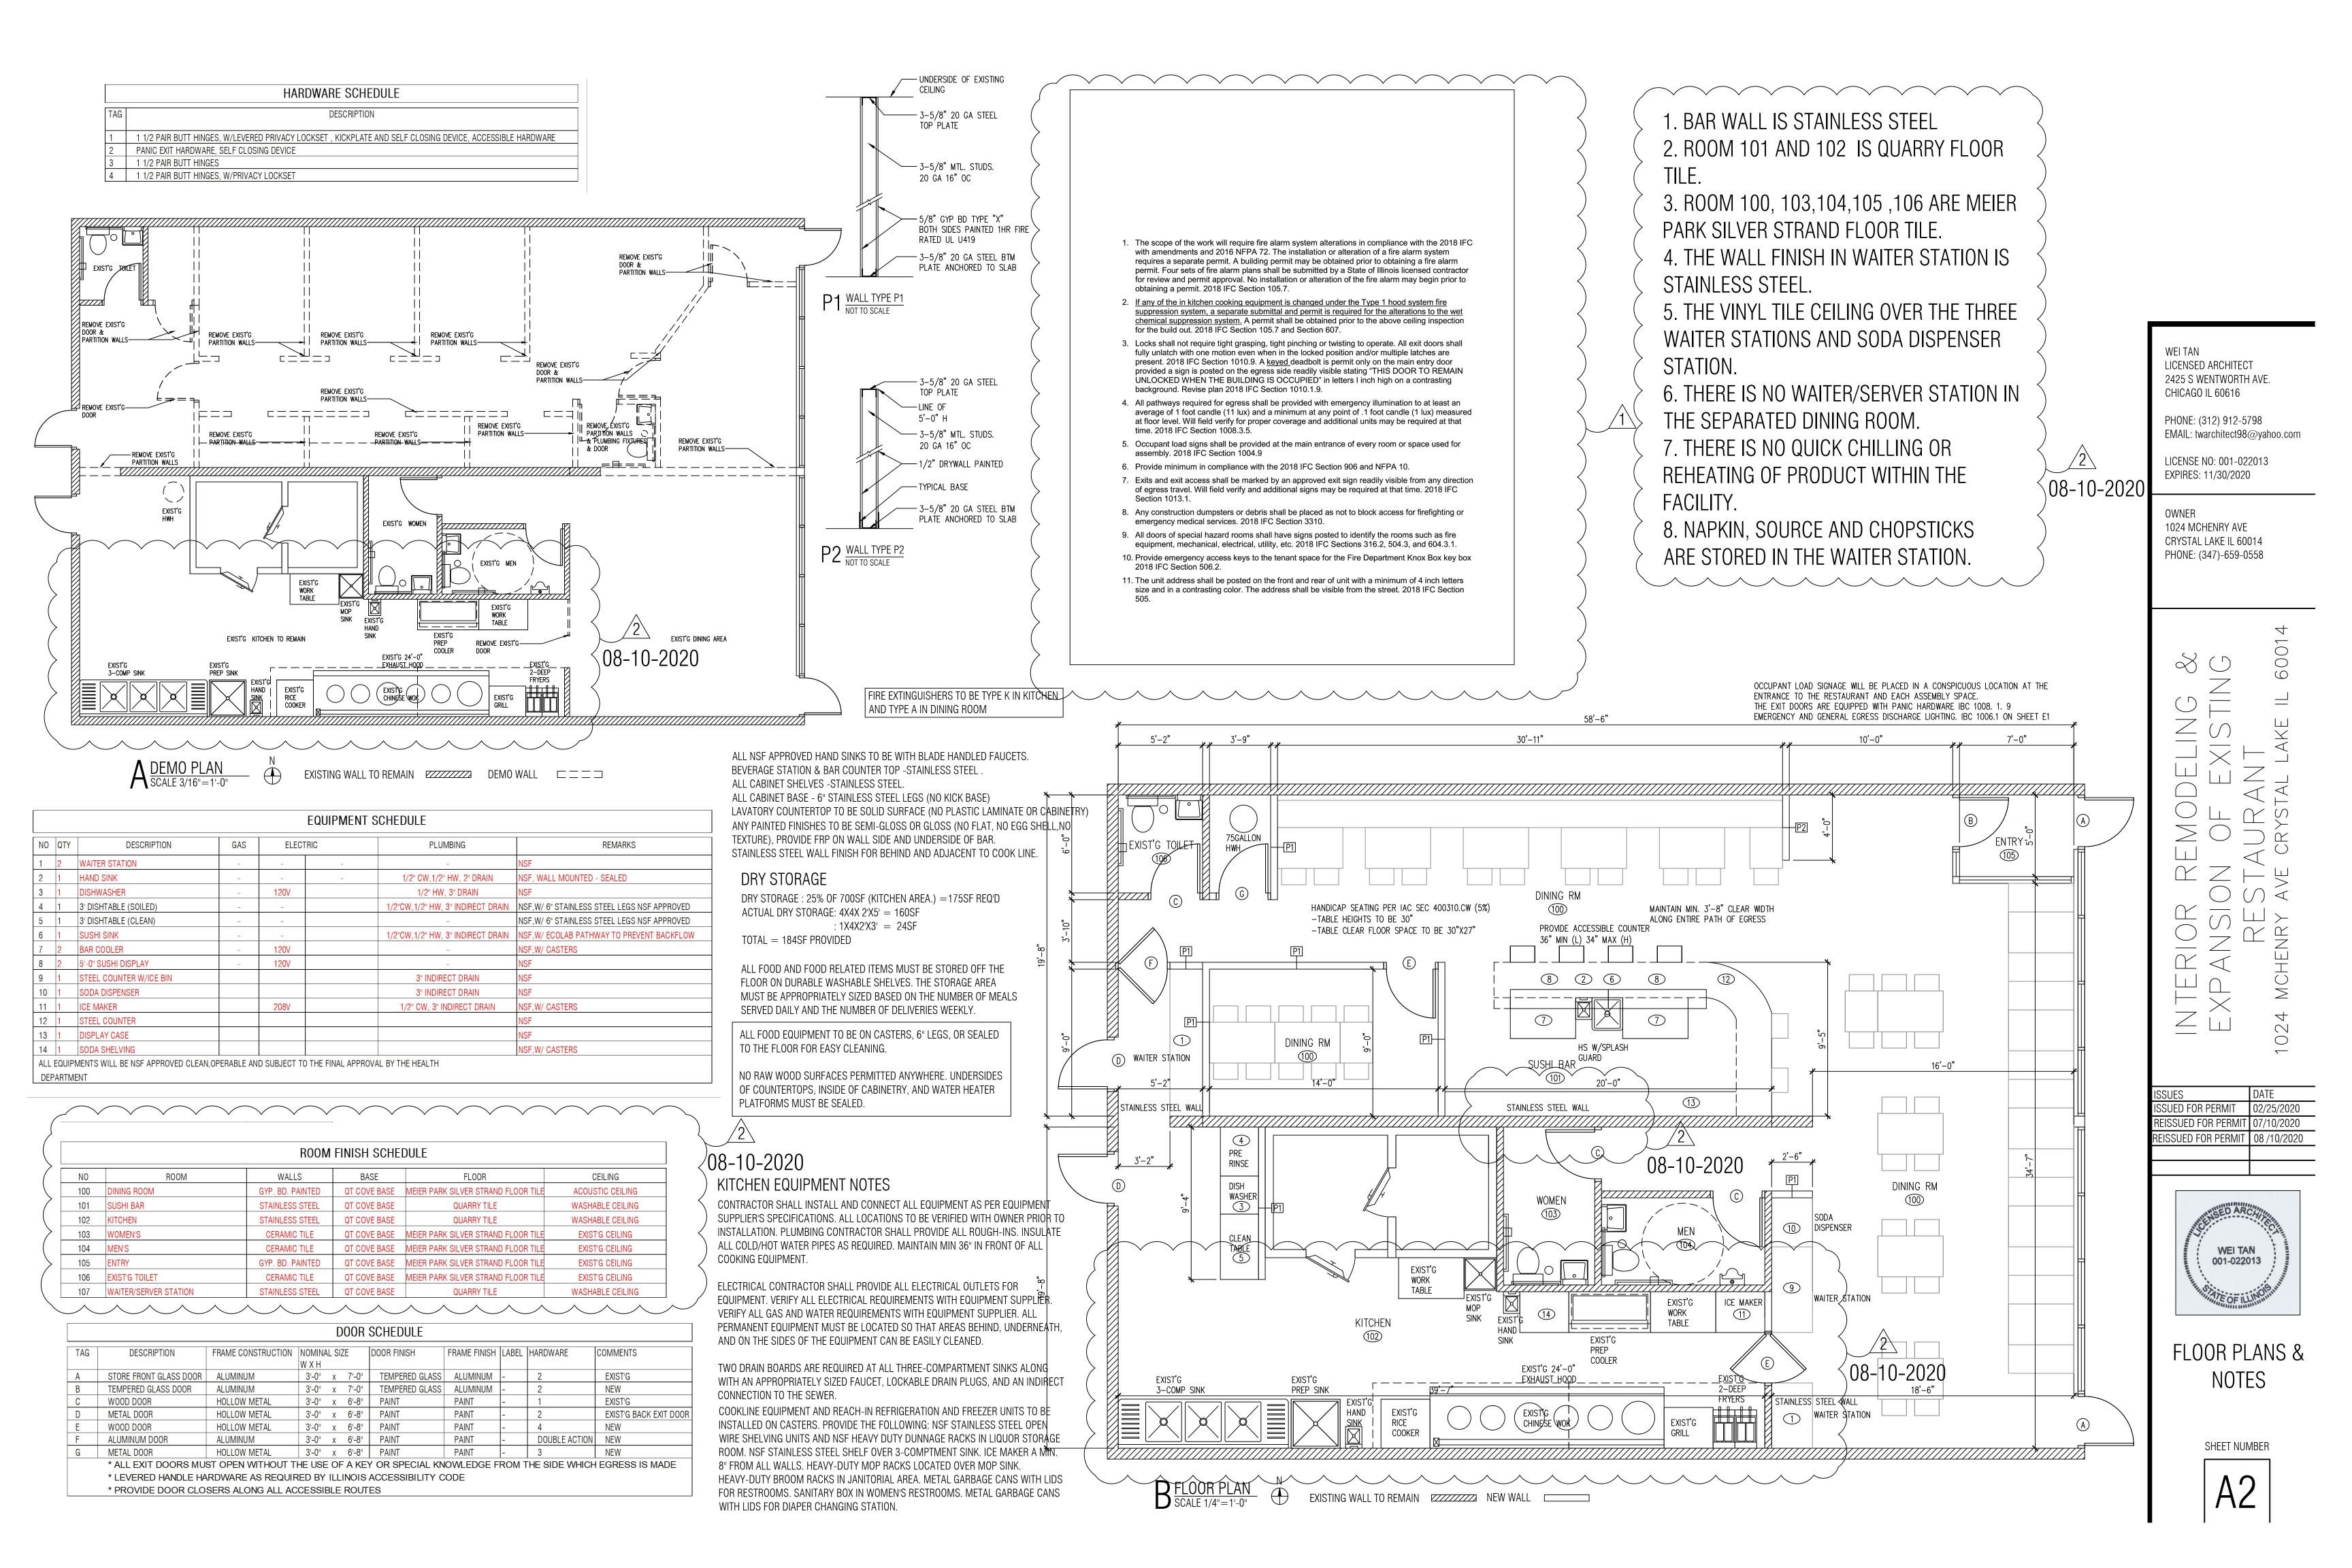

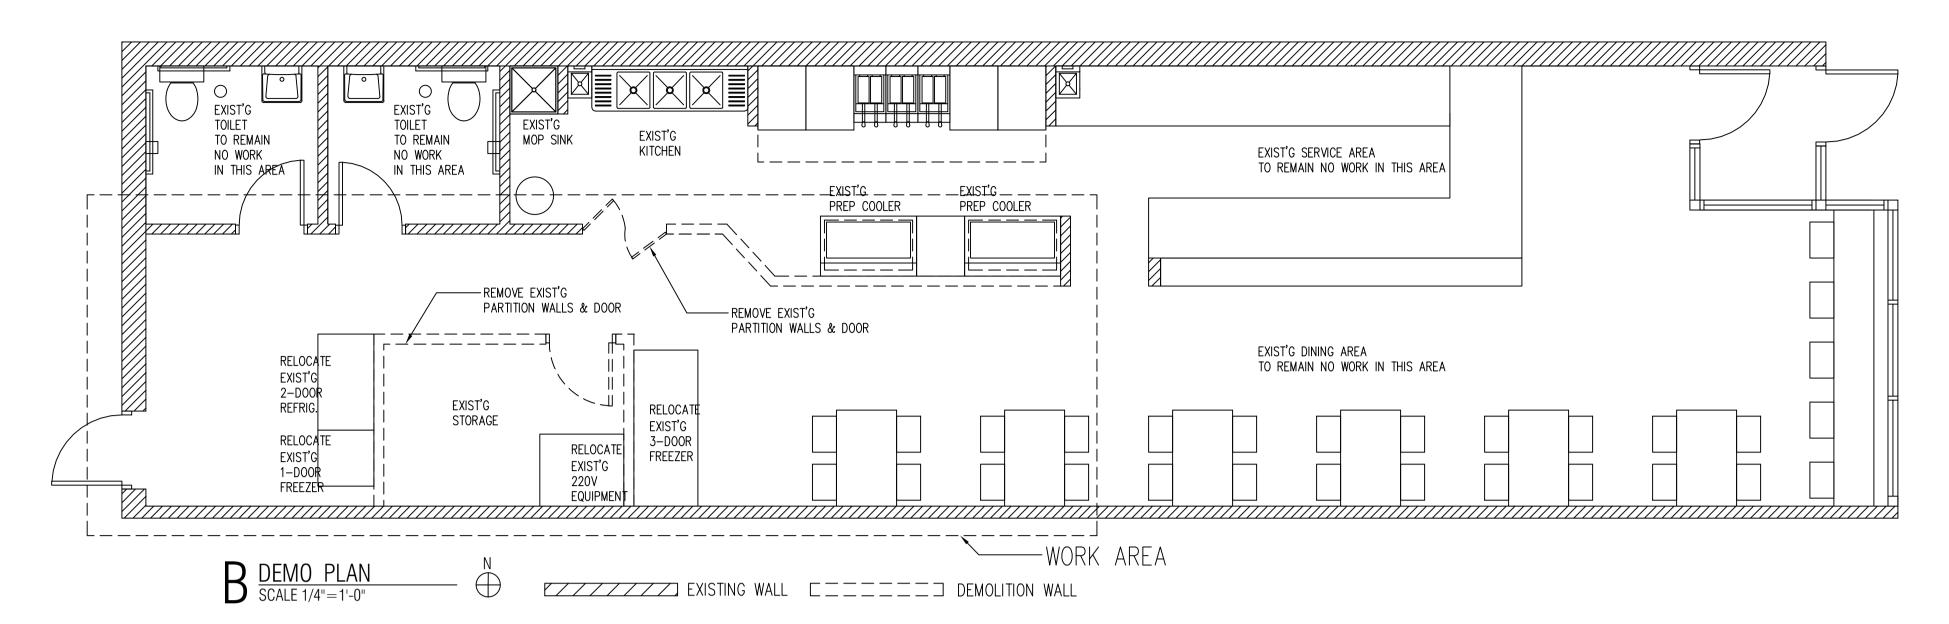

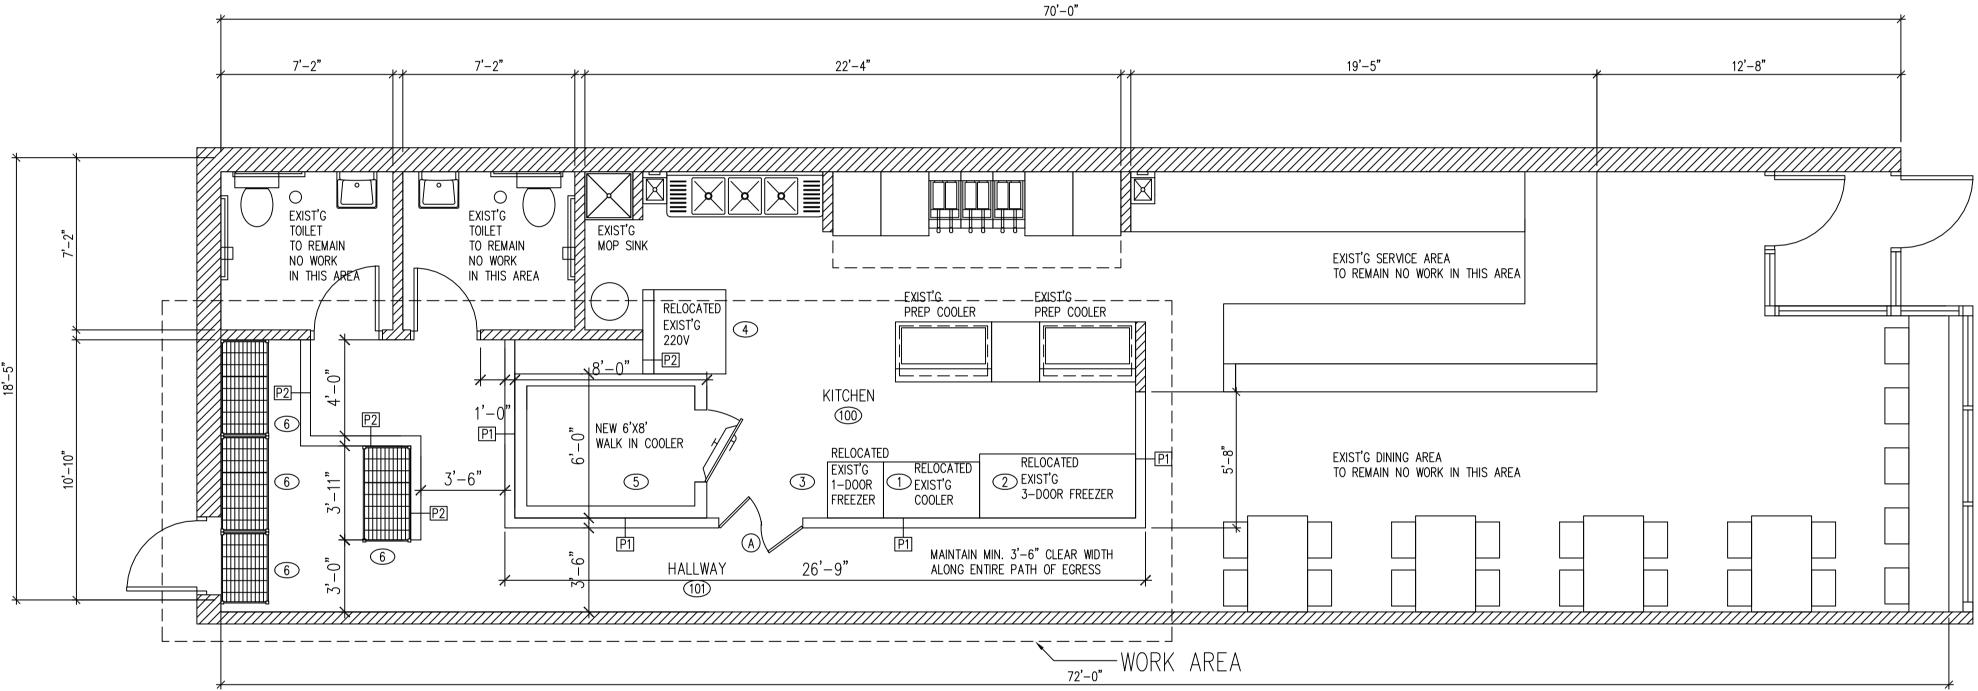


OCCUPANT LOAD SIGNAGE WILL BE PLACED IN A CONSPICUOUS LOCATION AT THE ENTRANCE TO THE MASSAGE STORE SPACE.

THE EXIT DOORS ARE EQUIPPED WITH PANIC HARDWARE. CBC 1008. 1. 9
EMERGENCY AND GENERAL EGRESS DISCHARGE LIGHTING. CBC 1006.1 ON SHT E1

	EQUIPMENT SCHEDULE											
NO	QTY	DESCRIPTION	GAS ELECTRIC		CTRIC	PLUMBING	REMARKS					
1	1	EXIST'G 2 DOORS REACH-IN REFRIGERATOR	_	120V	_	-	NSF, W/CASTER					
2	1	EXIST'G 3 DOORS REACH-IN FREEZER	-	120V	-	-	NSF, W/CASTER					
3	1	EXIST'G 1 DOOR FREEZER	-	120V	ī	-	NSF, W/CASTER					
4	1	EXIST'G 220V EQUIPMENT	_	220V	1	-	NSF					
5	1	NEW 6'X8' WALK IN COOLER	-	240V		3" DRAIN	NSF					
6	4	SHELVING	_	_	-	_	NSF APPROVED STAINLESS STEEL SHELVING					
ALL	ALL EQUIPMENTS WILL BE NSF APPROVED CLEAN, OPERABLE AND SUBJECT TO THE FINAL APPROVAL BY THE HEALTH											
DEF	ARTME	NT										

	ROOM FINISH SCHEDULE											
NO	NO ROOM WALLS BASE FLOOR CEILING											
100	ENLARGED KITCHEN	FRP	QT COVE BASE	QUARRY TILE	2'X4' VINYL TILE CEILING							
101	HALLWAY	GYP BD PAINTED	QT COVE BASE	FLOOR TILE	EXIST'G 2'X4' LAY INCEILING							

	DOOR SCHEDULE												
TAG													
	W X H												
Α	ALUMINUM	ALUMINUM	3'-6" x 6'-8"	PAINT	PAINT	-	DOUBLE ACTION	NEW					
	* ALL EXIT DOORS	MUST OPEN WITHOU	T THE USE OF A	KEY OR SPEC	IAL KNOWLE	DGE F	ROM THE SIDE	WHICH EGRESS IS MADE					
	* LEVERED HANDLE HARDWARE AS REQUIRED BY ILLINOIS ACCESSIBILITY CODE												
	* PROVIDE DOOR CLOSERS ALONG ALL ACCESSIBLE ROUTES												

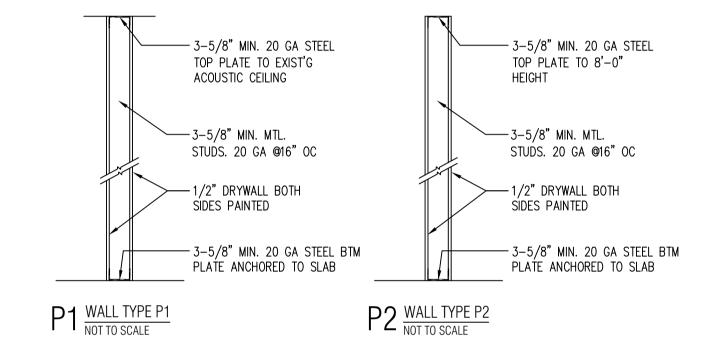

## DRY STORAGE

DRY STORAGE: 25% OF 350SF (KITCHEN AREA.) =88SF REQ'D
ACTUAL DRY STORAGE: 3X2'X4' X4=96SF
: 4X2'X3' =24SF
TOTAL =120SF PROVIDED

ALL FOOD AND FOOD RELATED ITEMS MUST BE STORED OFF THE FLOOR ON DURABLE WASHABLE SHELVES. THE STORAGE AREA MUST BE APPROPRIATELY SIZED BASED ON THE NUMBER OF MEALS SERVED DAILY AND THE NUMBER OF DELIVERIES WEEKLY.

ALL FOOD EQUIPMENT TO BE ON CASTERS, 6" LEGS, OR SEALED TO THE FLOOR FOR EASY CLEANING.

#### KITCHEN EQUIPMENT NOTES

CONTRACTOR SHALL INSTALL AND CONNECT ALL EQUIPMENT AS PER EQUIPMENT SUPPLIER'S SPECIFICATIONS. ALL LOCATIONS TO BE VERIFIED WITH OWNER PRIOR TO INSTALLATION. PLUMBING CONTRACTOR SHALL PROVIDE ALL ROUGH-INS. INSULATE ALL COLD/HOT WATER PIPES AS REQUIRED. MAINTAIN MIN 36" IN FRONT OF ALL COOKING EQUIPMENT.

ELECTRICAL CONTRACTOR SHALL PROVIDE ALL ELECTRICAL OUTLETS FOR EQUIPMENT. VERIFY ALL ELECTRICAL REQUIREMENTS WITH EQUIPMENT SUPPLIER. VERIFY ALL GAS AND WATER REQUIREMENTS WITH EQUIPMENT SUPPLIER. ALL PERMANENT EQUIPMENT MUST BE LOCATED SO THAT AREAS BEHIND, UNDERNEATH, AND ON THE SIDES OF THE EQUIPMENT CAN BE EASILY CLEANED.

TWO DRAIN BOARDS ARE REQUIRED AT ALL THREE-COMPARTMENT SINKS ALONG WITH AN APPROPRIATELY SIZED FAUCET, LOCKABLE DRAIN PLUGS, AND AN INDIRECT CONNECTION TO THE SEWER.

COOKLINE EQUIPMENT AND REACH-IN REFRIGERATION AND FREEZER UNITS TO BE INSTALLED ON CASTERS. PROVIDE THE FOLLOWING: NSF STAINLESS STEEL SHELF OVER 3-COMPTMENT SINK. ICE MAKER A MIN. 8" FROM ALL WALLS. HEAVY-DUTY MOP RACKS LOCATED OVER MOP SINK. HEAVY-DUTY BROOM RACKS IN JANITORIAL AREA. METAL GARBAGE CANS WITH LIDS FOR RESTROOMS. SANITARY BOX IN WOMEN'S RESTROOMS. METAL GARBAGE CANS WITH LIDS FOR DIAPER CHANGING STATION.

STANDARD PLAN REVIEW
CONDITIONAL
PERMIT
Construction subject to full compliance with the Municipal Code of Chicago and field inspection
Building
Commissioner
By
SELF

CERTIFICATION

TW ARCHITECT 2425 S WENTWORTH AVE CHICAGO, IL 60616

PHONE: (312) 912-5798 EMAIL: twarchitect98@yahoo.com

LICENSE NO: 001-022013 EXPIRES: 11/30/2022

OWNER 2026 S CLARK STREET UNIT C

CHICAGO IL 60616


NTERIOR REMODELING 026 S CLARK STREET UNIT C

ISSUES	DATE
ISSUED FOR PERMIT	11/20/2020



FLOOR PLAN, NOTES, & SCHEDULES



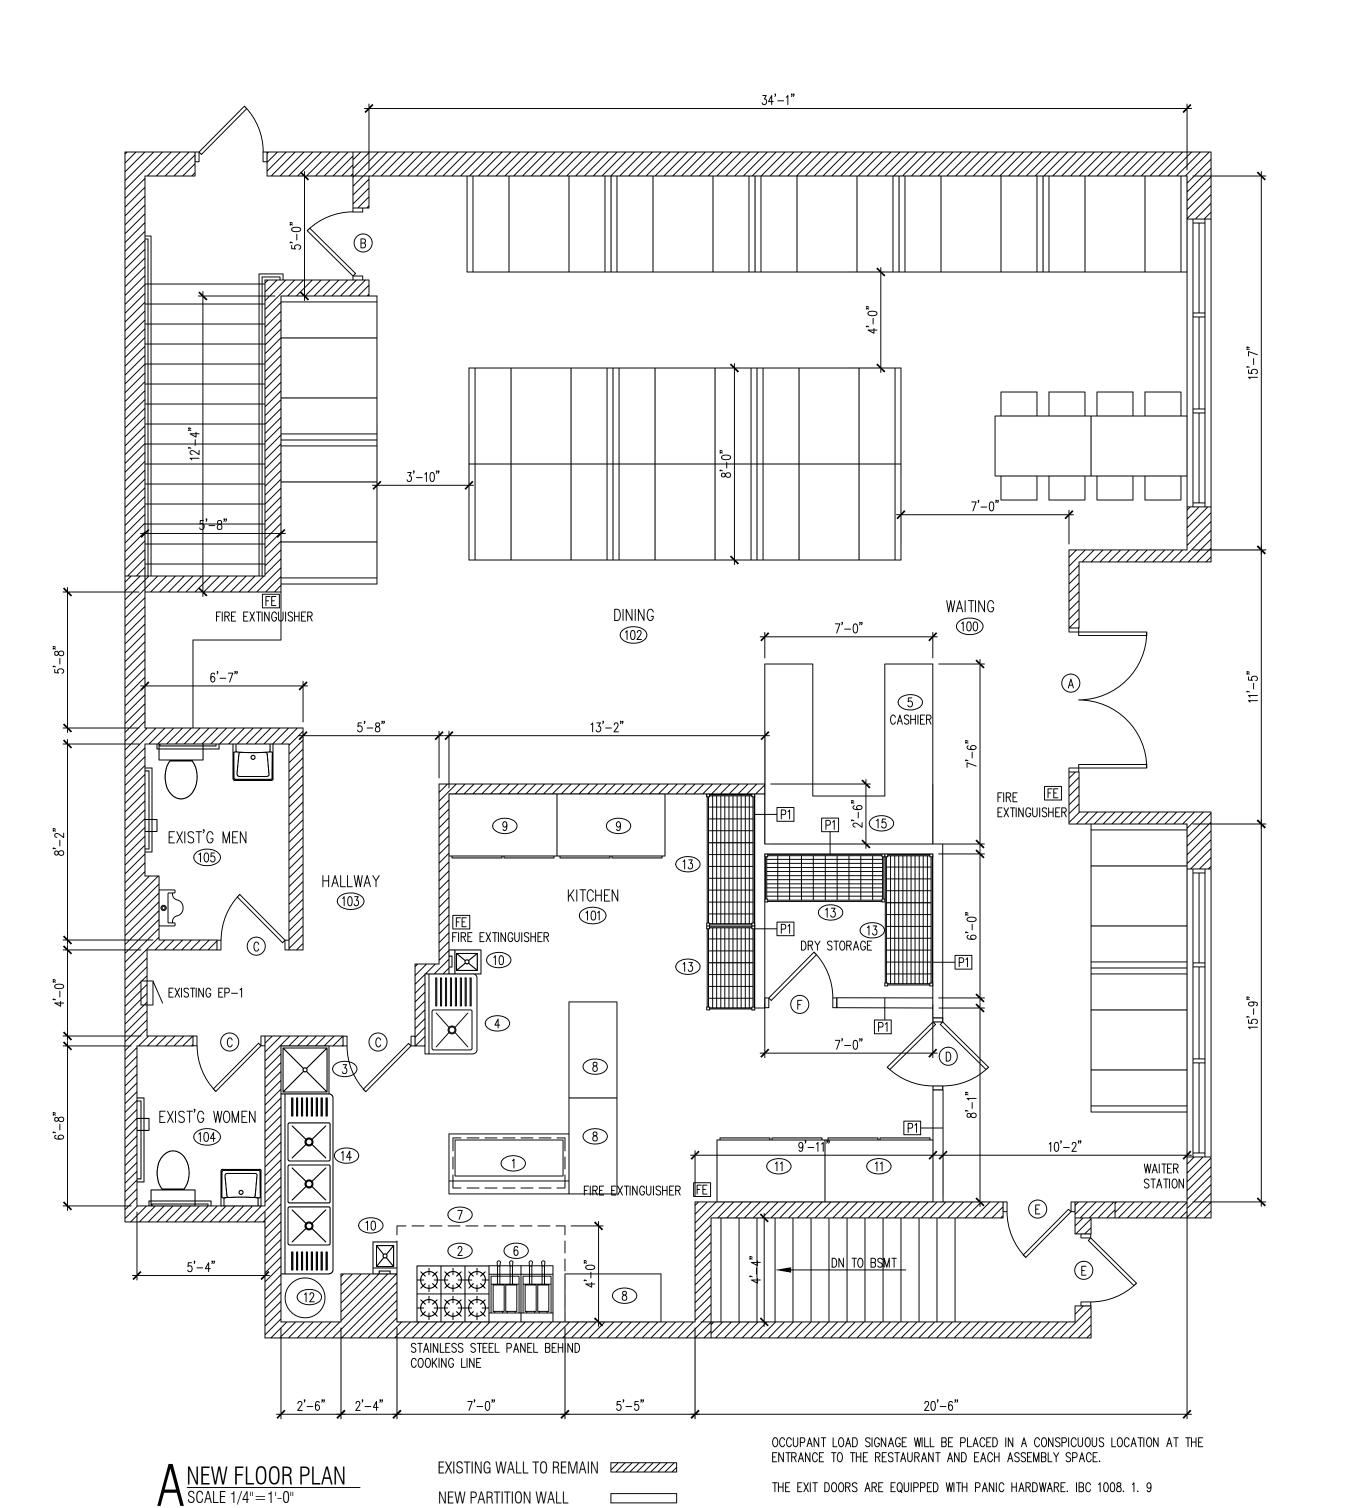

EMERGENCY AND GENERAL EGRESS DISCHARGE LIGHTING. IBC 1006.1 ON SHEET E1

—REMOVE EXISTING **EXISTING** MEN \ EXISTING EP−1 -REMOVE EXISTING PARTITION WALLS EXISTING WOMEN 3 COMPARTMENT SINK ---REMOVE EXISTING PARTITION WALLS EXIST'G 7'X4' TYPE I EXHAUST HOOD TO REMAIN —CUT EXISTING 3'X7' OPEING B DEMO PLAN SCALE 1/4"=1'-0"

EXISTING WALL TO REMAIN

EXISTING WALL TO BE DEMOLISHED [ ] ]

**REMARKS** 

## KITCHEN EQUIPMENT NOTES

CONTRACTOR SHALL INSTALL AND CONNECT ALL EQUIPMENT AS PER EQUIPMENT SUPPLIER'S SPECIFICATIONS. ALL LOCATIONS TO BE VERIFIED WITH OWNER PRIOR TO INSTALLATION.

PLUMBING CONTRACTOR SHALL PROVIDE ALL ROUGH-INS. INSULATE ALL COLD/HOT WATER PIPES AS REQUIRED. MAINTAIN MIN 36" IN FRONT OF ALL COOKING EQUIPMENT.

ELECTRICAL CONTRACTOR SHALL PROVIDE ALL ELECTRICAL OUTLETS FOR EQUIPMENT. VERIFY ALL ELECTRICAL REQUIREMENTS WITH EQUIPMENT SUPPLIER. VERIFY ALL GAS AND WATER REQUIREMENTS WITH EQUIPMENT SUPPLIER.

ALL PERMANENT EQUIPMENT MUST BE LOCATED SO THAT AREAS BEHIND, UNDERNEATH, AND ON THE SIDES OF THE EQUIPMENT CAN BE EASILY CLEANED.

TWO DRAIN BOARDS ARE REQUIRED AT ALL THREE-COMPARTMENT SINKS ALONG WITH AN APPROPRIATELY SIZED FAUCET, LOCKABLE DRAIN PLUGS, AND AN INDIRECT CONNECTION TO THE SEWER.

#### DRY STORAGE

DRY STORAGE: 25% OF 440 SF (KITCHEN AREA.) = 110SF REQ'D ACTUAL DRY STORAGE 40X2+50X2= 180SF PROVIDED

ALL FOOD AND FOOD RELATED ITEMS MUST BE STORED OFF THE FLOOR ON DURABLE WASHABLE SHELVES. THE STORAGE AREA MUST BE APPROPRIATELY SIZED BASED ON THE NUMBER OF MEALS SERVED DAILY AND THE NUMBER OF DELIVERIES WEEKLY.

ALL FOOD EQUIPMENT TO BE ON CASTERS, 6" LEGS, OR SEALED TO THE FLOOR FOR EASY CLEANING.

NO RAW WOOD SURFACES PERMITTED ANYWHERE. UNDERSIDES OF COUNTERTOPS, INSIDE OF CABINETRY, AND WATER HEATER PLATFORMS MUST BE SEALED.

	HARDWARE SCHEDULE
TAG	DESCRIPTION
1	3 HINGES, W/LEVERED PRIVACY LOCKSET, KICKPLATE AND DOOR CLOSER
2	PANIC EXIT DEVICE
3	3 HINGES

- Dial stem thermometers (ranging from 0° to 220°F) are required in all preparation areas.
- Chemical test kits (specific to the sanitizer) are required for the appropriate sanitizer.
- pH meter and log for acidifying rice.
- All cooling/freezing units must have accurate thermometers.
- Covered waste cans are required in all restrooms.
- Toilets, urinals, hand sinks, 3 compartment sinks, mop sink, prep sinks, and permanent counters/cabinets must be sealed to floors and walls with a silicone caulk seal.
- Anti-siphon devices are required on all toilet tanks, urinals, and faucets with hose connections.
- Soap and paper towels are required at all hand sinks.
- Provide hair restraints and disposable gloves for all food handlers.

If sinks are provided with spring-loaded faucets, the faucets must remain running for a minimum of 15 seconds

Doors leading to the outside and restroom doors are required to be self-closing and tight-fitting. Please confirm that the doors leading to the outside are equipped with a self-closer and weather strips to eliminate any air gaps.

	ROOM FINISH SCHEDULE										
NO	ROOM	WALLS	BASE	FLOOR	CEILING						
100	WAITING AREA	AN EPOXY PAINT	QT COVE BASE	FLOOR TILE	OPEN CEILING						
	CASHIER AREA	AN EPOXY PAINT	QT COVE BASE	FLOOR TILE	DRYWALL PAINTED						
101	KITCHEN	STAINLESS STEEL	QT COVE BASE	QUARRY TILE	VINYL CLAD GYP BD TILES						
102	DINING AREA	AN EPOXY PAINT	QT COVE BASE	FLOOR TILE	OPEN CEILING						
103	HALLWAY	AN EPOXY PAINT	QT COVE BASE	FLOOR TILE	VINYL CLAD GYP BD TILES						
104	EXIST'G WOMEN	CERAMIC TILE	QT COVE BASE	FLOOR TILE	VINYL CLAD GYP BD TILES						
105	EXIST'G MEN	CERAMIC TILE	QT COVE BASE	FLOOR TILE	VINYL CLAD GYP BD TILES						

\* LEVERED HANDLE HARDWARE AS REQUIRED BY ILLINOIS ACCESSIBILITY CODE

\* PROVIDE DOOR CLOSERS ALONG ALL ACCESSIBLE ROUTES

	DOOR SCHEDULE												
TAG	TAG DESCRIPTION FRAME CONSTRUCTION NOMINAL SIZE DOOR FINISH FRAME FINISH LABEL HARDWARE SET COMMENTS W X H												
Α	STORE FRONT GLASS DOOR	ALUMINUM	6'-0"	X	7'-0"	TEMPERED GLASS	ALUMINUM	_	2	EXIST'G FRONT EXIT DOOR			
В	HOLLOW METAL DOOR	HOLLOW METAL	3'-0"	Χ	7'-0"	PAINT	PAINT	_	2	EXIST'G EXIT DOOR			
С	WOOD DOOR	HOLLOW METAL	3'-0"	X	6'-8"	PAINT	PAINT	-	1	EXIST'G			
D	DOUBLE ACTION DOOR	HOLLOW METAL	3'-0"	X	6'-8"	PAINT	PAINT	-	3	NEW			
Е	HOLLOW METAL DOOR	HOLLOW METAL	3'-0"	X	7'-0"	PAINT	PAINT	_	2	EXIST'G			
F	WOOD DOOR	WOOD	3'-0"	Х	6'-8"	PAINT	PAINT	_	3	NEW			

1	1	REFRIGERATED PREP TABLE	-	120V	4A		NSF
2	1	6 BURNER	3/4"	-	1	-	NSF, 110000 BTU
3	1	MOP SINK	-	-		1/2"CW,1/2" HW, 3"DRAIN	NSF, W/ MOP HOOKS, SEAL EDGES
4	1	1 PREP SINK	-	-	*	1/2" CW,1/2" HW,3" INDIRECT DRAIN	NSF,W/ ECOLAB PATHWAY TO PREVENT BACKFLOW
5	1	CASHIER COUNTER	-	1=	I	-	NSF
6	2	DEEP FRYER	3/4"	-	-	=	NSF, 110000 BTU
7	1	EXIST'G 7'-0"X4'-0" EXHAUST HOOD,TYPE I	-	-	-	-	U.L. W/ANSUL FIRE SUPPRESSION SYSTEM
8	3	WORK TABLE	-	-		-	NSF,W/ 6" STAINLESS STEEL LEGS NSF APPROVED
9	2	54" REACH-IN REFRIGERATOR	-	120V	-	-	NSF
10	2	HAND SINK	-	-	=	1/2" CW,1/2" HW, 2" DRAIN	NSF, WALL MOUNTED - SEALED
11	2	54" FREEZER	-	120V	=	-	NSF
12	1	HOT WATER HEATER	3/4"	120V	-	3/4" CW,3/4" HW	NSF, 50 GALLONS
13	4	SHELVING	-	1-	-	-	NSF APPROVED STAINLESS STEEL SHELVING
14	1	3 COMPARTMENT SINK	=	-	E	1/2" CW,1/2" HW,3" INDIRECT DRAIN	NSF,W/ ECOLAB PATHWAY TO PREVENT BACKFLOW
15	1	48" BEER COOLER	-	120V	_	-	NSF


**PLUMBING** 

**EQUIPMENT SCHEDULE** 

**ELECTRIC** 

GAS

**DESCRIPTION** 

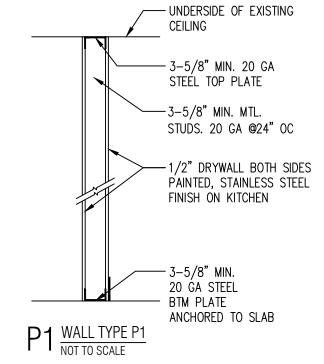

WEI TAN LICENSED ARCHITECT 2425 S WENTWORTH AVE. CHICAGO, IL 60616

PHONE: (312) 912-5798 EMAIL: twarchitect98@yahoo.com

LICENSE NO: 001-022013 EXPIRES: 11/30/2020


OWNER

RED CAJUN & SEAFOOD 410 W HIGGINS ROAD UNIT A SCHAUMBURG IL 60195 PHONE: (773)636-6888

ISSUES	DATE
ISSUED FOR PERMIT	09/28 /2019
REISSUED FOR PERMIT	10/09 /2019
REISSUED FOR PERMIT	10/30/2019
REISSUED FOR PERMIT	02/23/2020
REVISION	



FLOOR PLAN,

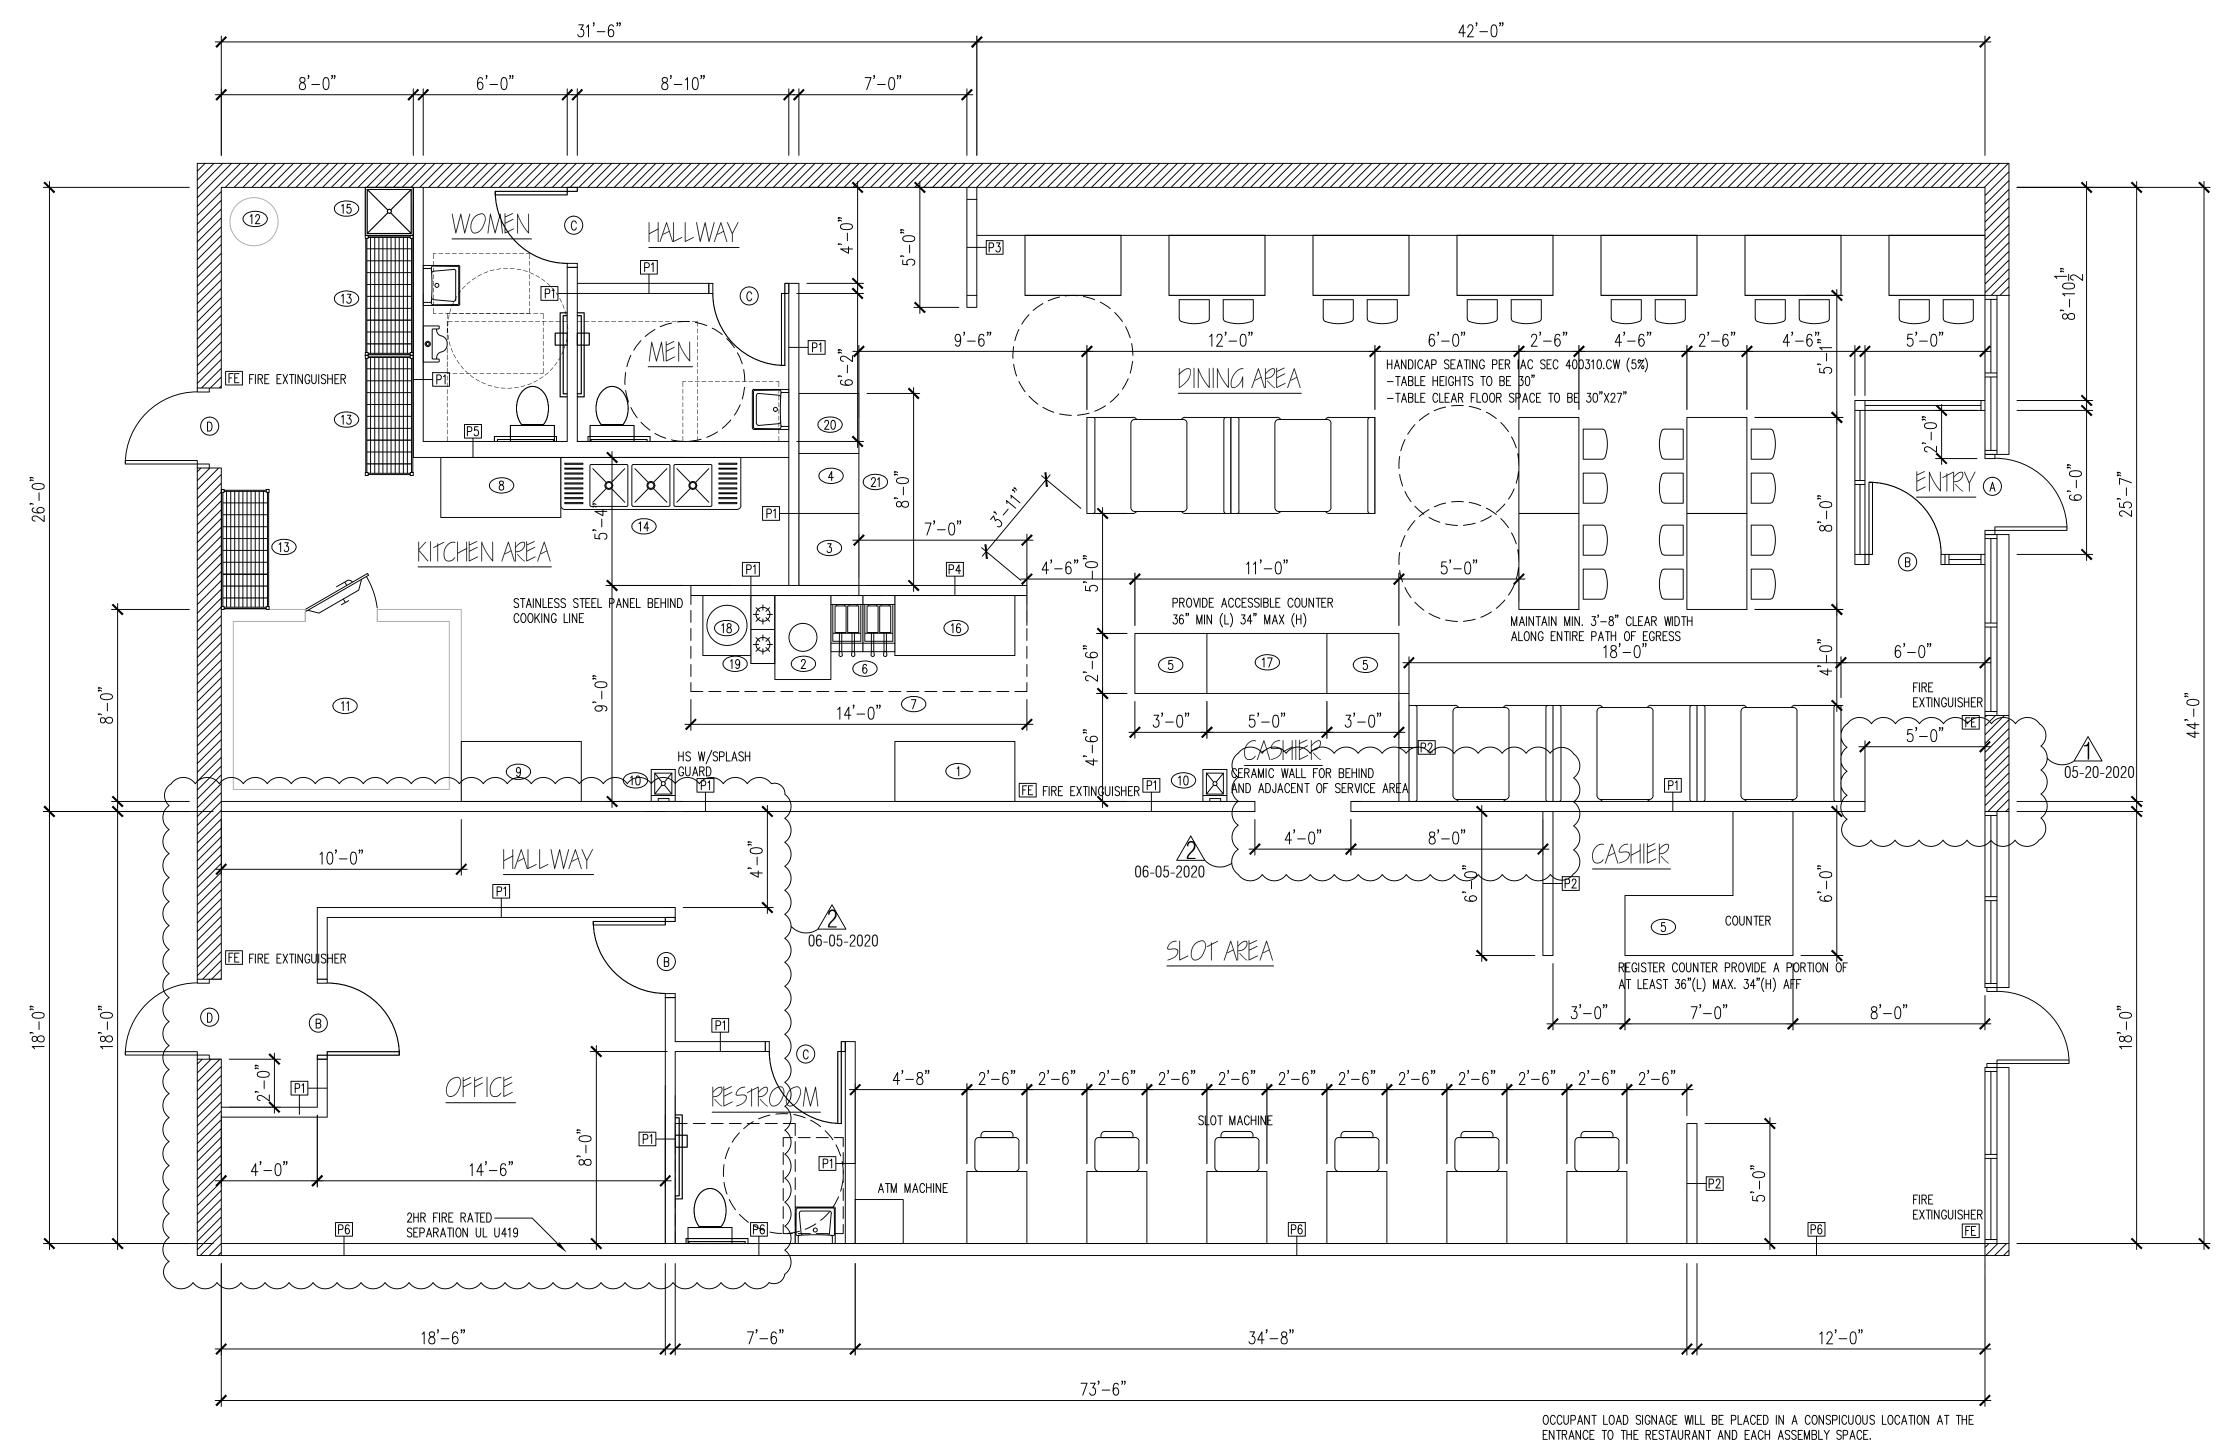

KITCHEN EQUIPMENT NOTES

CONTRACTOR SHALL INSTALL AND CONNECT ALL EQUIPMENT AS PER EQUIPMENT SUPPLIER'S SPECIFICATIONS. ALL LOCATIONS TO BE VERIFIED WITH OWNER PRIOR TO INSTALLATION.

PLUMBING CONTRACTOR SHALL PROVIDE ALL ROUGH-INS.
INSULATE ALL COLD/HOT WATER PIPES AS REQUIRED. MAINTAIN
MIN 36" IN FRONT OF ALL COOKING EQUIPMENT.

ELECTRICAL CONTRACTOR SHALL PROVIDE ALL ELECTRICAL
OUTLETS FOR EQUIPMENT. VERIFY ALL ELECTRICAL REQUIREMENTS
WITH EQUIPMENT SUPPLIER. VERIFY ALL GAS AND WATER
REQUIREMENTS WITH EQUIPMENT SUPPLIER.

ALL PERMANENT EQUIPMENT MUST BE LOCATED SO THAT AREAS BEHIND, UNDERNEATH, AND ON THE SIDES OF THE EQUIPMENT CAN BE EASILY CLEANED.

TWO DRAIN BOARDS ARE REQUIRED AT ALL THREE-COMPARTMENT SINKS ALONG WITH AN APPROPRIATELY SIZED FAUCET, LOCKABLE DRAIN PLUGS, AND AN INDIRECT CONNECTION TO THE SEWER.

DRY STORAGE

DRY STORAGE: 25% OF 434 SF (KITCHEN AREA.) = 108SF REQ'D ACTUAL DRY STORAGE 4X5'X2'X3 = 120SF PROVIDED.

ALL FOOD AND FOOD RELATED ITEMS MUST BE STORED OFF THE FLOOR ON DURABLE WASHABLE SHELVES. THE STORAGE AREA MUST BE APPROPRIATELY SIZED BASED ON THE NUMBER OF MEALS SERVED DAILY AND THE NUMBER OF DELIVERIES WEEKLY.

ALL FOOD EQUIPMENT TO BE ON CASTERS, 6" LEGS, OR SEALED TO THE FLOOR FOR EASY CLEANING.

NO RAW WOOD SURFACES PERMITTED ANYWHERE. UNDERSIDES OF COUNTERTOPS, INSIDE OF CABINETRY, AND WATER HEATER PLATFORMS MUST BE SEALED.

	HARDWARE SCHEDULE									
TAG	DESCRIPTION									
1	1 1/2 PAIR BUTT HINGES, W/LEVERED PRIVACY LOCKSET, KICKPLATE AND DOOR CLOSER									
2	1 1/2 PAIR BUTT HINGES, PADDLE LATCH EXIT DEVICE AND DOOR CLOSER, PANIC HARDWARE									
3	1 1/2 PAIR BUTT HINGES W/ PRIVACY LOCKSET									

2425 S WENTWORTH AVE. CHICAGO IL 60616

PHONE: (312) 912-5798 EMAIL: twarchitect98@yahoo.com

LICENSE NO: 001-022013 EXPIRES: 11/30/2020

MEP ENGINEER 236 W ALEXANDER STREET CHICAGO IL 60616

PHONE: (312)720-8800
BILLY\_WANG68@HOTMAIL.COM
LICENSE NO: 062.068227
EXPIRES: 11 / 30 /2021

HIBACHI MADNESS INTERIOR REMODELING 4314 & 4318 WABASH AVE. SPRINGFIELD IL 62711

ISSUES DATE
ISSUED FOR PERMIT 04/20 /2020
REISSUED FOR PERMIT 05/20 /2020
REISSUED FOR PERMIT 06/05 /2020



FLOOR PLAN & NOTES

SHEET NUMBER

A2

A FLOOR PLAN

NEW WALL 

EXIST'G WALL

THE EXIT DOORS ARE EQUIPPED WITH PANIC HARDWARE.IBC 1008. 1. 9

EMERGENCY AND GENERAL EGRESS DISCHARGE LIGHTING. IBC 1006.1 ON SHEET E1